




0-54-AA

MARION TWP.

R. 22 TWP. 4

SCALE 1"=100'  
TAXING DISTRICT  
COLUMBUS

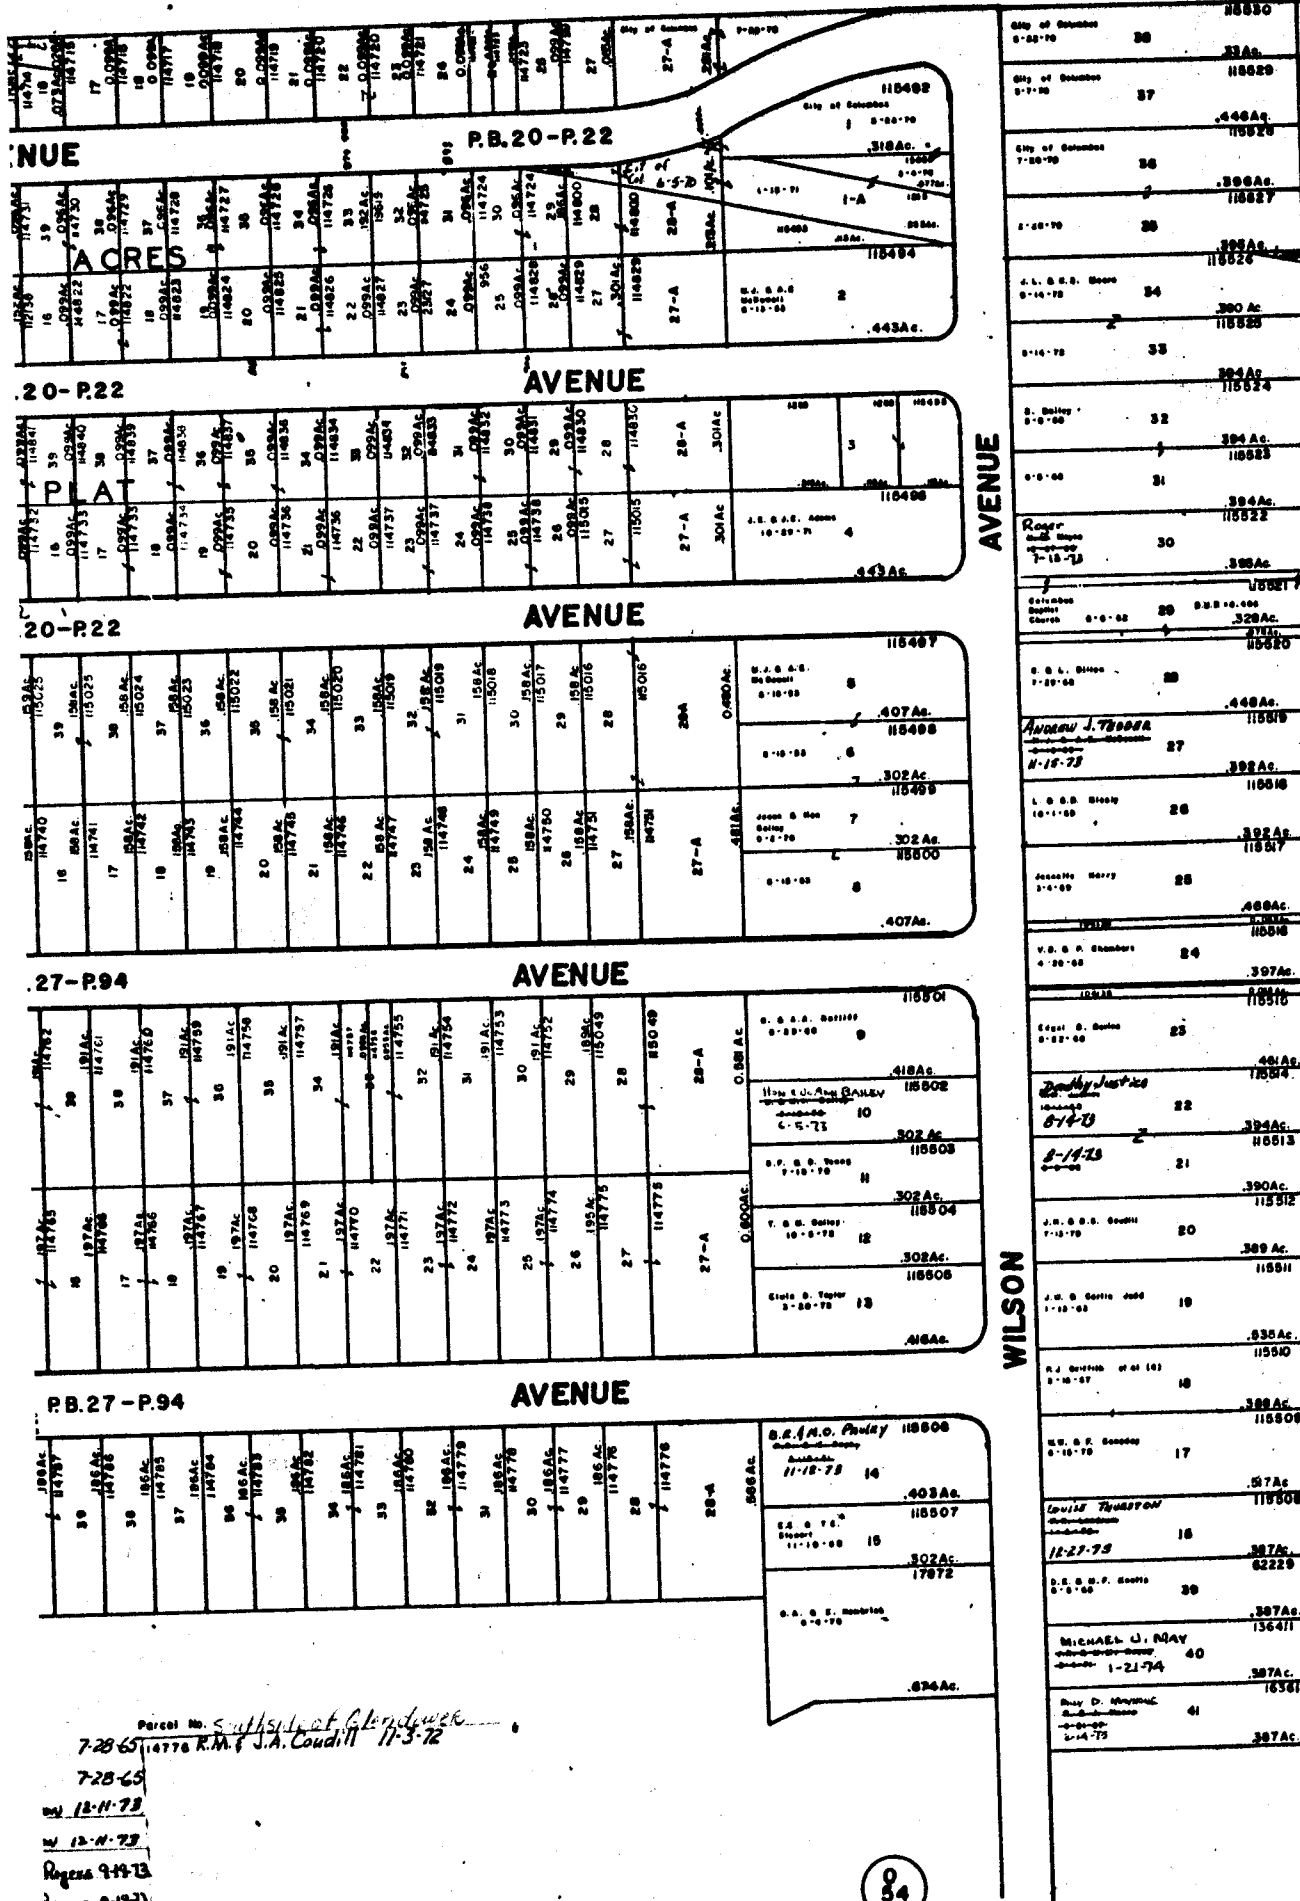

- 7-28-65 11776 R.M. & J.A. Coudill 17-3-72
- 7-28-65
- 12-11-73
- 12-11-73
- Regina 9-13-73
- Regina 9-13-73

34

3498
