

B L E

The White Cross Hospital Assoc.
9-9-65

The White Cross Hospital Assoc.
7-31-68

VALRICH FARMS
Walter F. Neer
~~6-22-43~~
6-8-73

PARCEL 1


PARCEL 2

PARCEL 3

PARCEL 4

PARCEL 5

Burwell - Dill Inc.
3-1-73

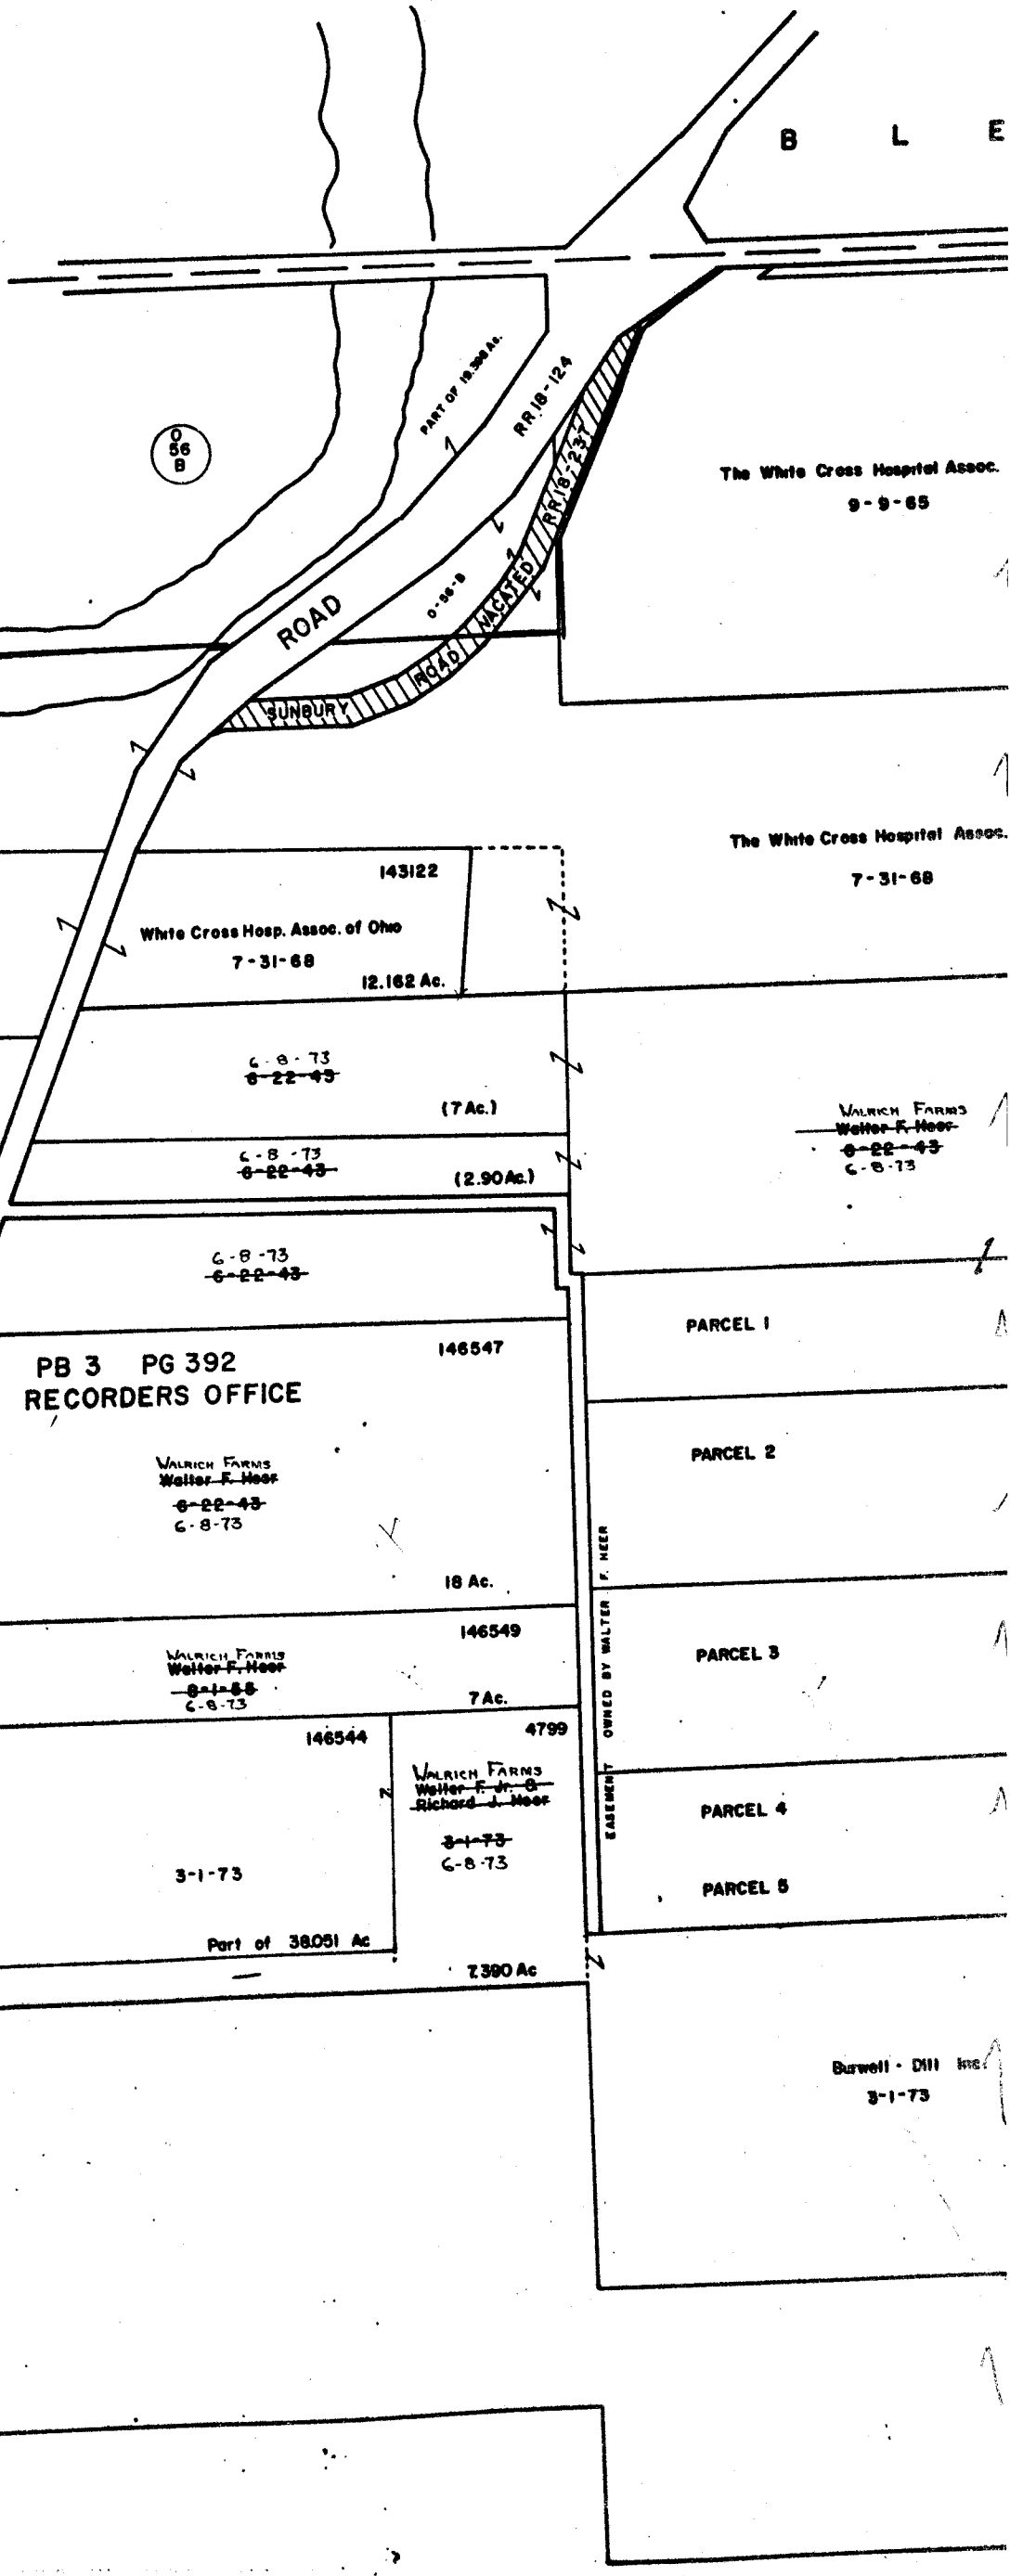

CREEK

ROAD

SUNBURY

ALUM

SUNBURY

0 56 B

0 56 B

7-31-68

7-31-68

~~6-8-73~~
~~6-22-43~~

~~6-8-73~~
~~6-22-43~~

~~6-8-73~~
~~6-22-43~~

PB 3 PG 392
RECORDERS OFFICE

VALRICH FARMS
Walter F. Neer
~~6-22-43~~
6-8-73

VALRICH FARMS
Walter F. Neer
~~6-1-68~~
6-8-73

VALRICH FARMS
Walter F. Neer
Richard J. Neer
3-1-73
6-8-73

3-1-73

Part of 38,051 Ac

7,390 Ac

143122

12.162 Ac.

(7 Ac.)

(2.90 Ac.)

18 Ac.

146549

7 Ac.

146544

4799

7,390 Ac

