

See 0-57-C

0-57-E

Merlyn H. Herbst  
8-28-70

3Ac.

RESUBDIVISION

ACADEMY

N-52-B

N-52-

CREEK

CLIFF

NOB HILL WEST SIDE  
NOB HILL DR. WEST COURT  
NOB HILL DR. NORTH

ROAD

CHERRY  
BOTTOM

Planned Community Inc.  
Russell Shutt  
8-8-52  
12-20-75

0-2-1917

30Ac.

0-2-1909

0-2-24

0-2-1915

0-2-1919

2-17-70

Frederick Sindel  
2-17-70

19Ac.

22.89Ac.

BIG

0-57-D

0-57-F

44  
57-E


0-57-F

MIFFLIN TWP  
R.17 TWP.1



SCALE 1"=200'  
TAXING DISTRICTS  
CITY OF GAHANNA

0  
57  
C

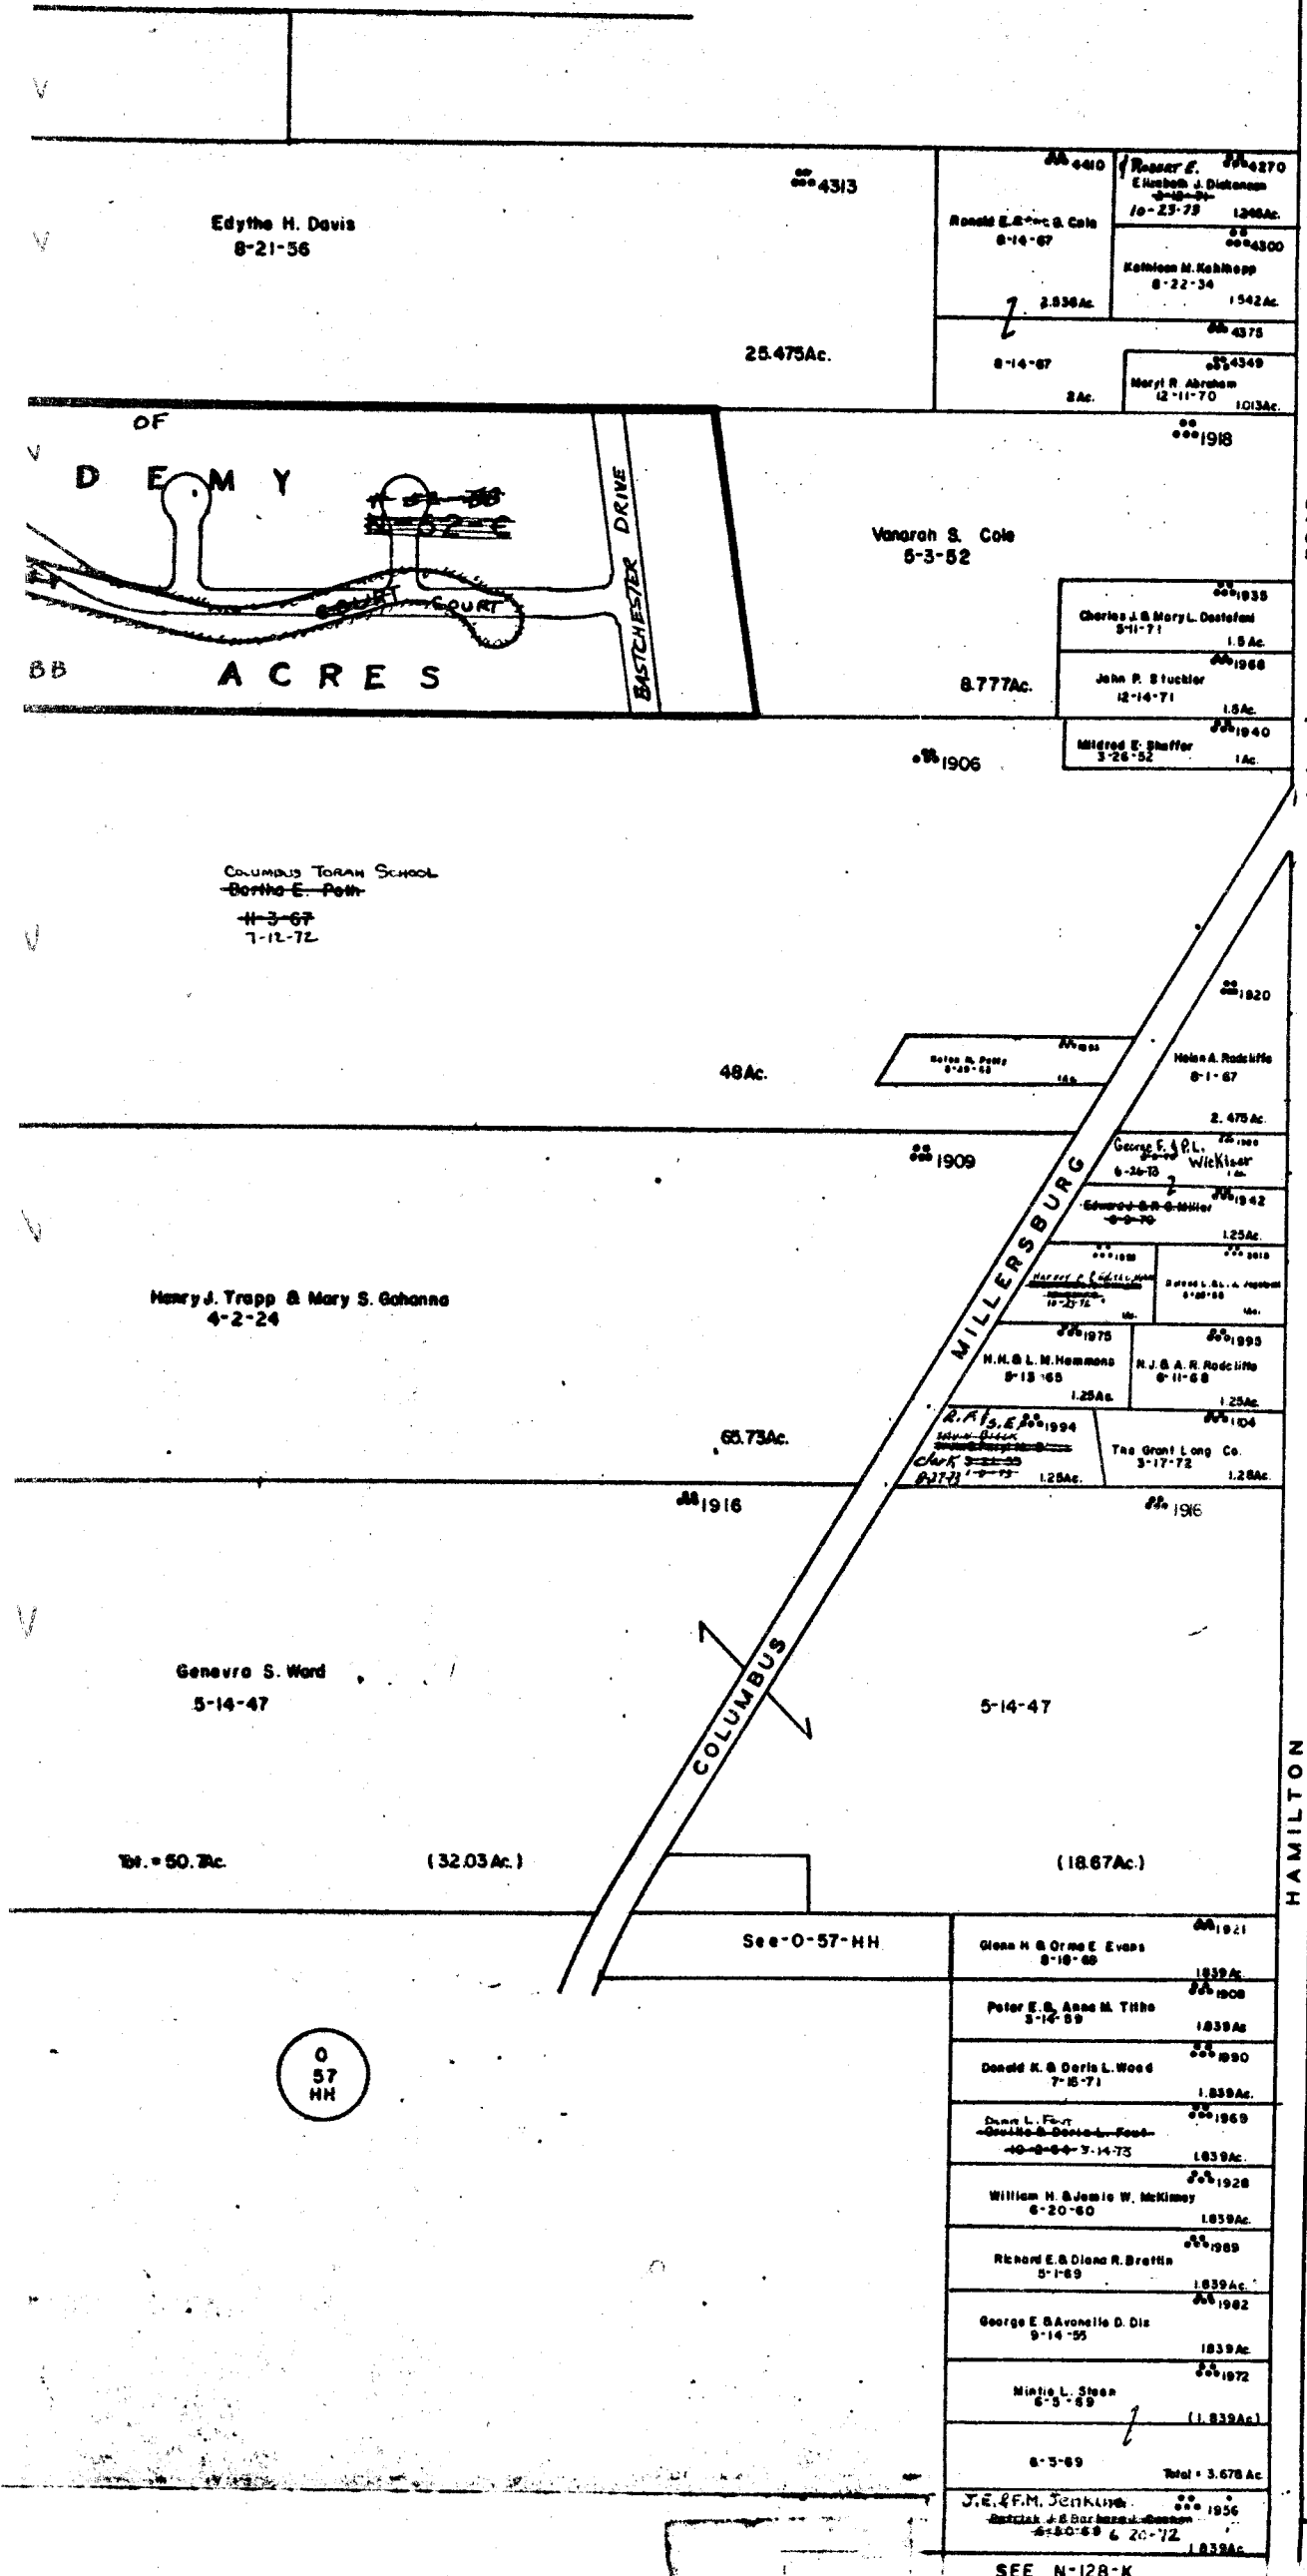

0  
57

0  
57  
HH

0-57-F

3546

SEE N-128-K