


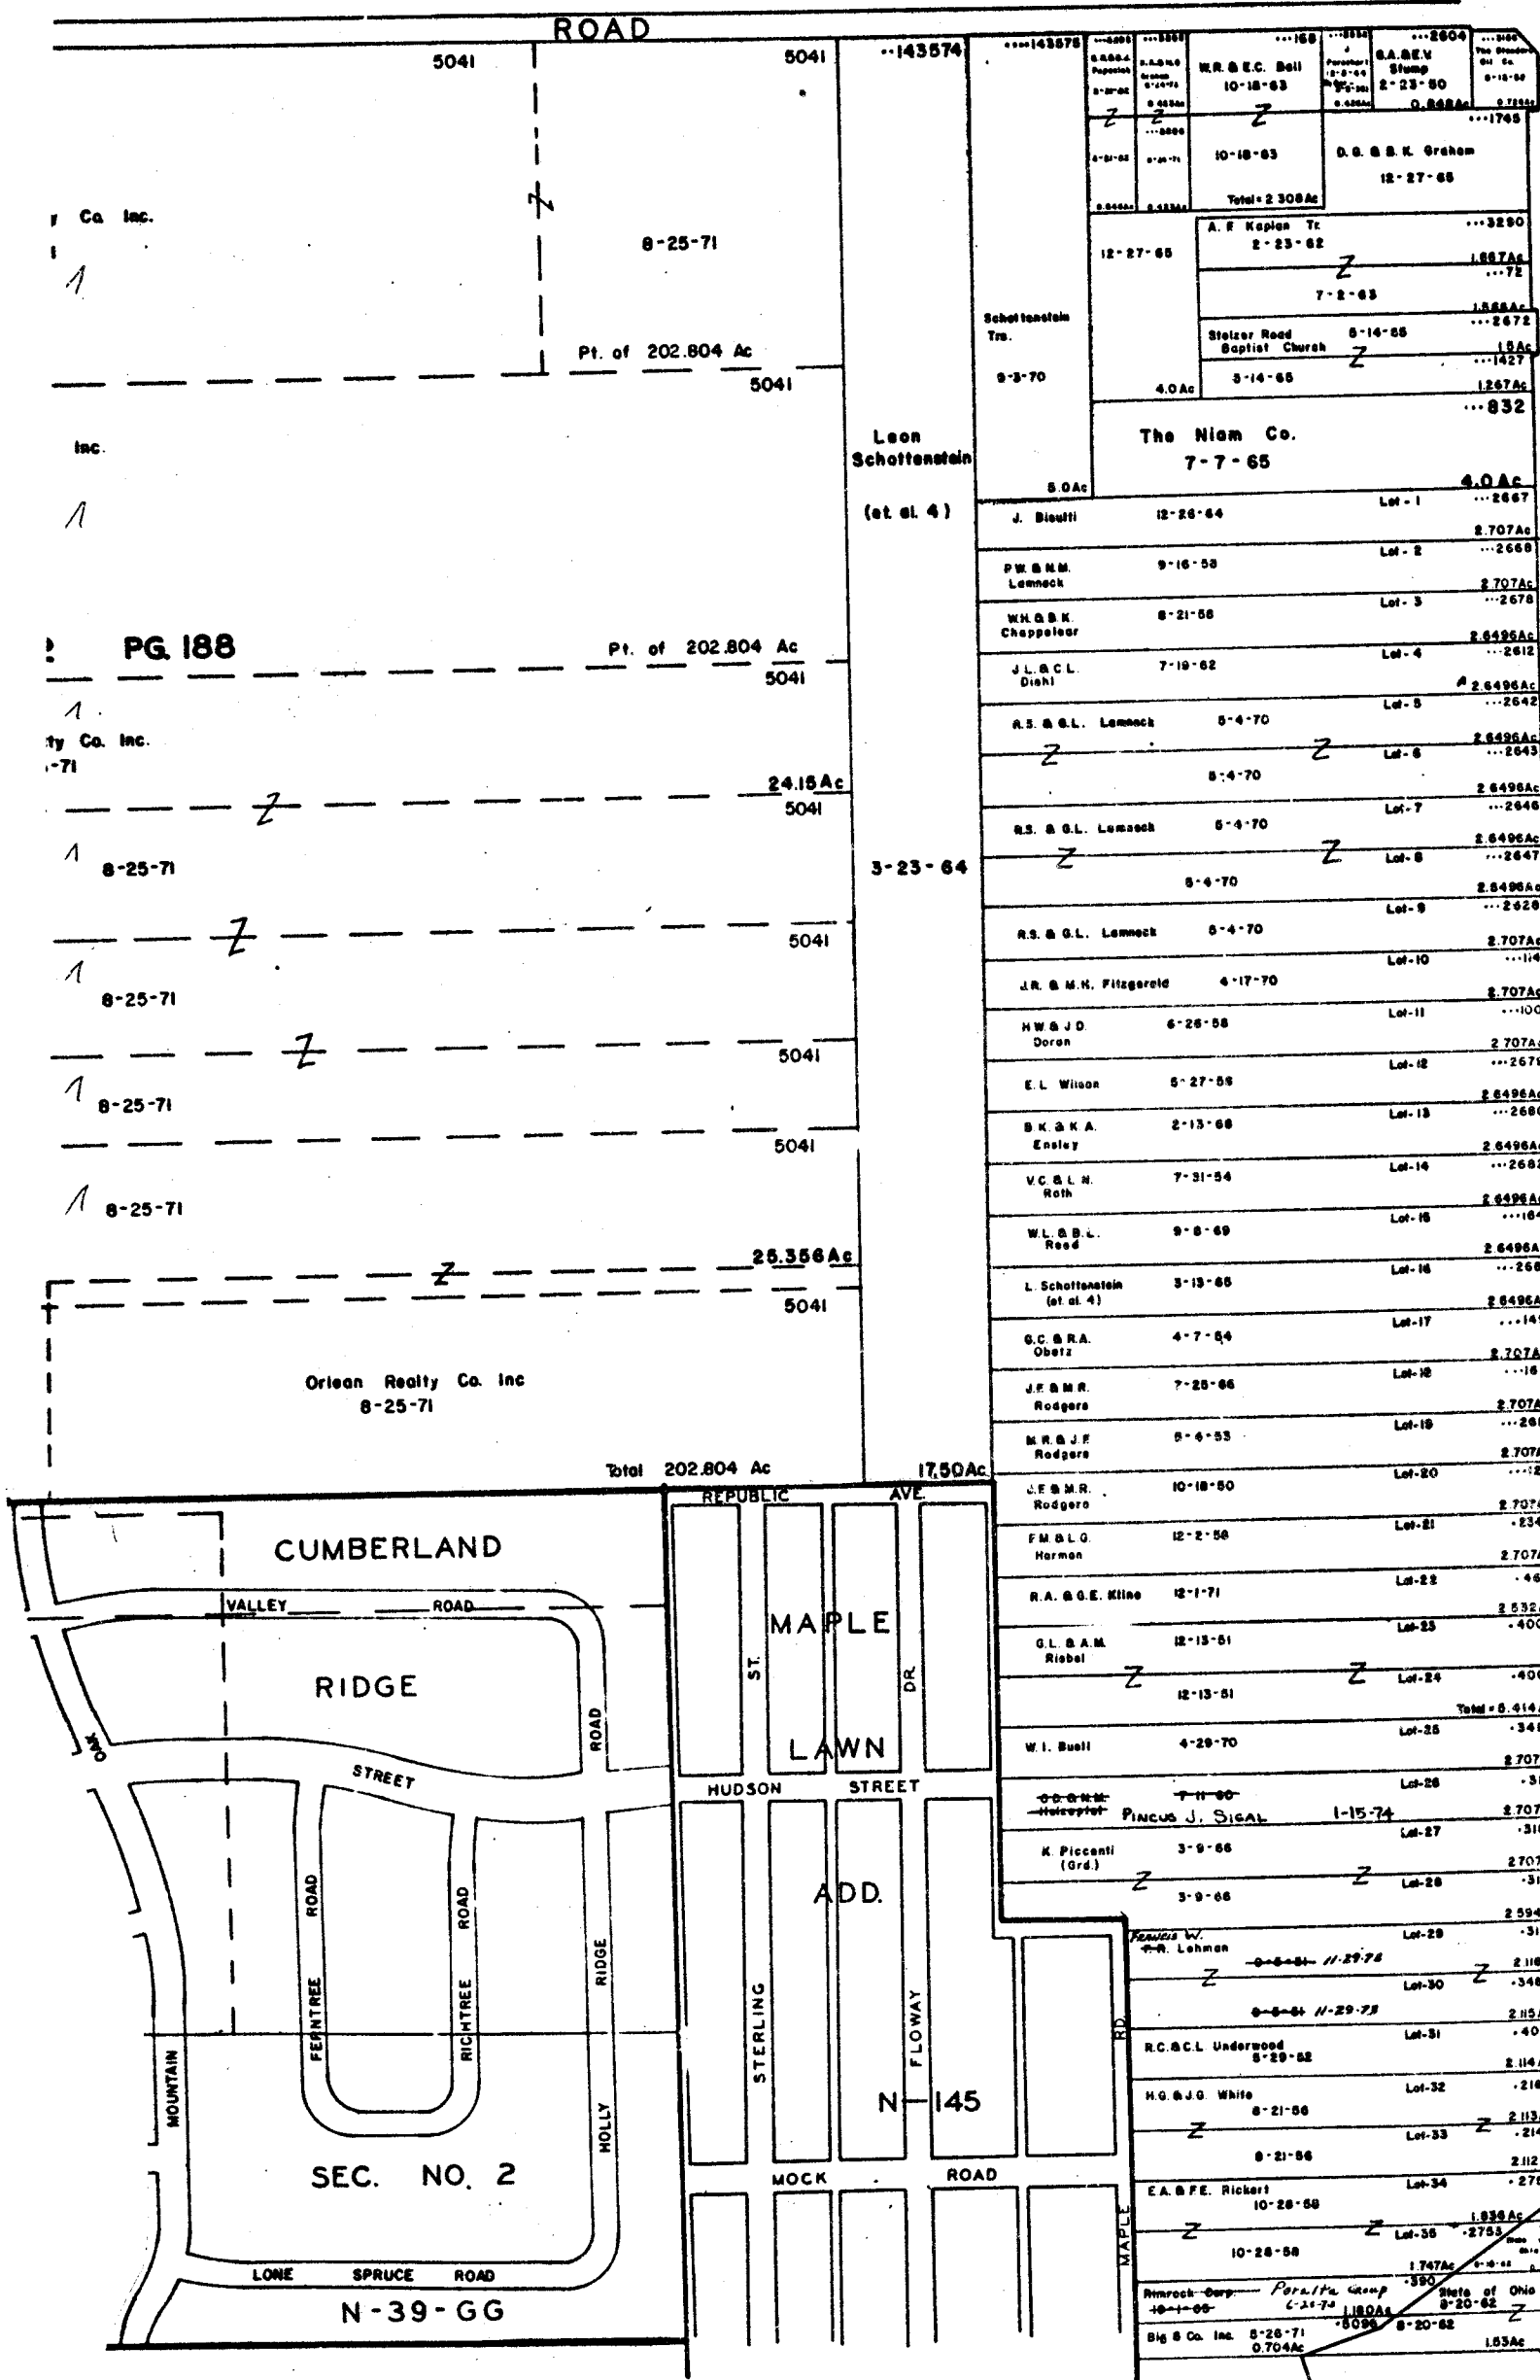

COLUMBUS-MIFFLIN  
MIFFLIN-JEFFERSON S.  
COLS-JEFFERSON S.



ARMUTH AVE.  
 ABERDEEN AVE.  
 MINNESOTA AVE.  
 GENNESEE AVE.  
 FARL AVE.  
 EMMONS AVE.  
 MISSOURI AVE.  
 GEORGIA AVE.

STELTZER

58