


R
W
T
N
W
O
R
E

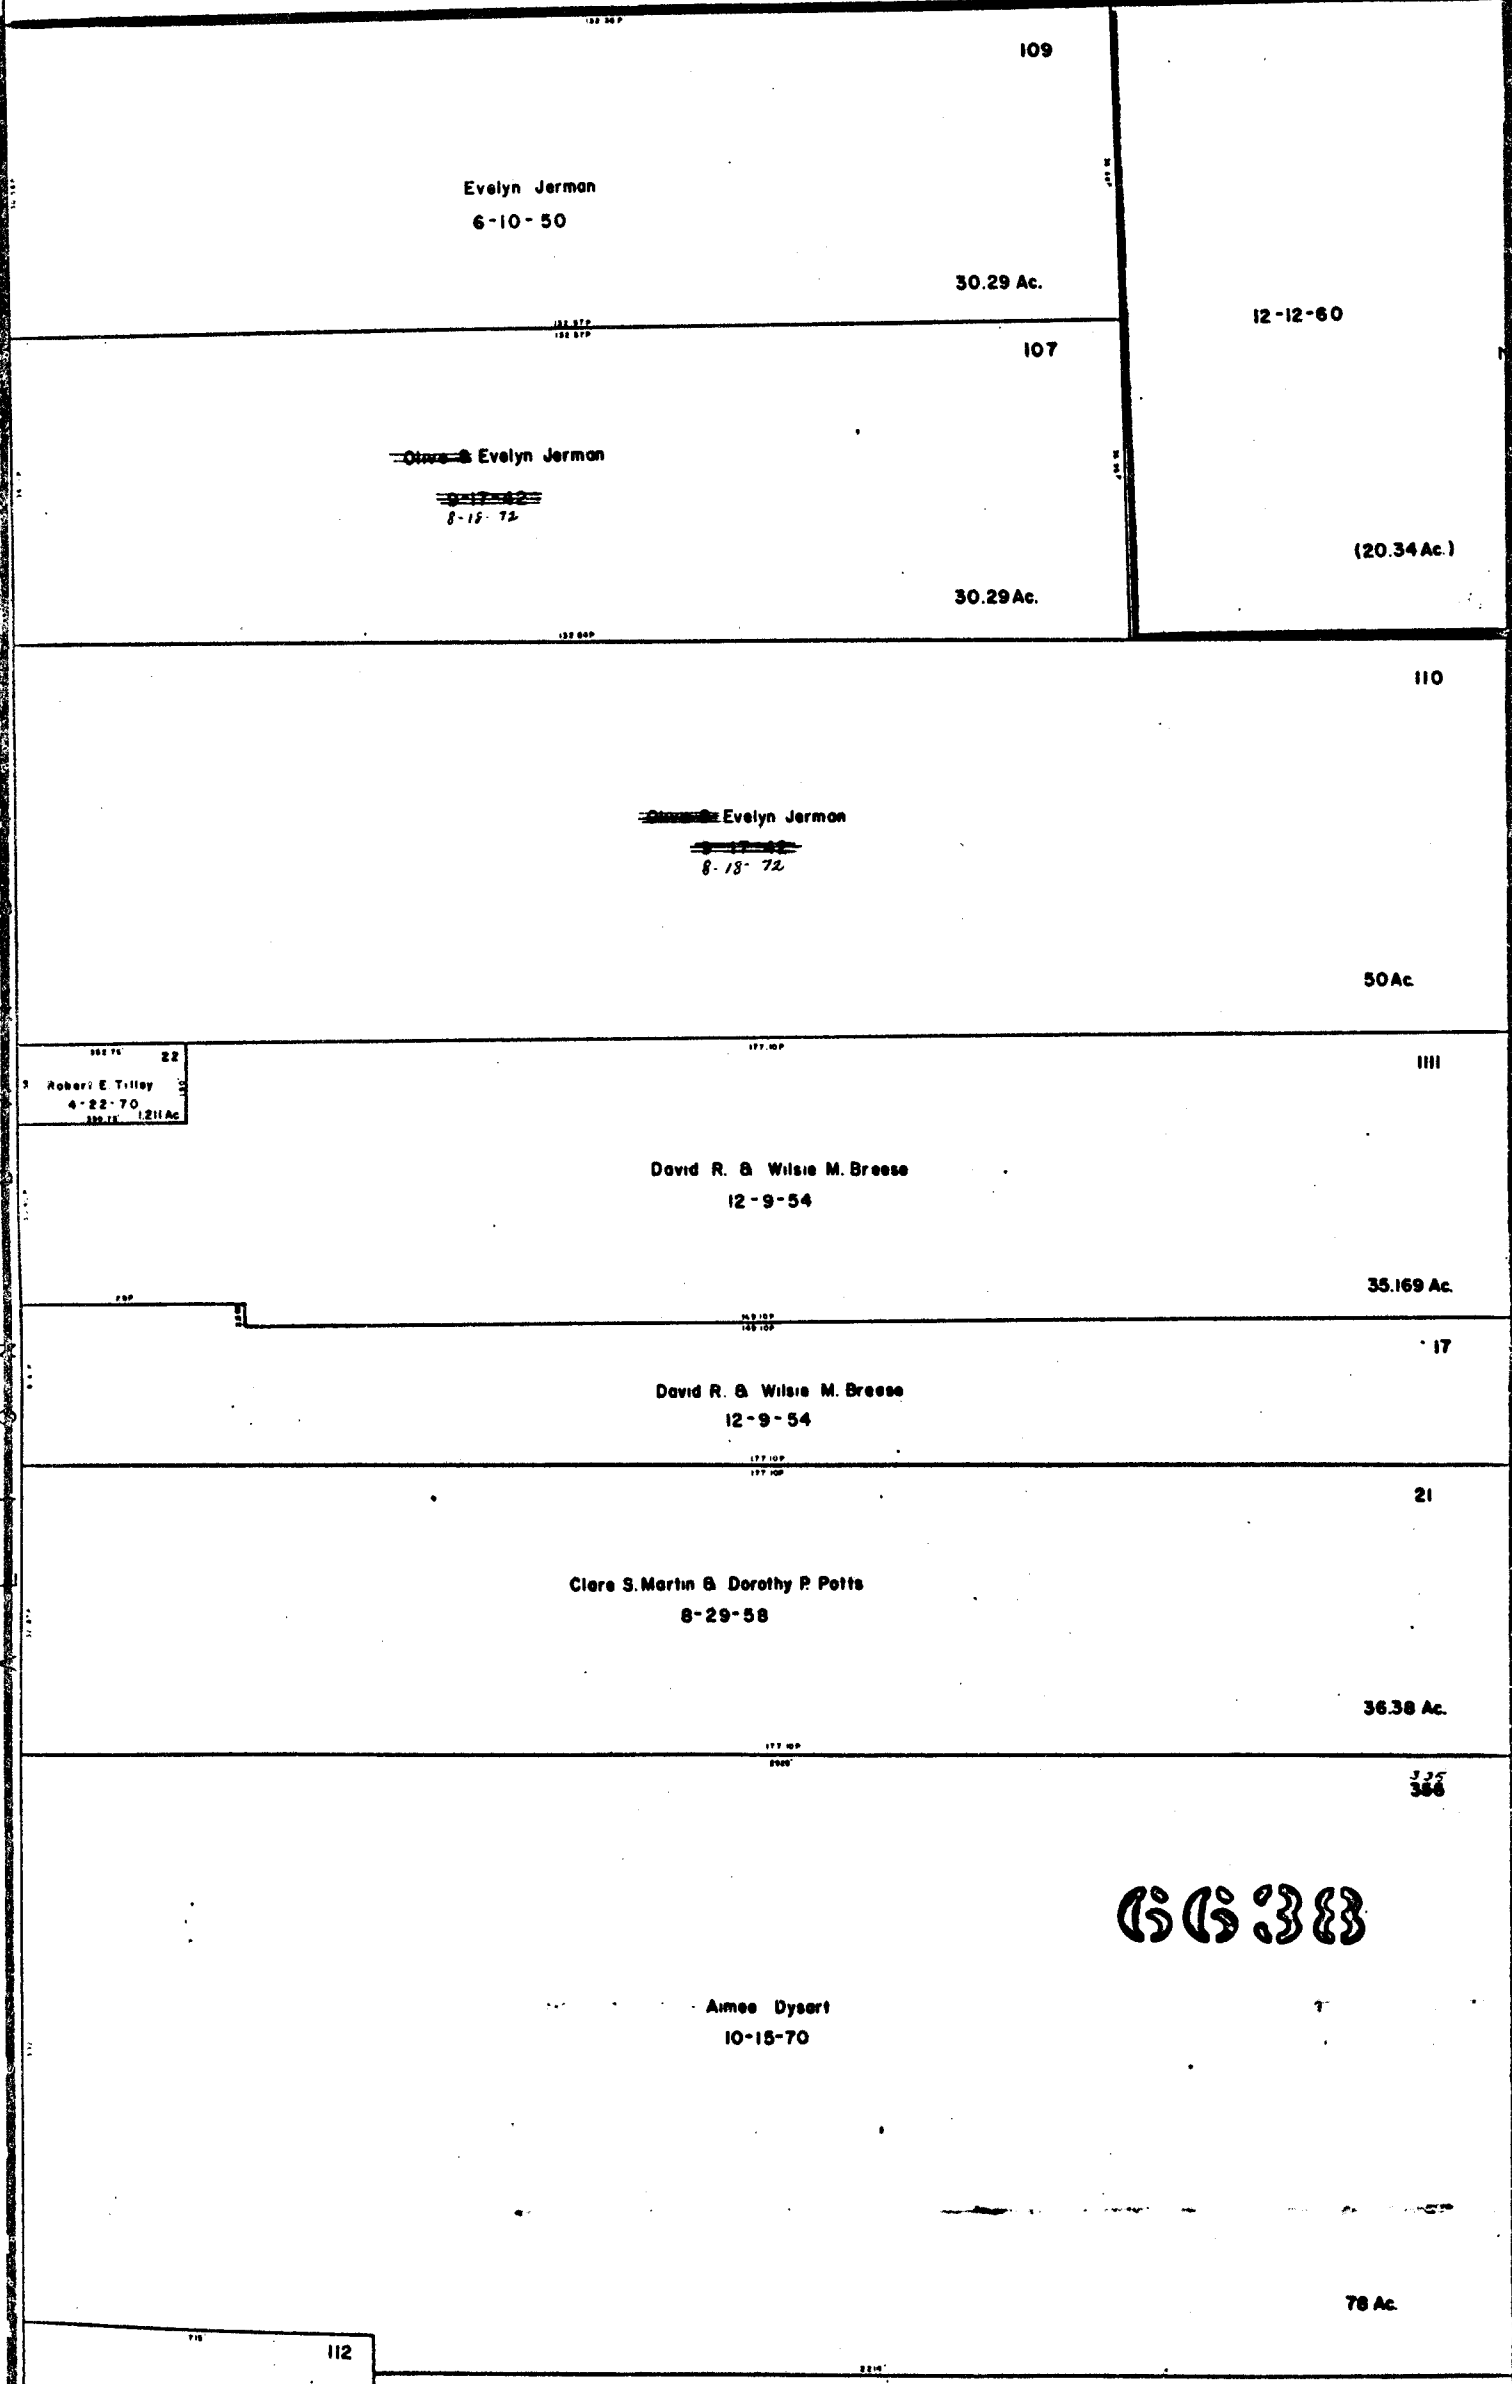

22
Robert E. Tilley
4-22-70
1.211 Ac.

112
James H. Sturdevant
Nancy W. G. A. L. Hou
11-13-41
5 Ac.

0
62
C

6638

✓

✓

✓

3


✓

(


O-62-A
NORWICH TWP.

0
60

SCALE 1"=200'
VMS
TAXING DISTRICTS
NORWICH TWP.
• CITY OF HILLIARD

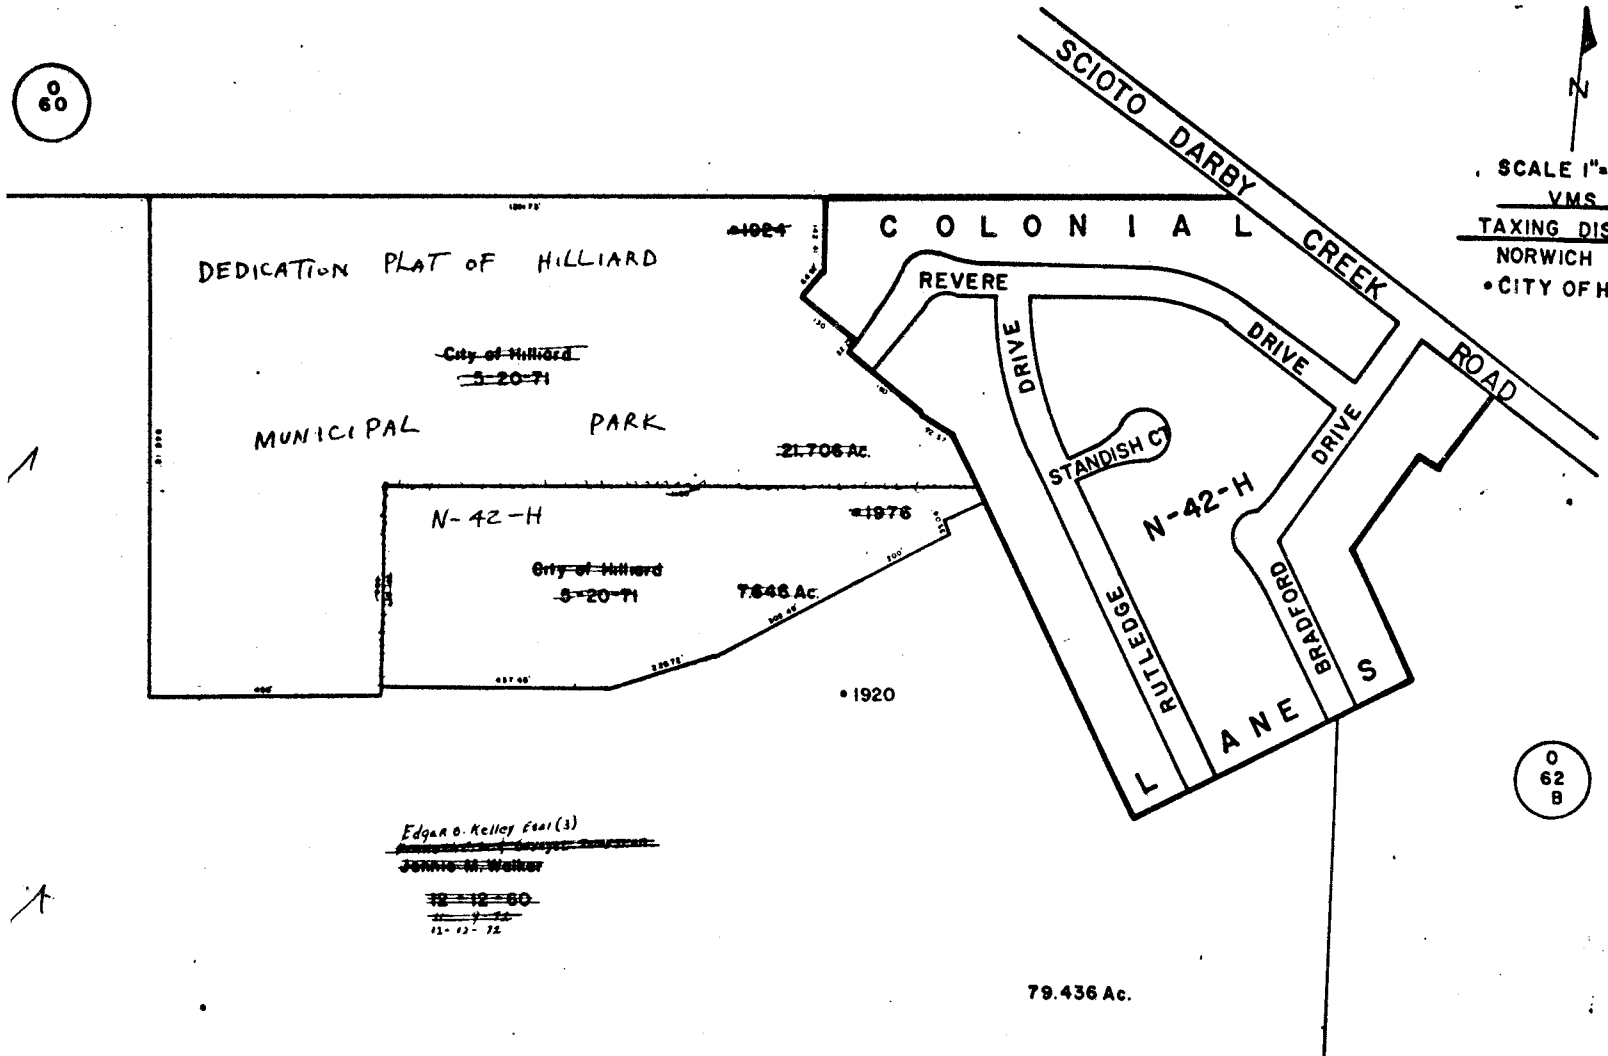

0
62
B

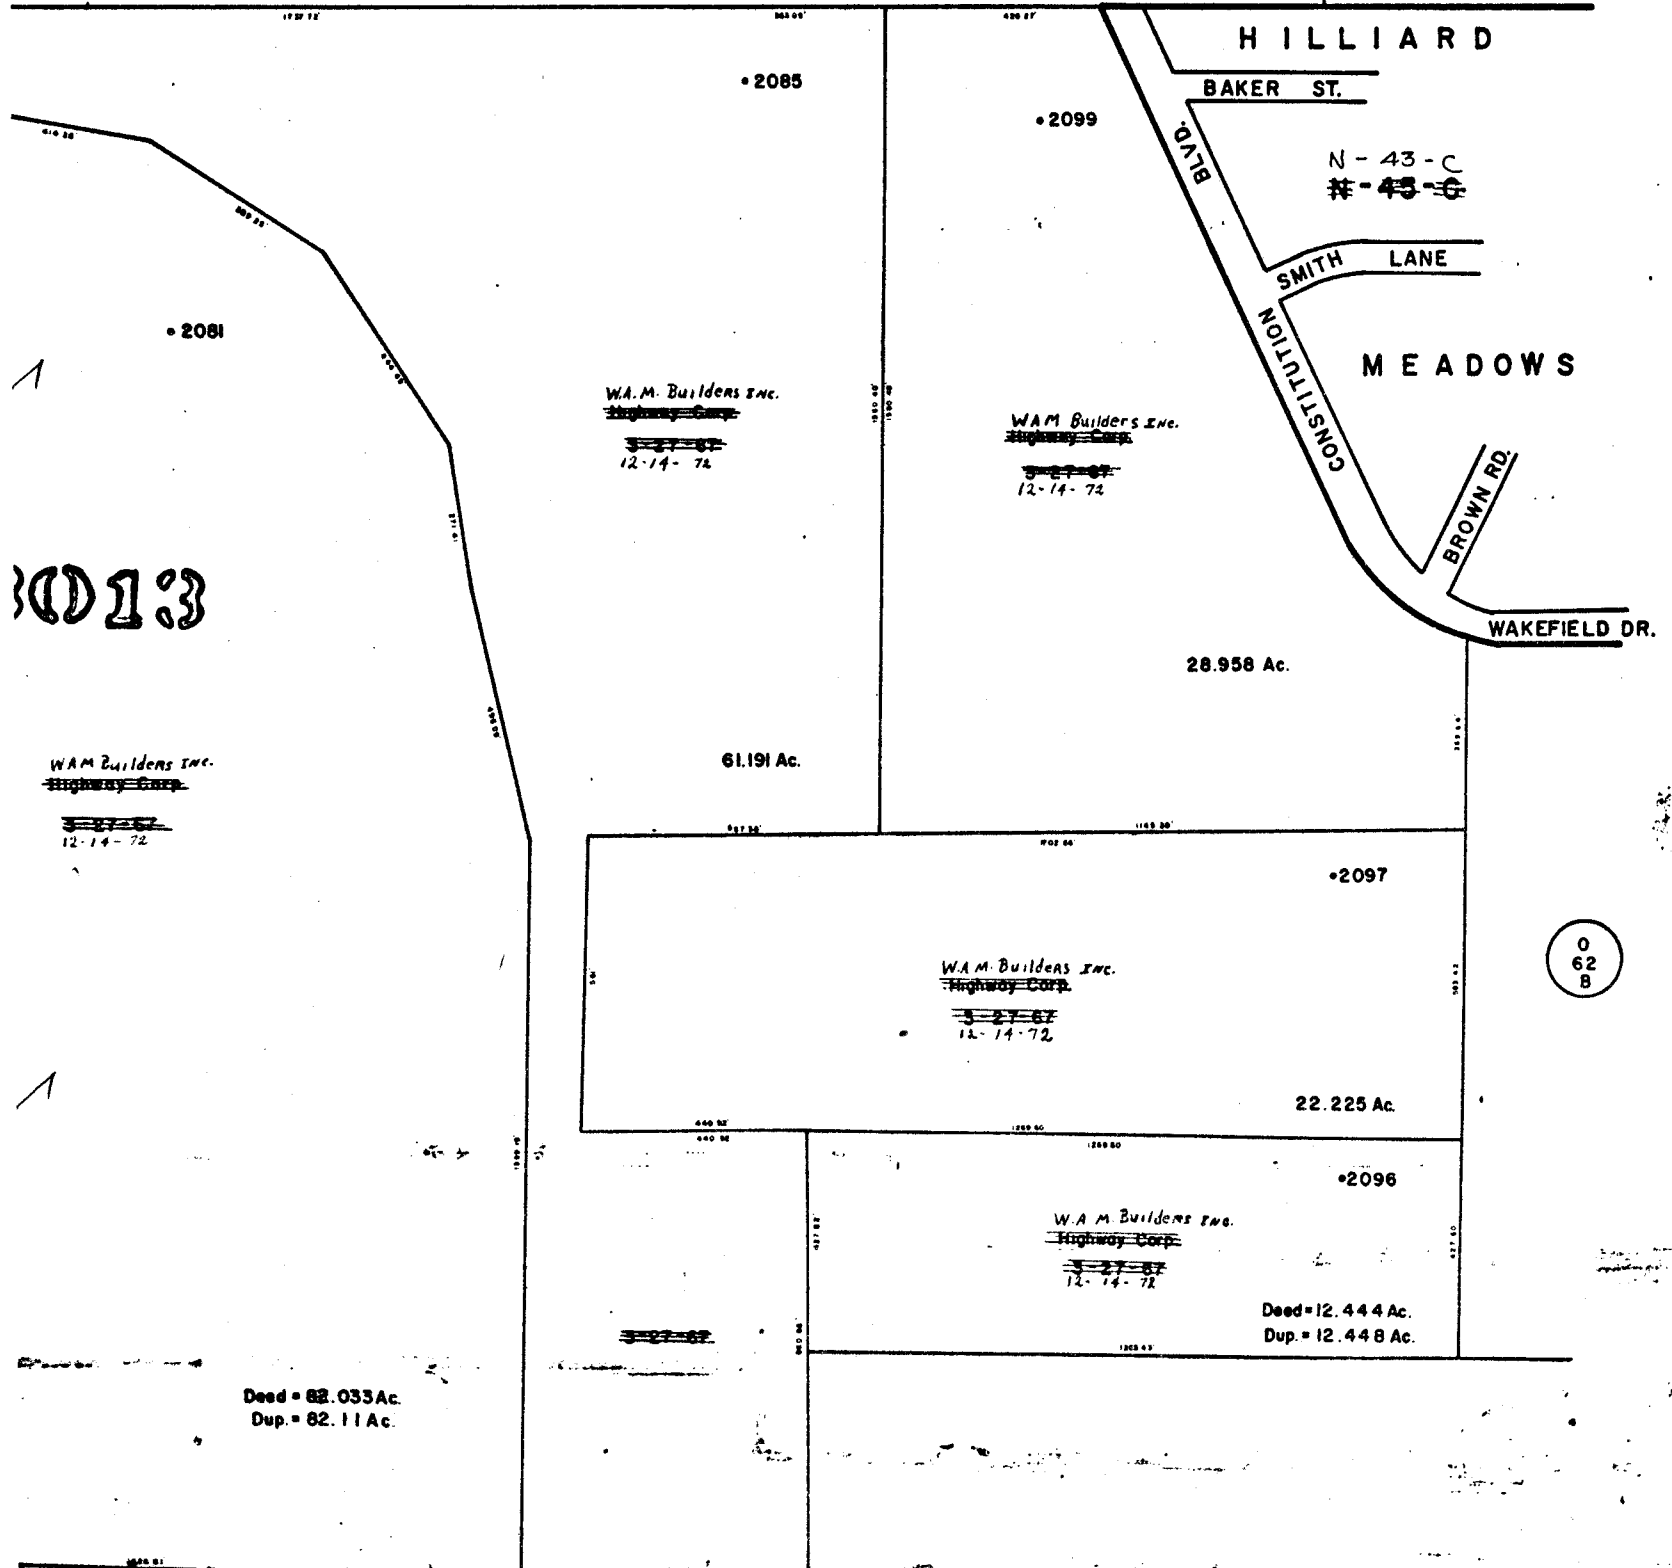

0
62
B

0
62
D