

0
62
A

221

55383

Paul D. Strider
9-22-64

(69.31 Ac)


0
10

TOWNSHIP

55383

BROWN

0
10

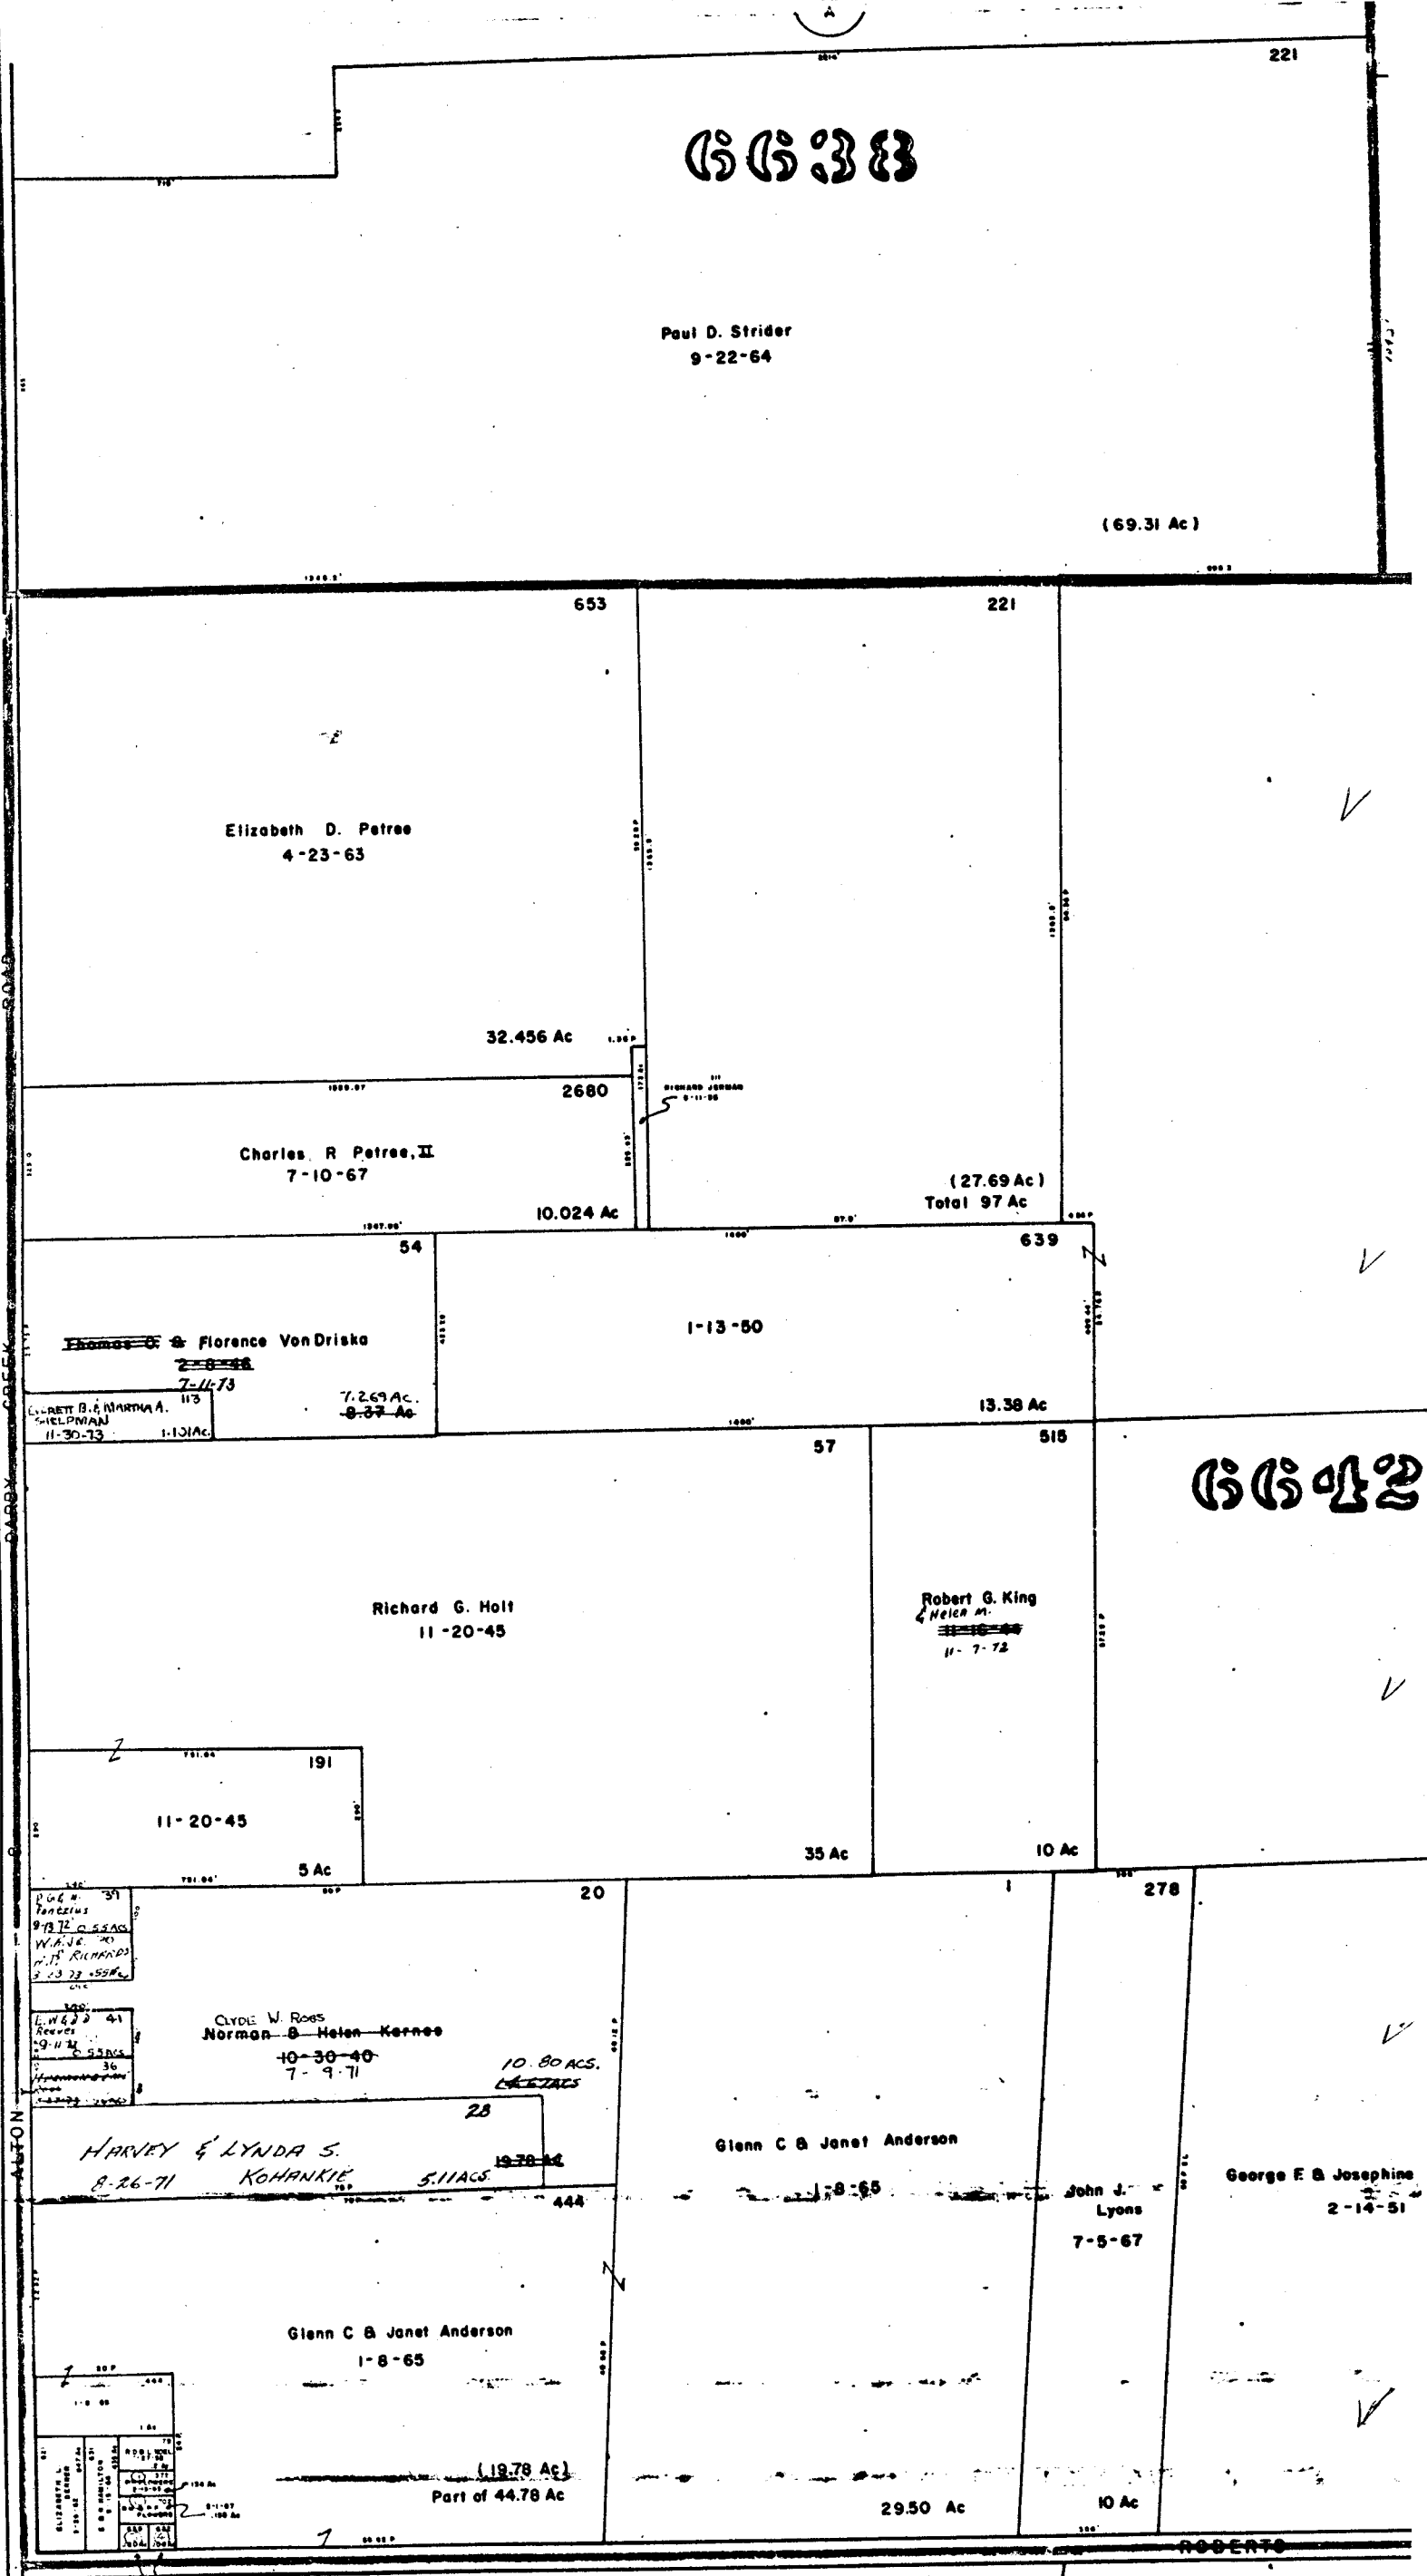

3629

0
64

55382

O-62-C
NORWICH TWP



SCALE 1"=200'

V. M. S.
TAXING DISTRICT
NORWICH TWP

Parcel No. 34

3013

Raymond H. King
11-10-52

0
62
D

Part of 92.257 Ac.

- ① 372 C.E.M. TUCKER 5-4-73 0.134 Ac.
- ② 702 C.L.M. TUCKER 5-4-73 0.158 Ac.
- ③ 633 C.E.M. TUCKER 5-4-73 0.120 Ac.
- ④ 632 C.E.M. TUCKER 5-4-73 0.106 Ac.

Robert G & Helen M. King
11-10-52

0
62
D

103 Ac

120

2017

Robert G. King
& Helen M.
11-7-72

50 Ac

567

Eugene G. & Ada Bohlen
12-20-44

0
62
D

141

46

Eugene & Ada A. Bohlen
12-9-68

L. Francis

12-9-68

25 Ac

177

Eugene & Helen L. Eiben
1-5-61

30 Ac

Part of 88.487 Ac)

15 Ac

O-62-C

3630

0
64