

3013

O
62
A

3757
OWNER'S NAME
APR-31-57
COUNTY

Balance of Parcel 34

219

Manuel & William Tzagouris
9-7-66

40. Ac.

O
62
C

188












3632

178

2017

O
62
C

Eugene G. & Ada A. Bohlen
4-11-46

41.5 Ac

ROBERTS

O
64

3632


0-62-D
NORWICH TWP.



SCALE 1"=200'
V.M.S.
TAXING DISTRICTS
NORWICH
COLUMBUS - SHERIDAN S.D.

0
62
E

13335

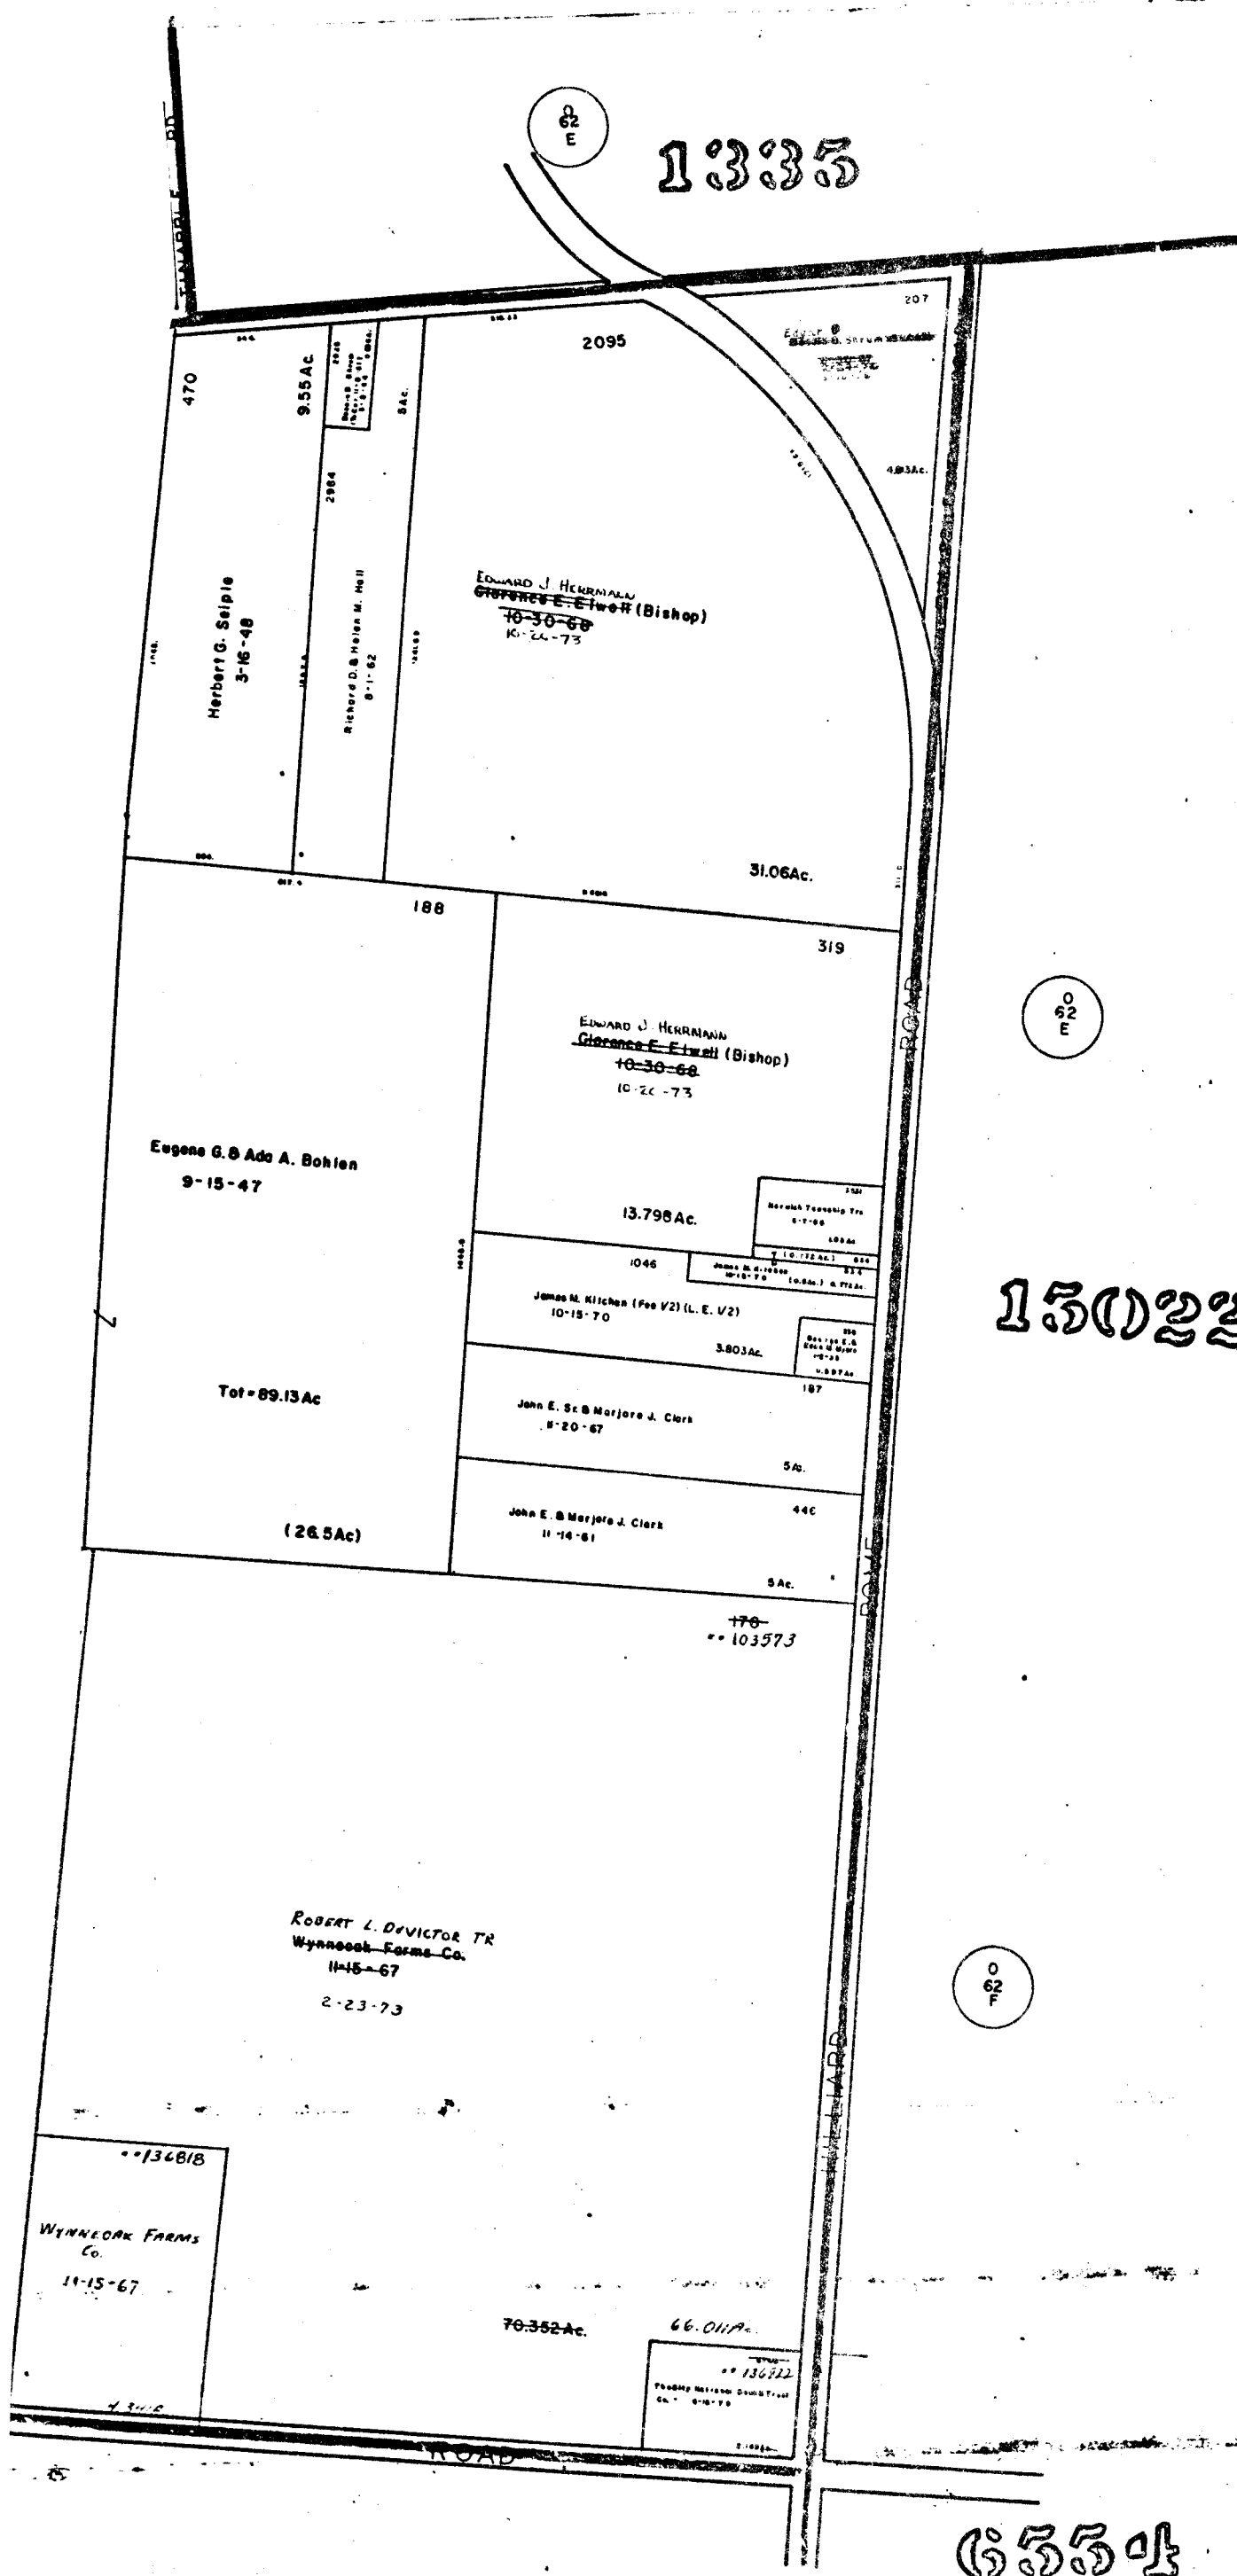

0
62
E

15022

0
62
F

0-62-D

6554

3632