


30426

O-62-F
NORWICH TWP

SCALE 1" = 200'
V.M.S.
TAXING DISTRICTS
NORWICH
COLS. SCIOTO DARBY S.D.

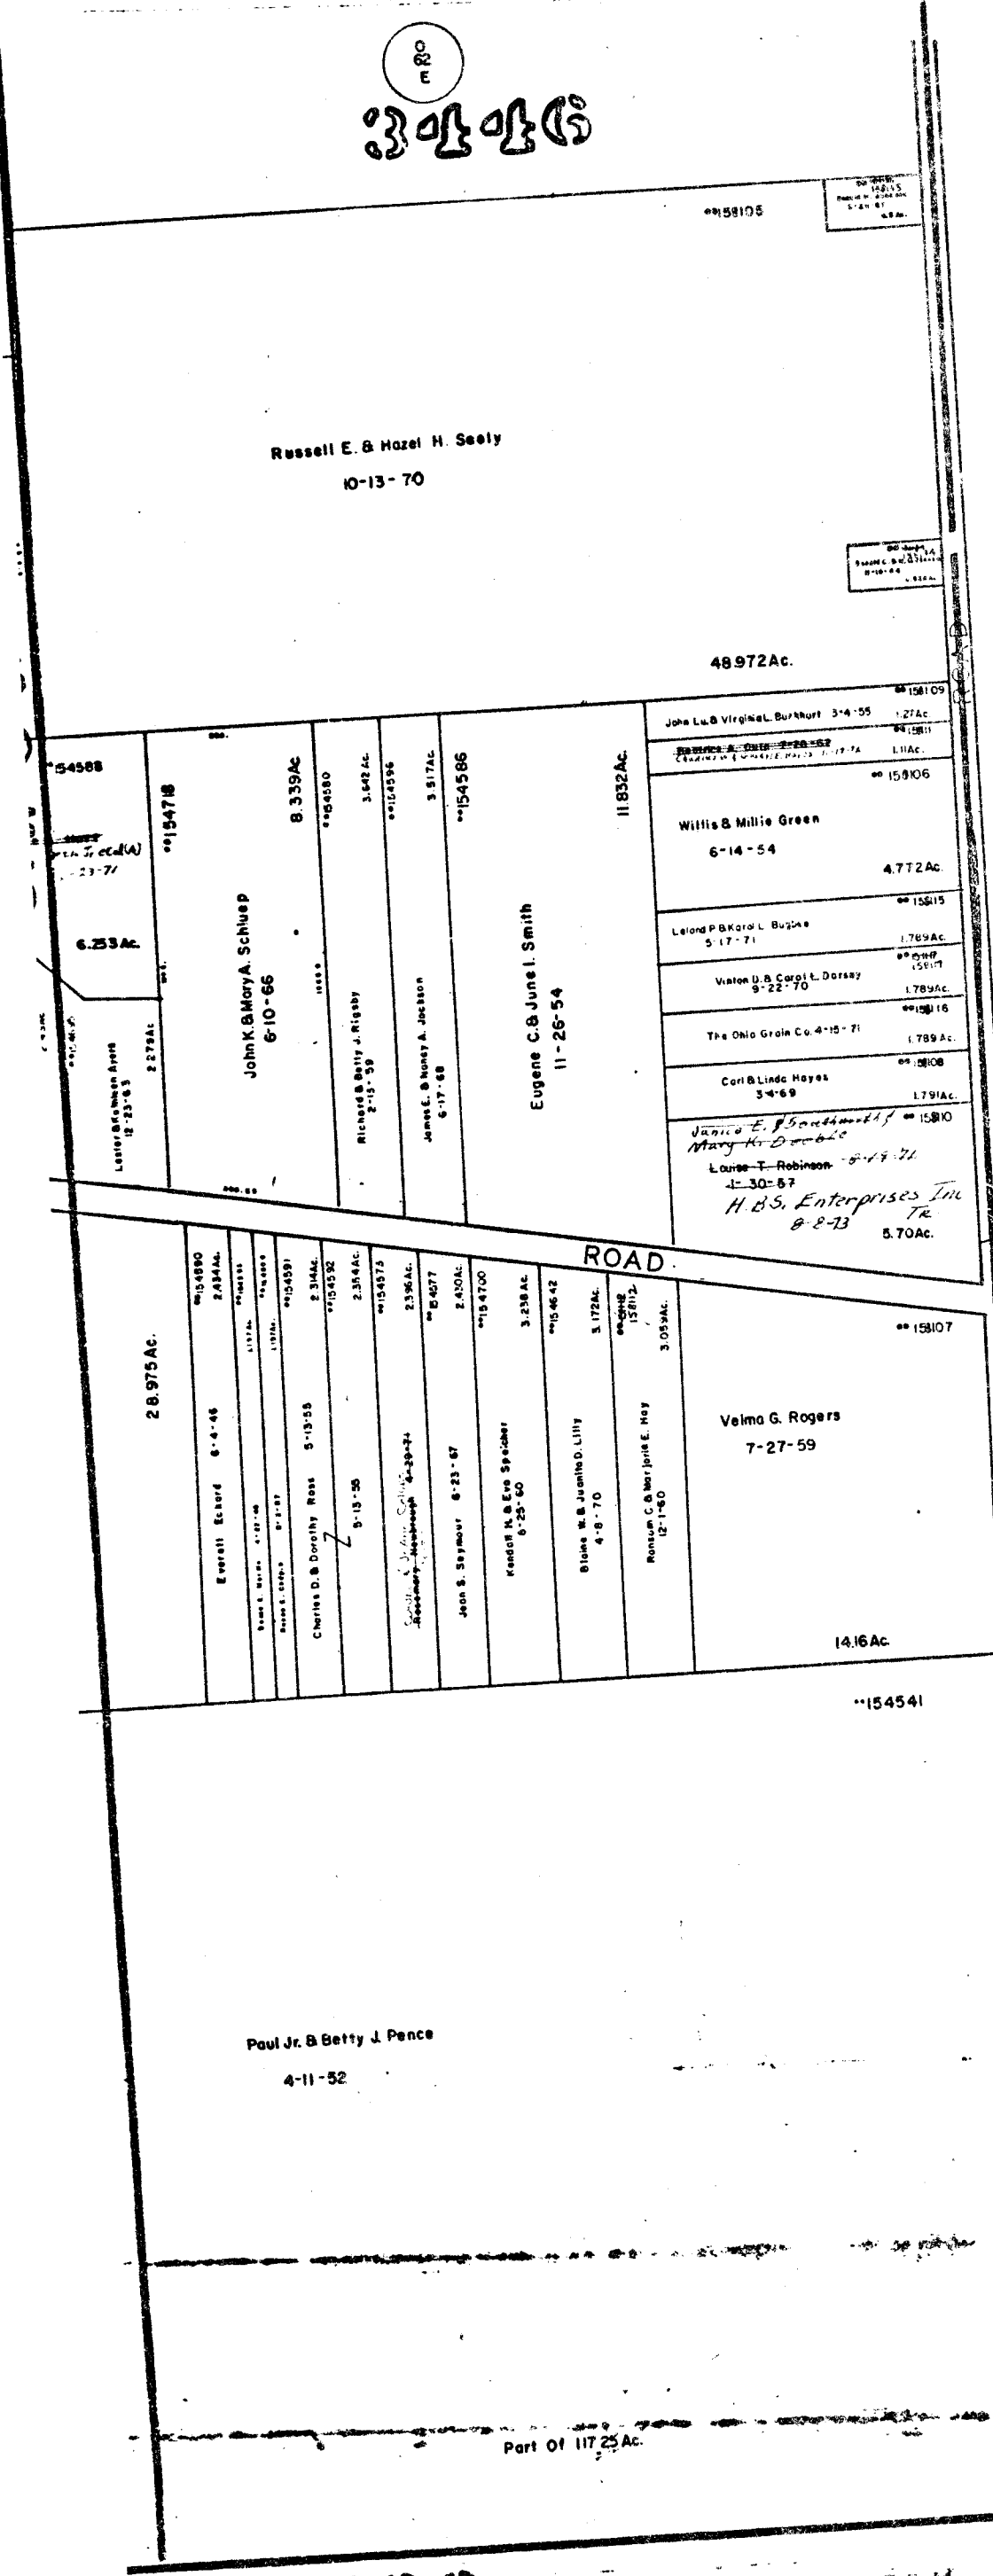

280

65

287

O-62-F

3636

30426