


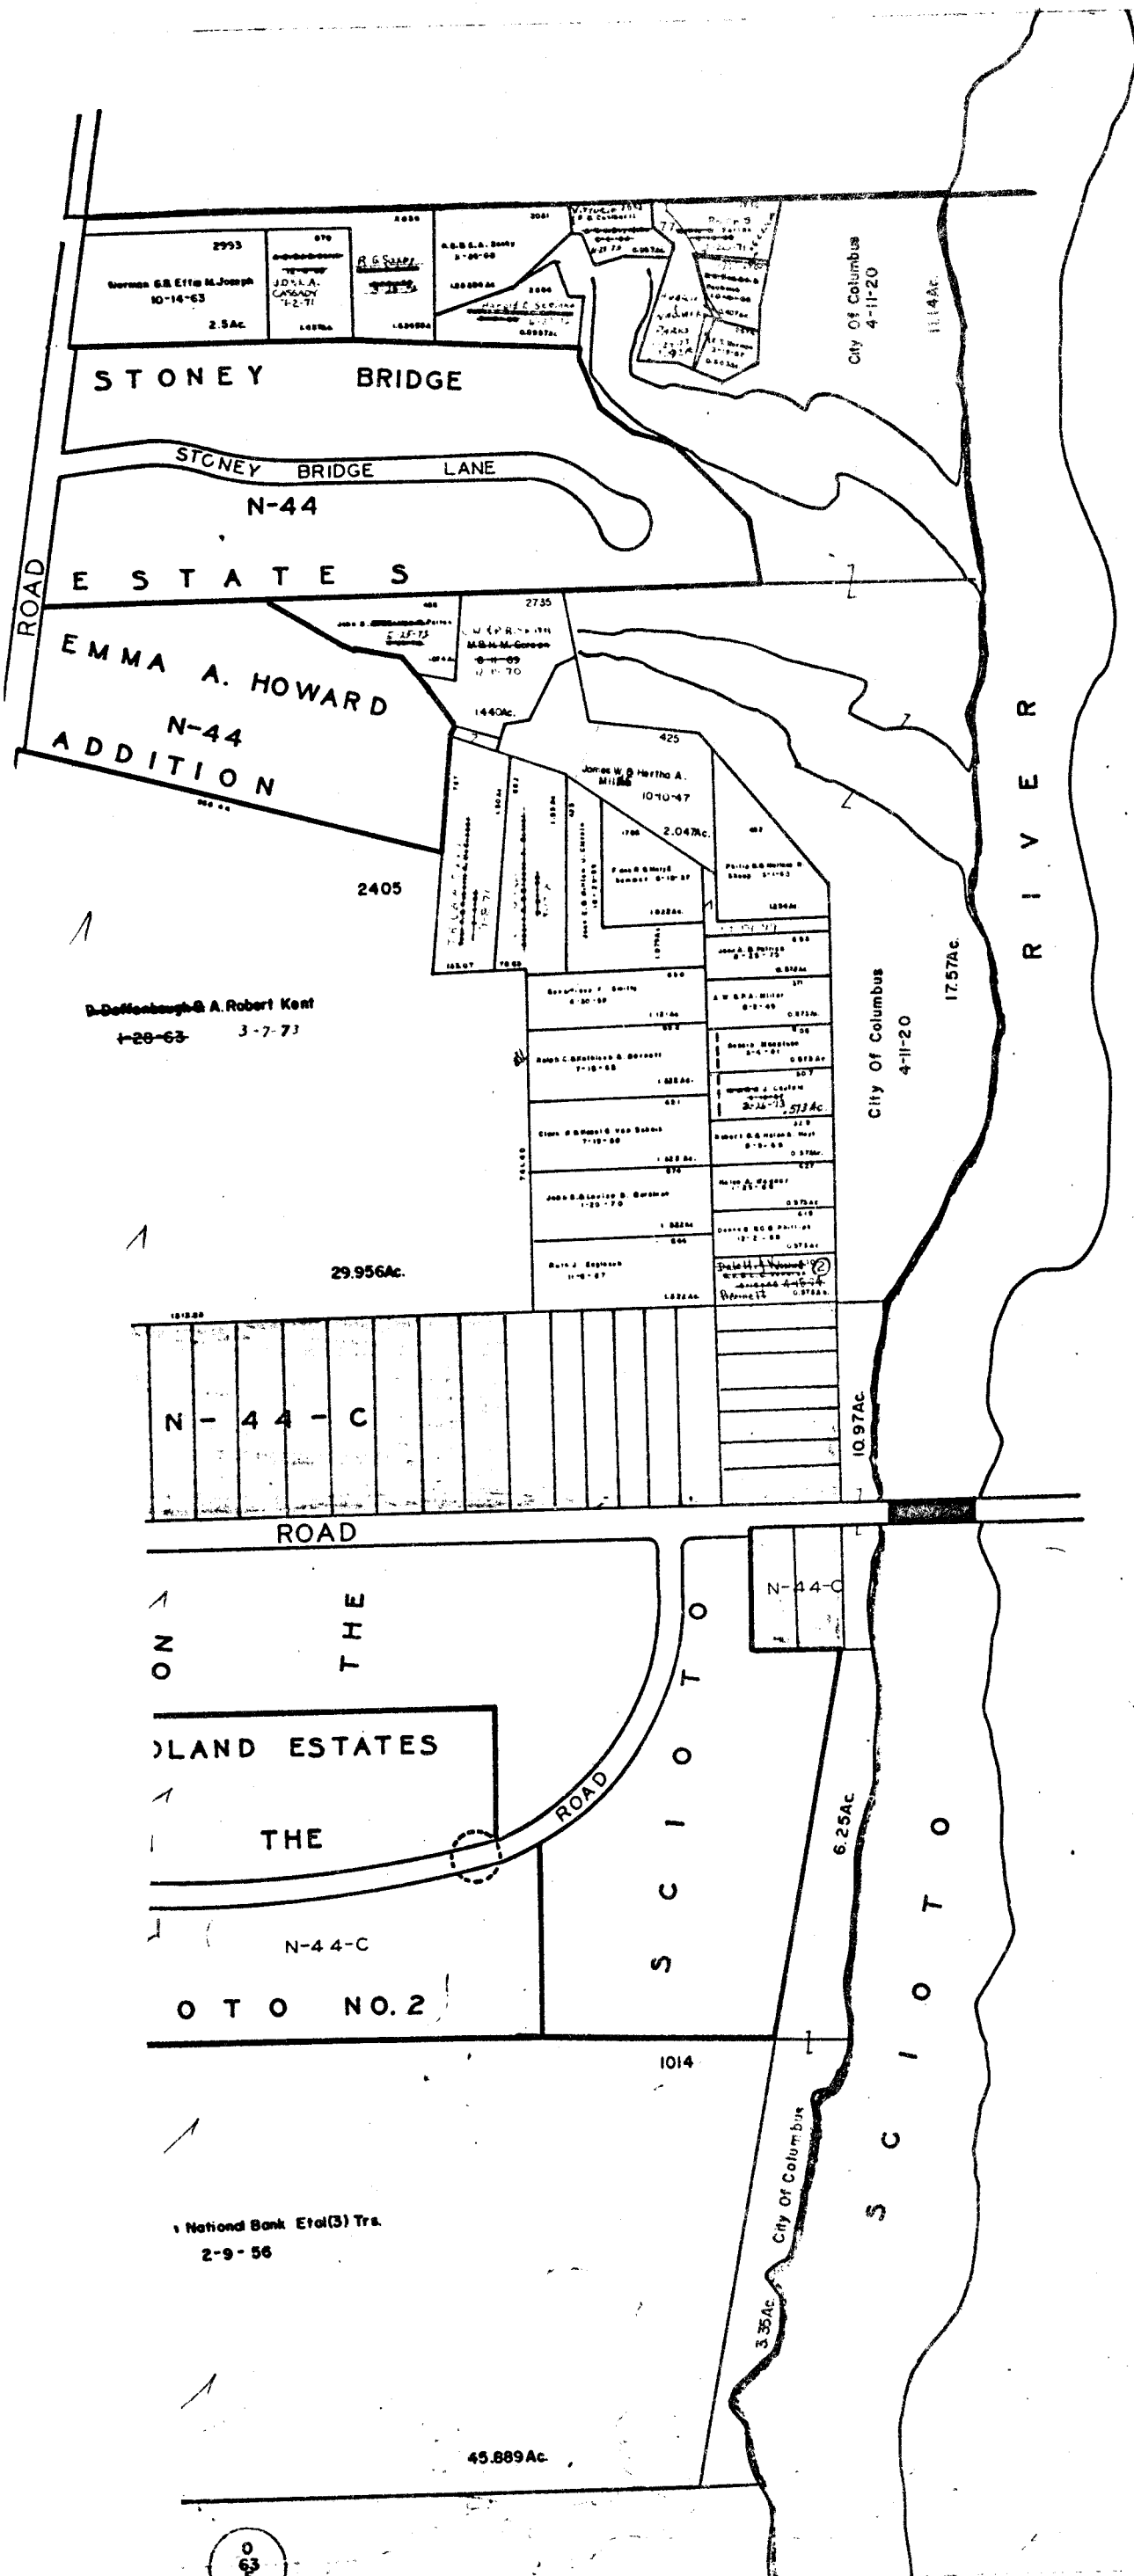

SCALE 1"=200  
V.M.S.  
TAXING DISTRICTS  
NORWICH

① 2704 EDWARD A. NORMAN INVESTMENT CO. 3-16-73 140776  
② 610-VIVIANE BENNETT 10-26-73 .573Ac



TOWNSHIP

66

PEERY

D. Doffenbaugh & A. Robert Kent  
1-28-63 3-7-73

National Bank Et al(3) Trs.  
2-9-56

63