




080

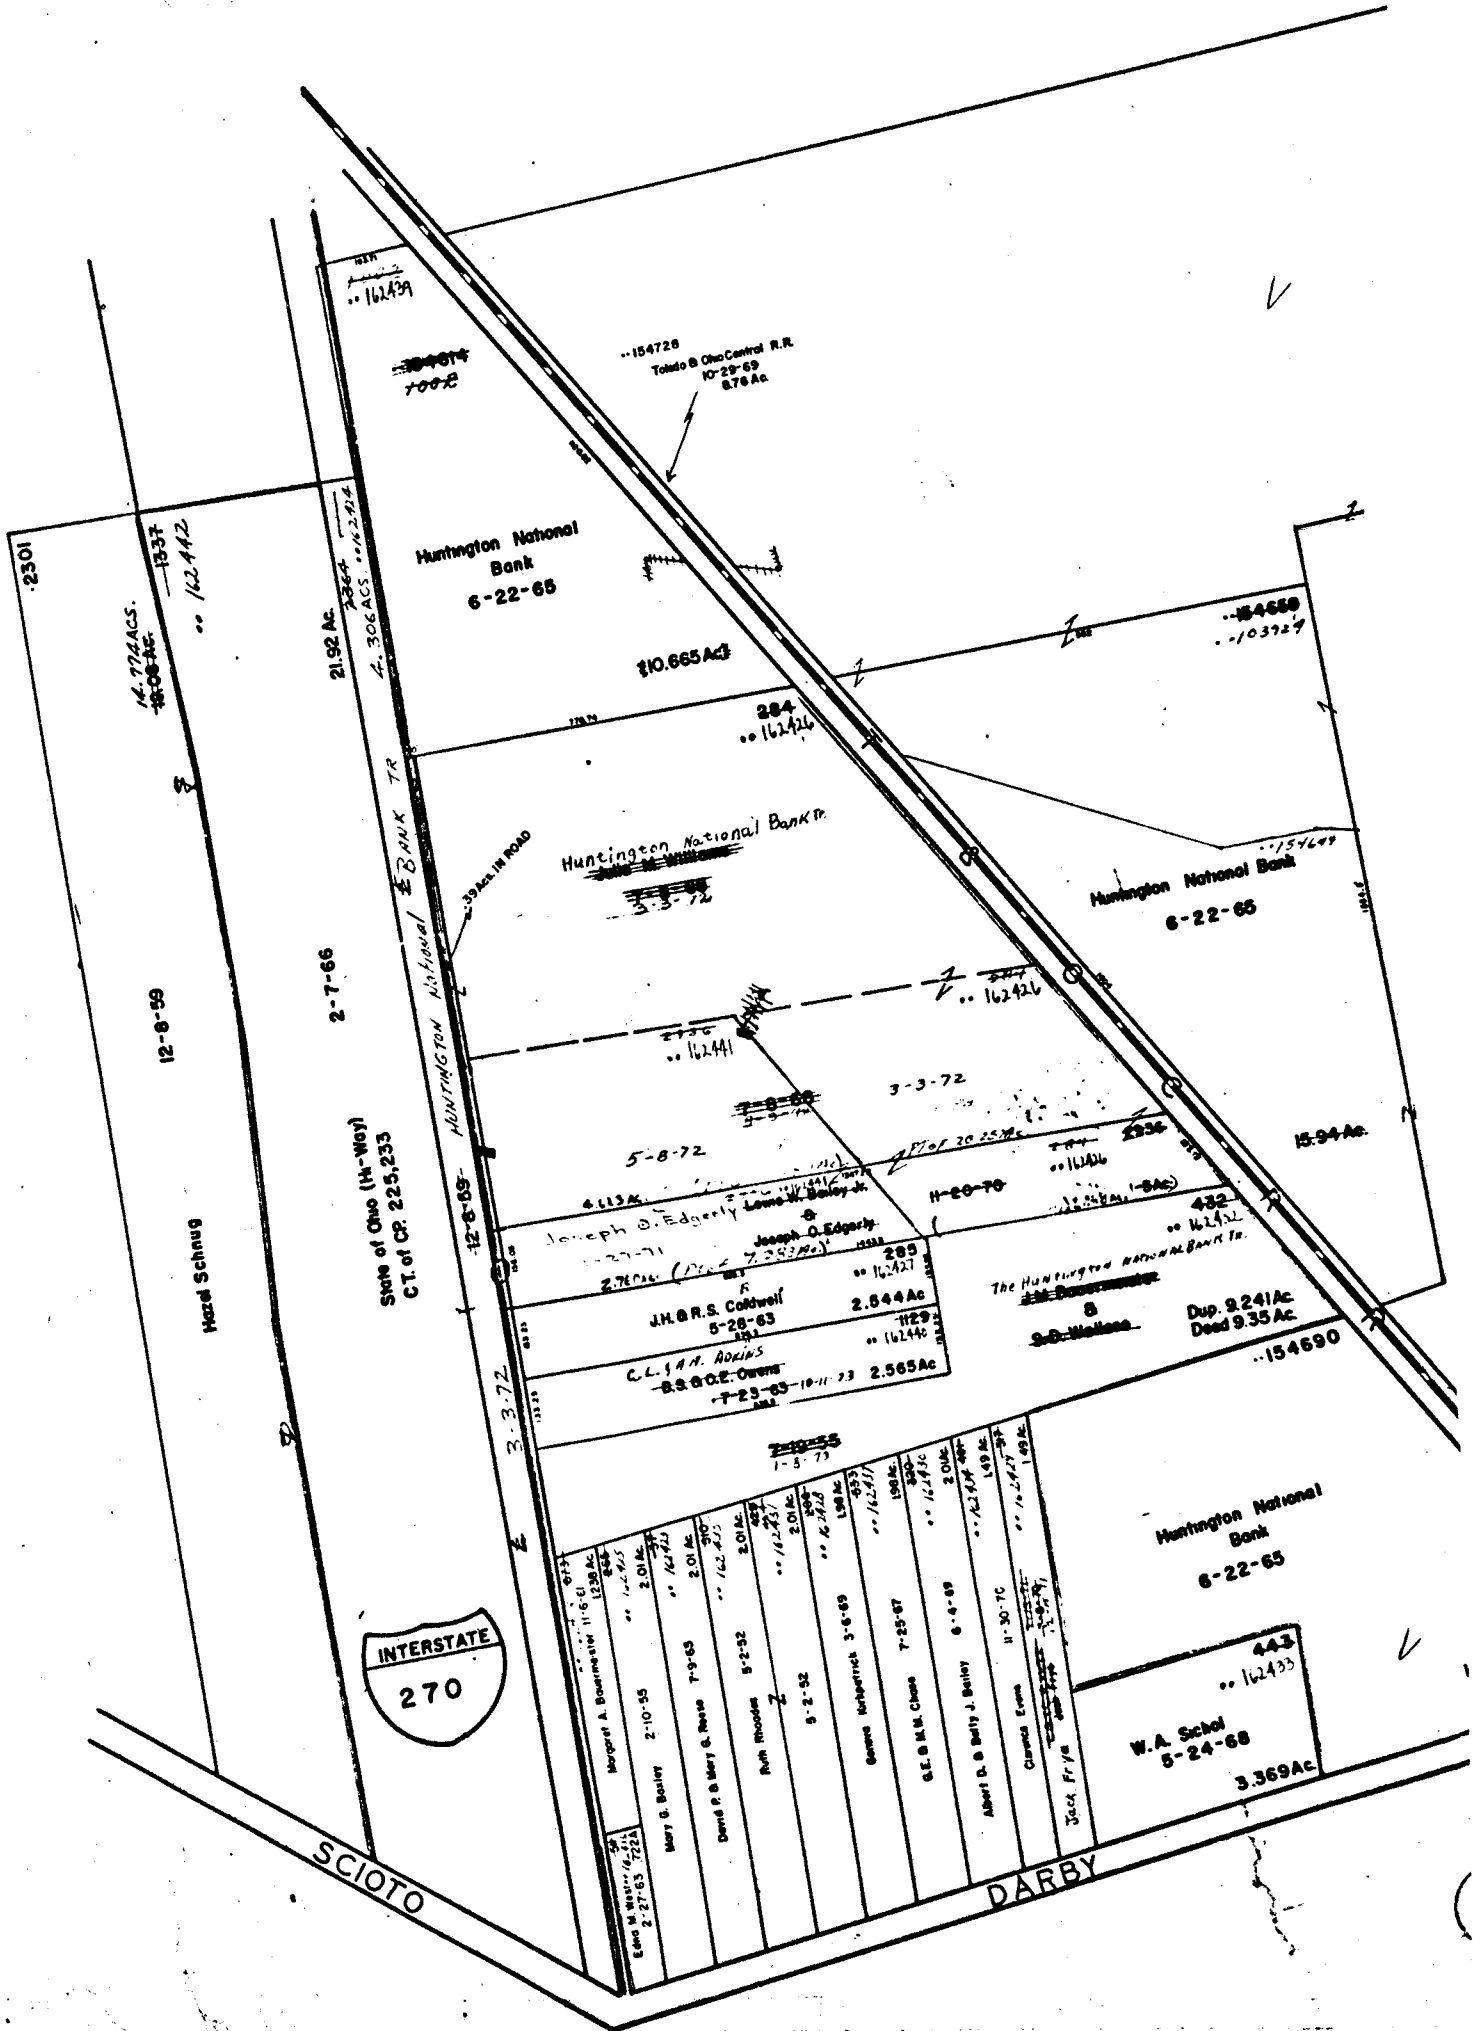

O-63-E  
NORWICH TWP

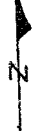

SCALE 1"=200'  
VMS  
TAXING DISTRICTS  
NORWICH TWP.  
• CITY OF HILLIARD  
•• SCIOTO-DARBY S.D.

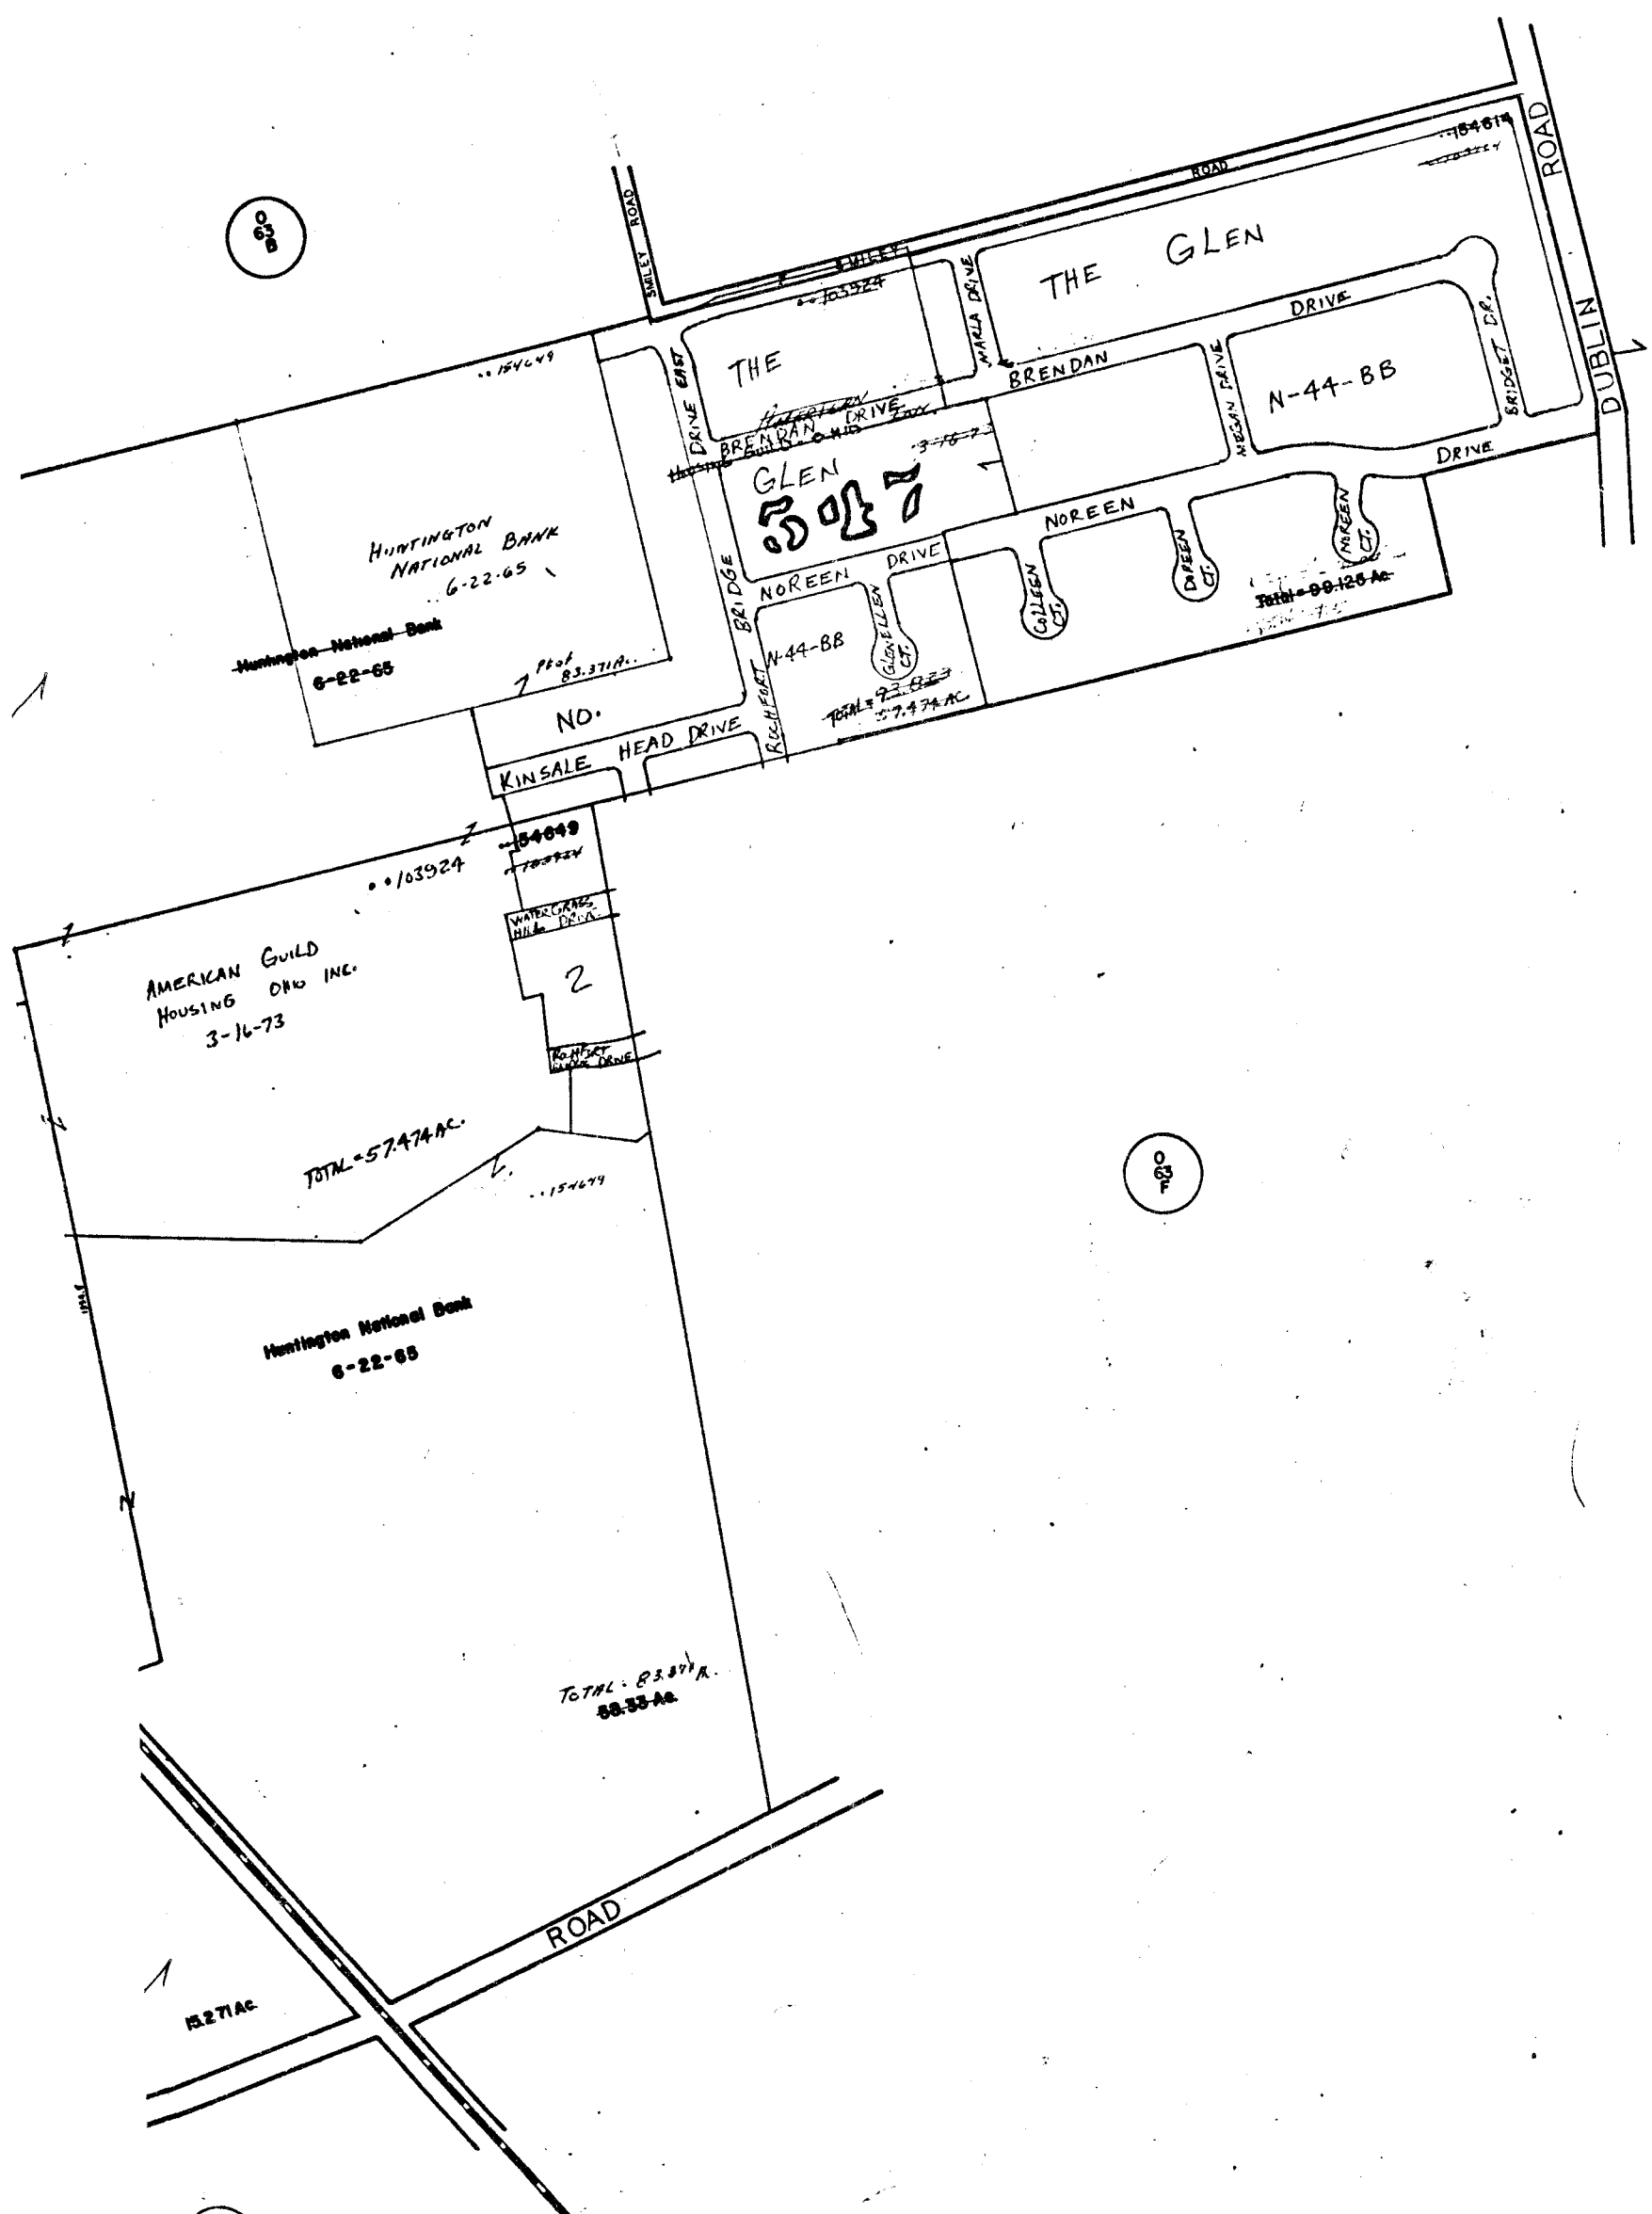

O  
63  
E

O  
63  
E

O  
63  
E

O-63-E

Prepared by	...
Checked by	...
Date of Issue	...

3648