

6542

0-64-C
NORWICH TWP.




SCALE 1" = 200'
V.M.S.
TAXING DISTRICTS
NORWICH

64
A

64
D

6541

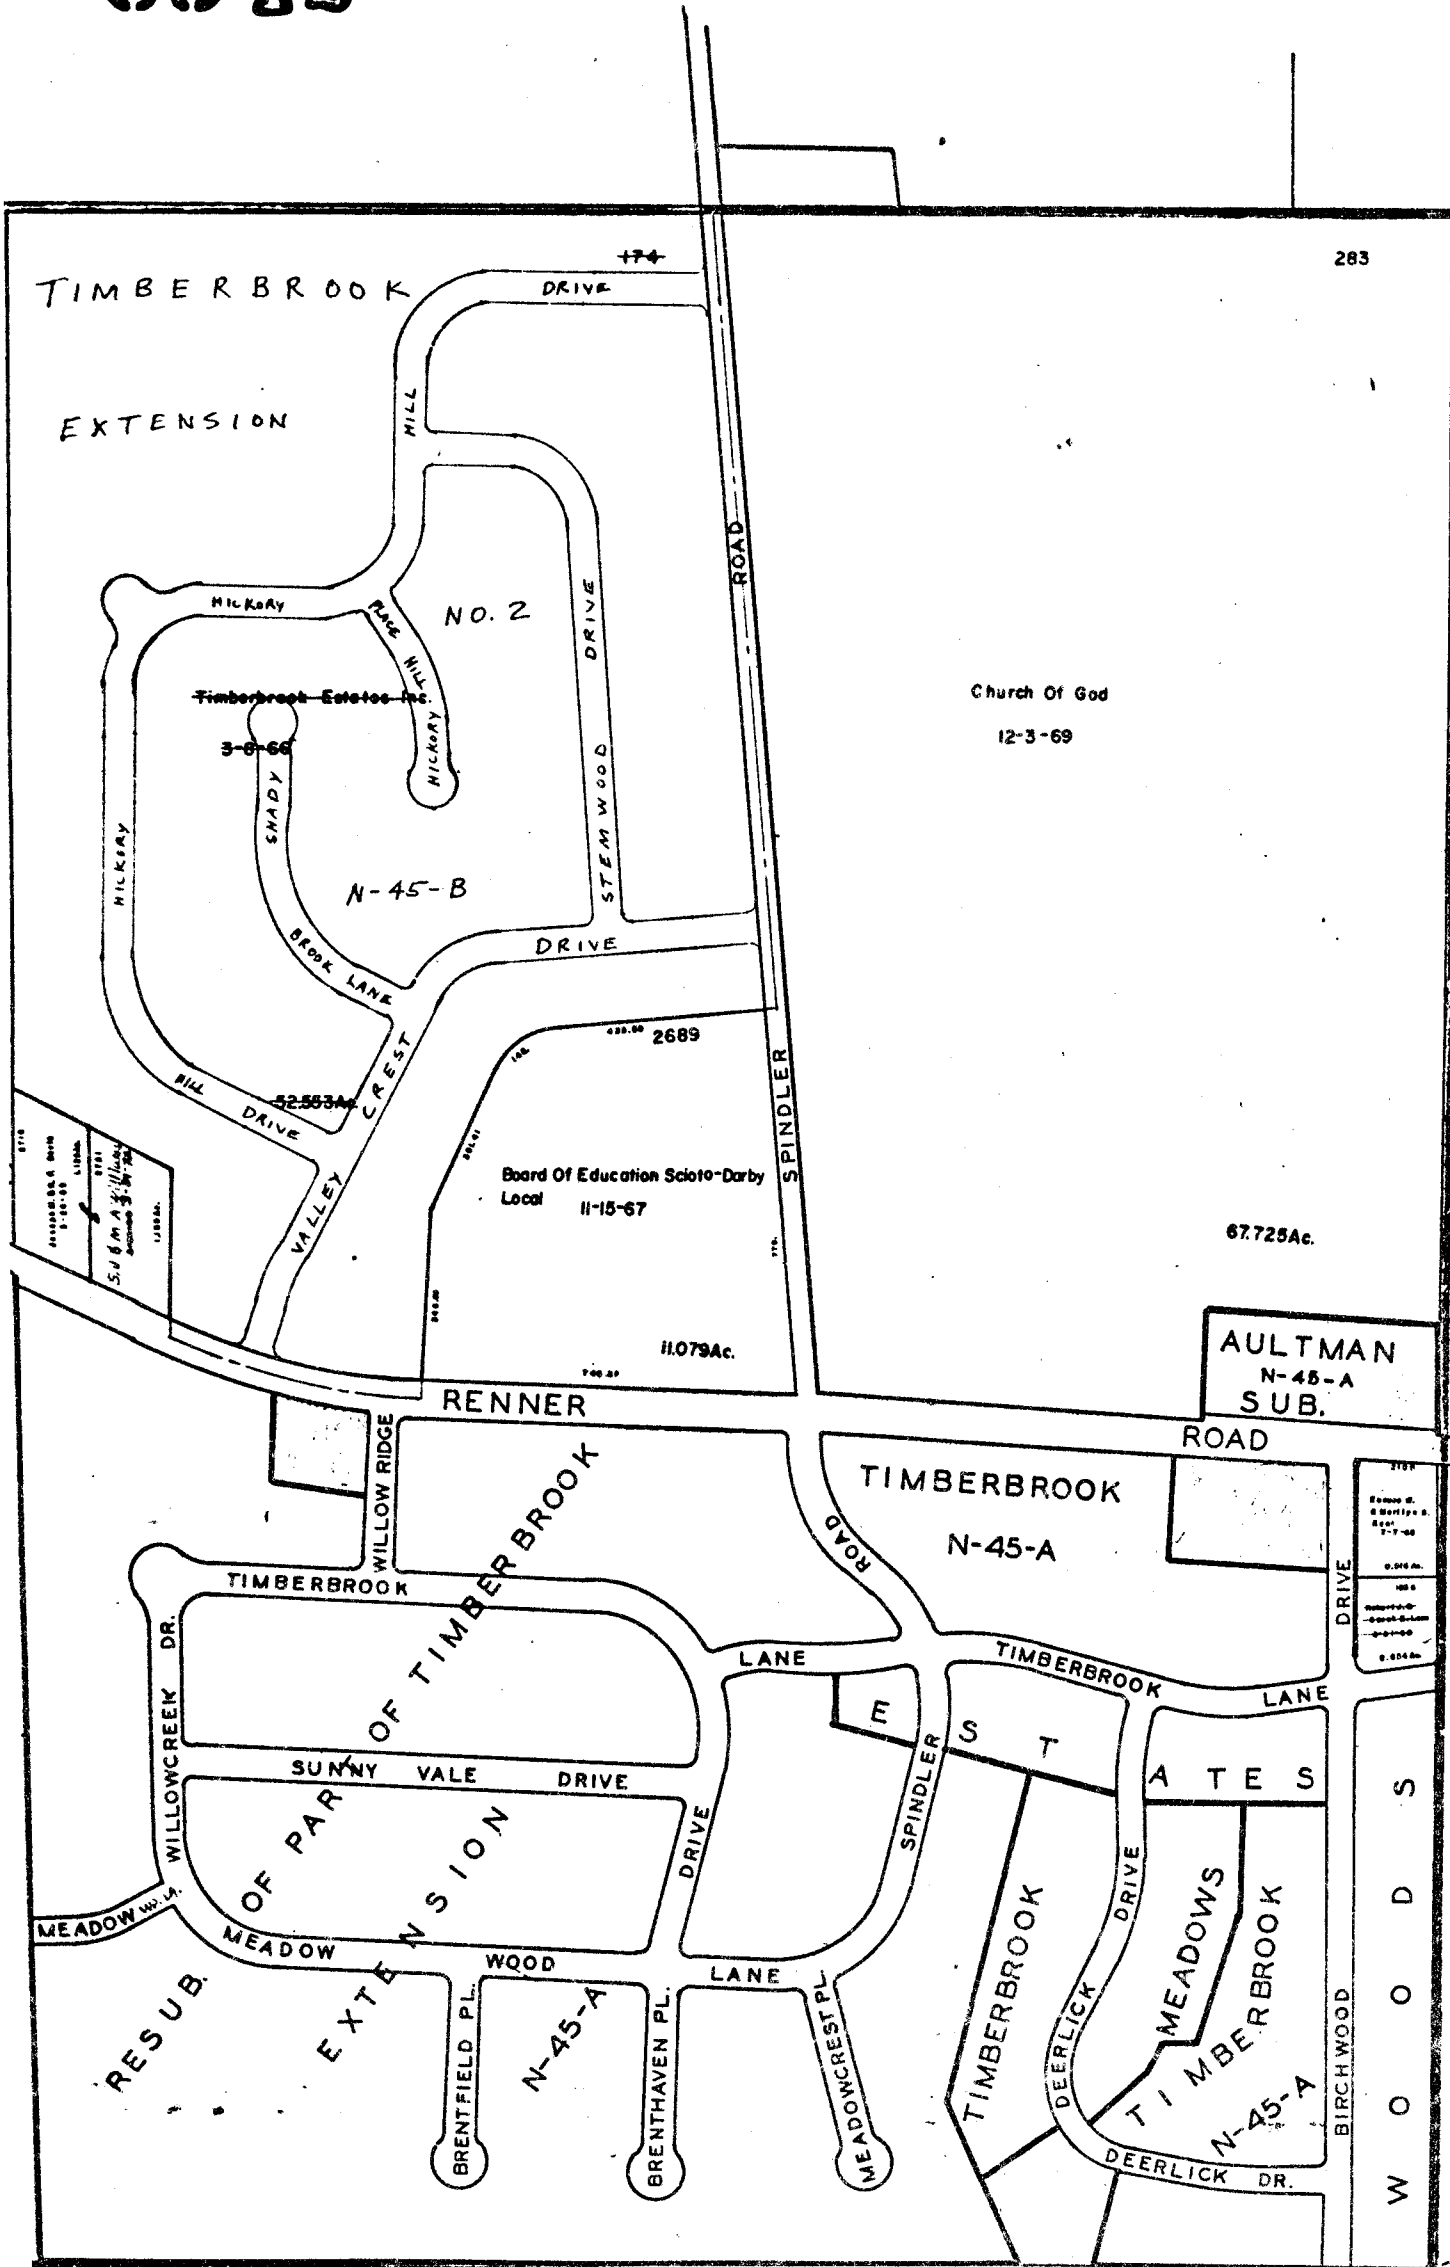

80

3662

0-64-C