

5239
5241

237

00
M 24

29333

00
M 24

3316

INTERSTATE
270


PRAIRIE

FRABUE
T W P

FRANKLIN

3669

0
18
A

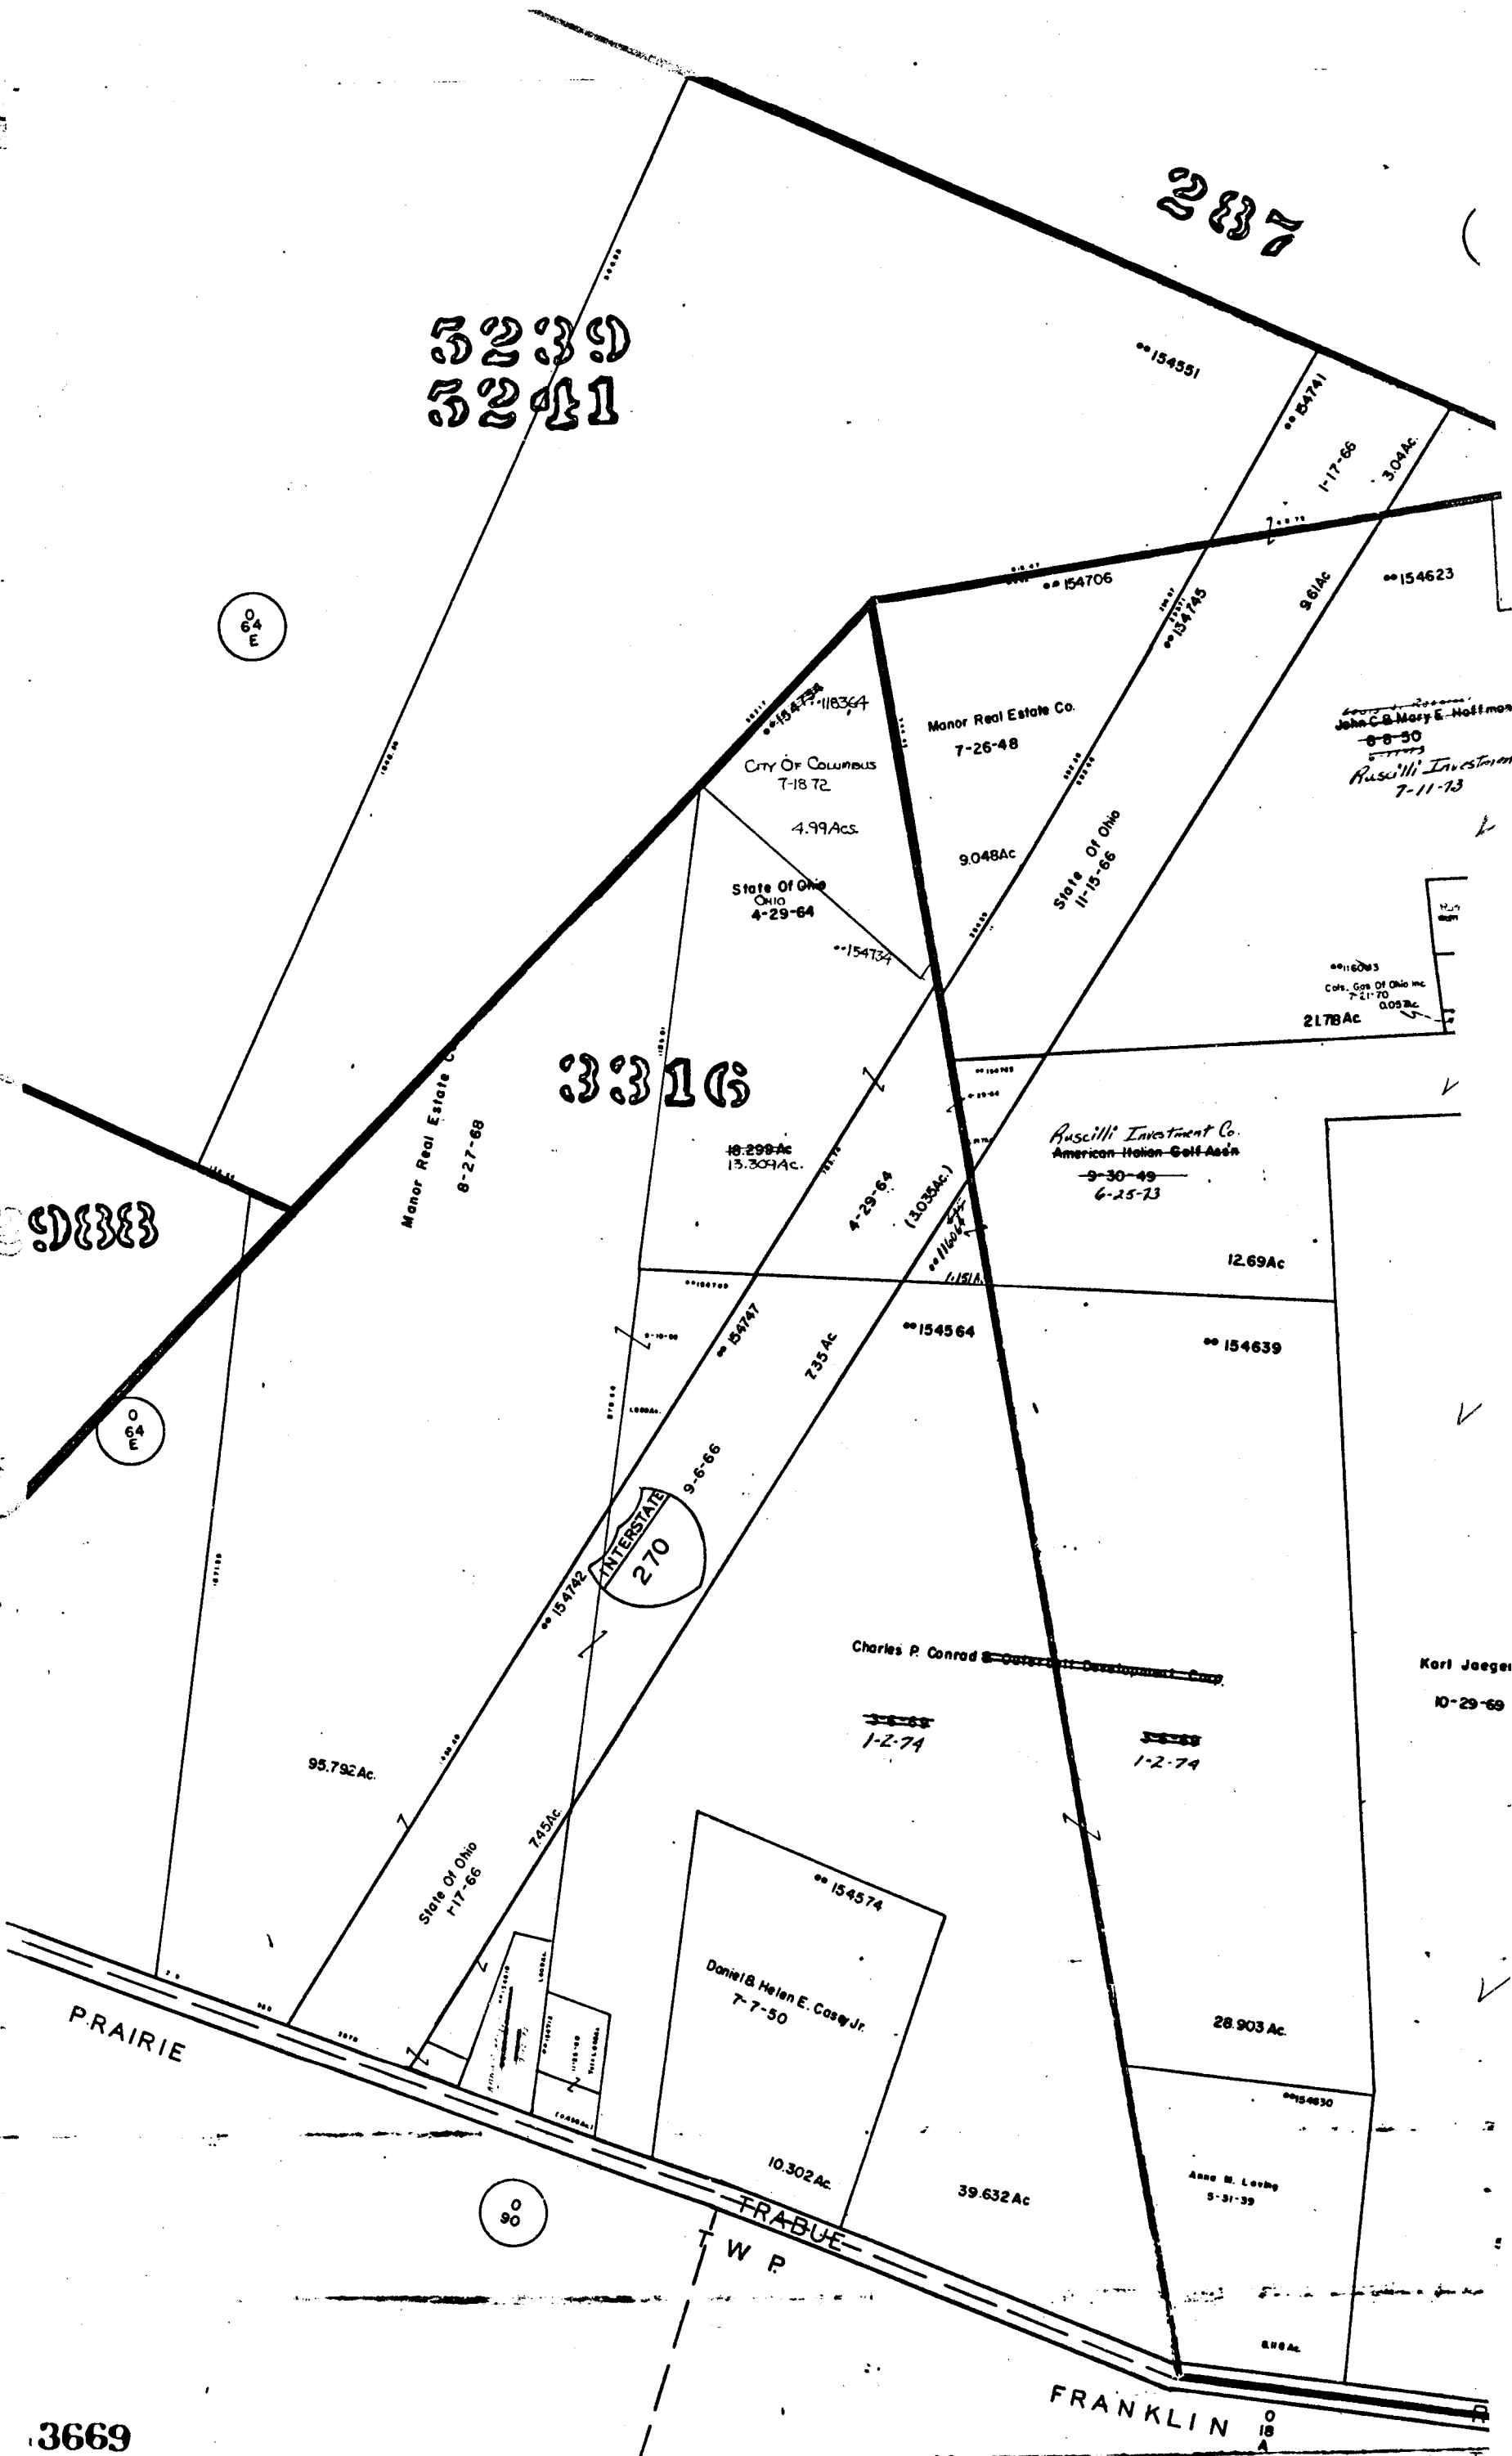

Manor Real Estate Co. 8-27-68
 Manor Real Estate Co. 7-26-48
 City Of Columbus 7-18-72
 State Of Ohio 4-29-64
 State Of Ohio 11-15-66
 Ruscilli Investment Co. 7-11-73
 John C. & Mary E. Hoffman 8-8-50
 Ruscilli Investment 7-11-73
 Charles P. Conrad 1-2-74
 Daniel & Helen E. Casey Jr. 7-7-50
 Anne M. Leung 5-31-39

95.792 Ac
 4.99 Ac
 9.048 Ac
 9.81 Ac
 3.04 Ac
 18.299 Ac
 13.309 Ac
 12.69 Ac
 7.35 Ac
 28.903 Ac
 10.302 Ac
 39.632 Ac


0-65-A
NORWICH TWP

SCALE 1"=200'
V.M.S.
TAXING DISTRICTS
NORWICH
COL. SCIOTO-BARRY'S D.

0
63
H

0
63
H

3057

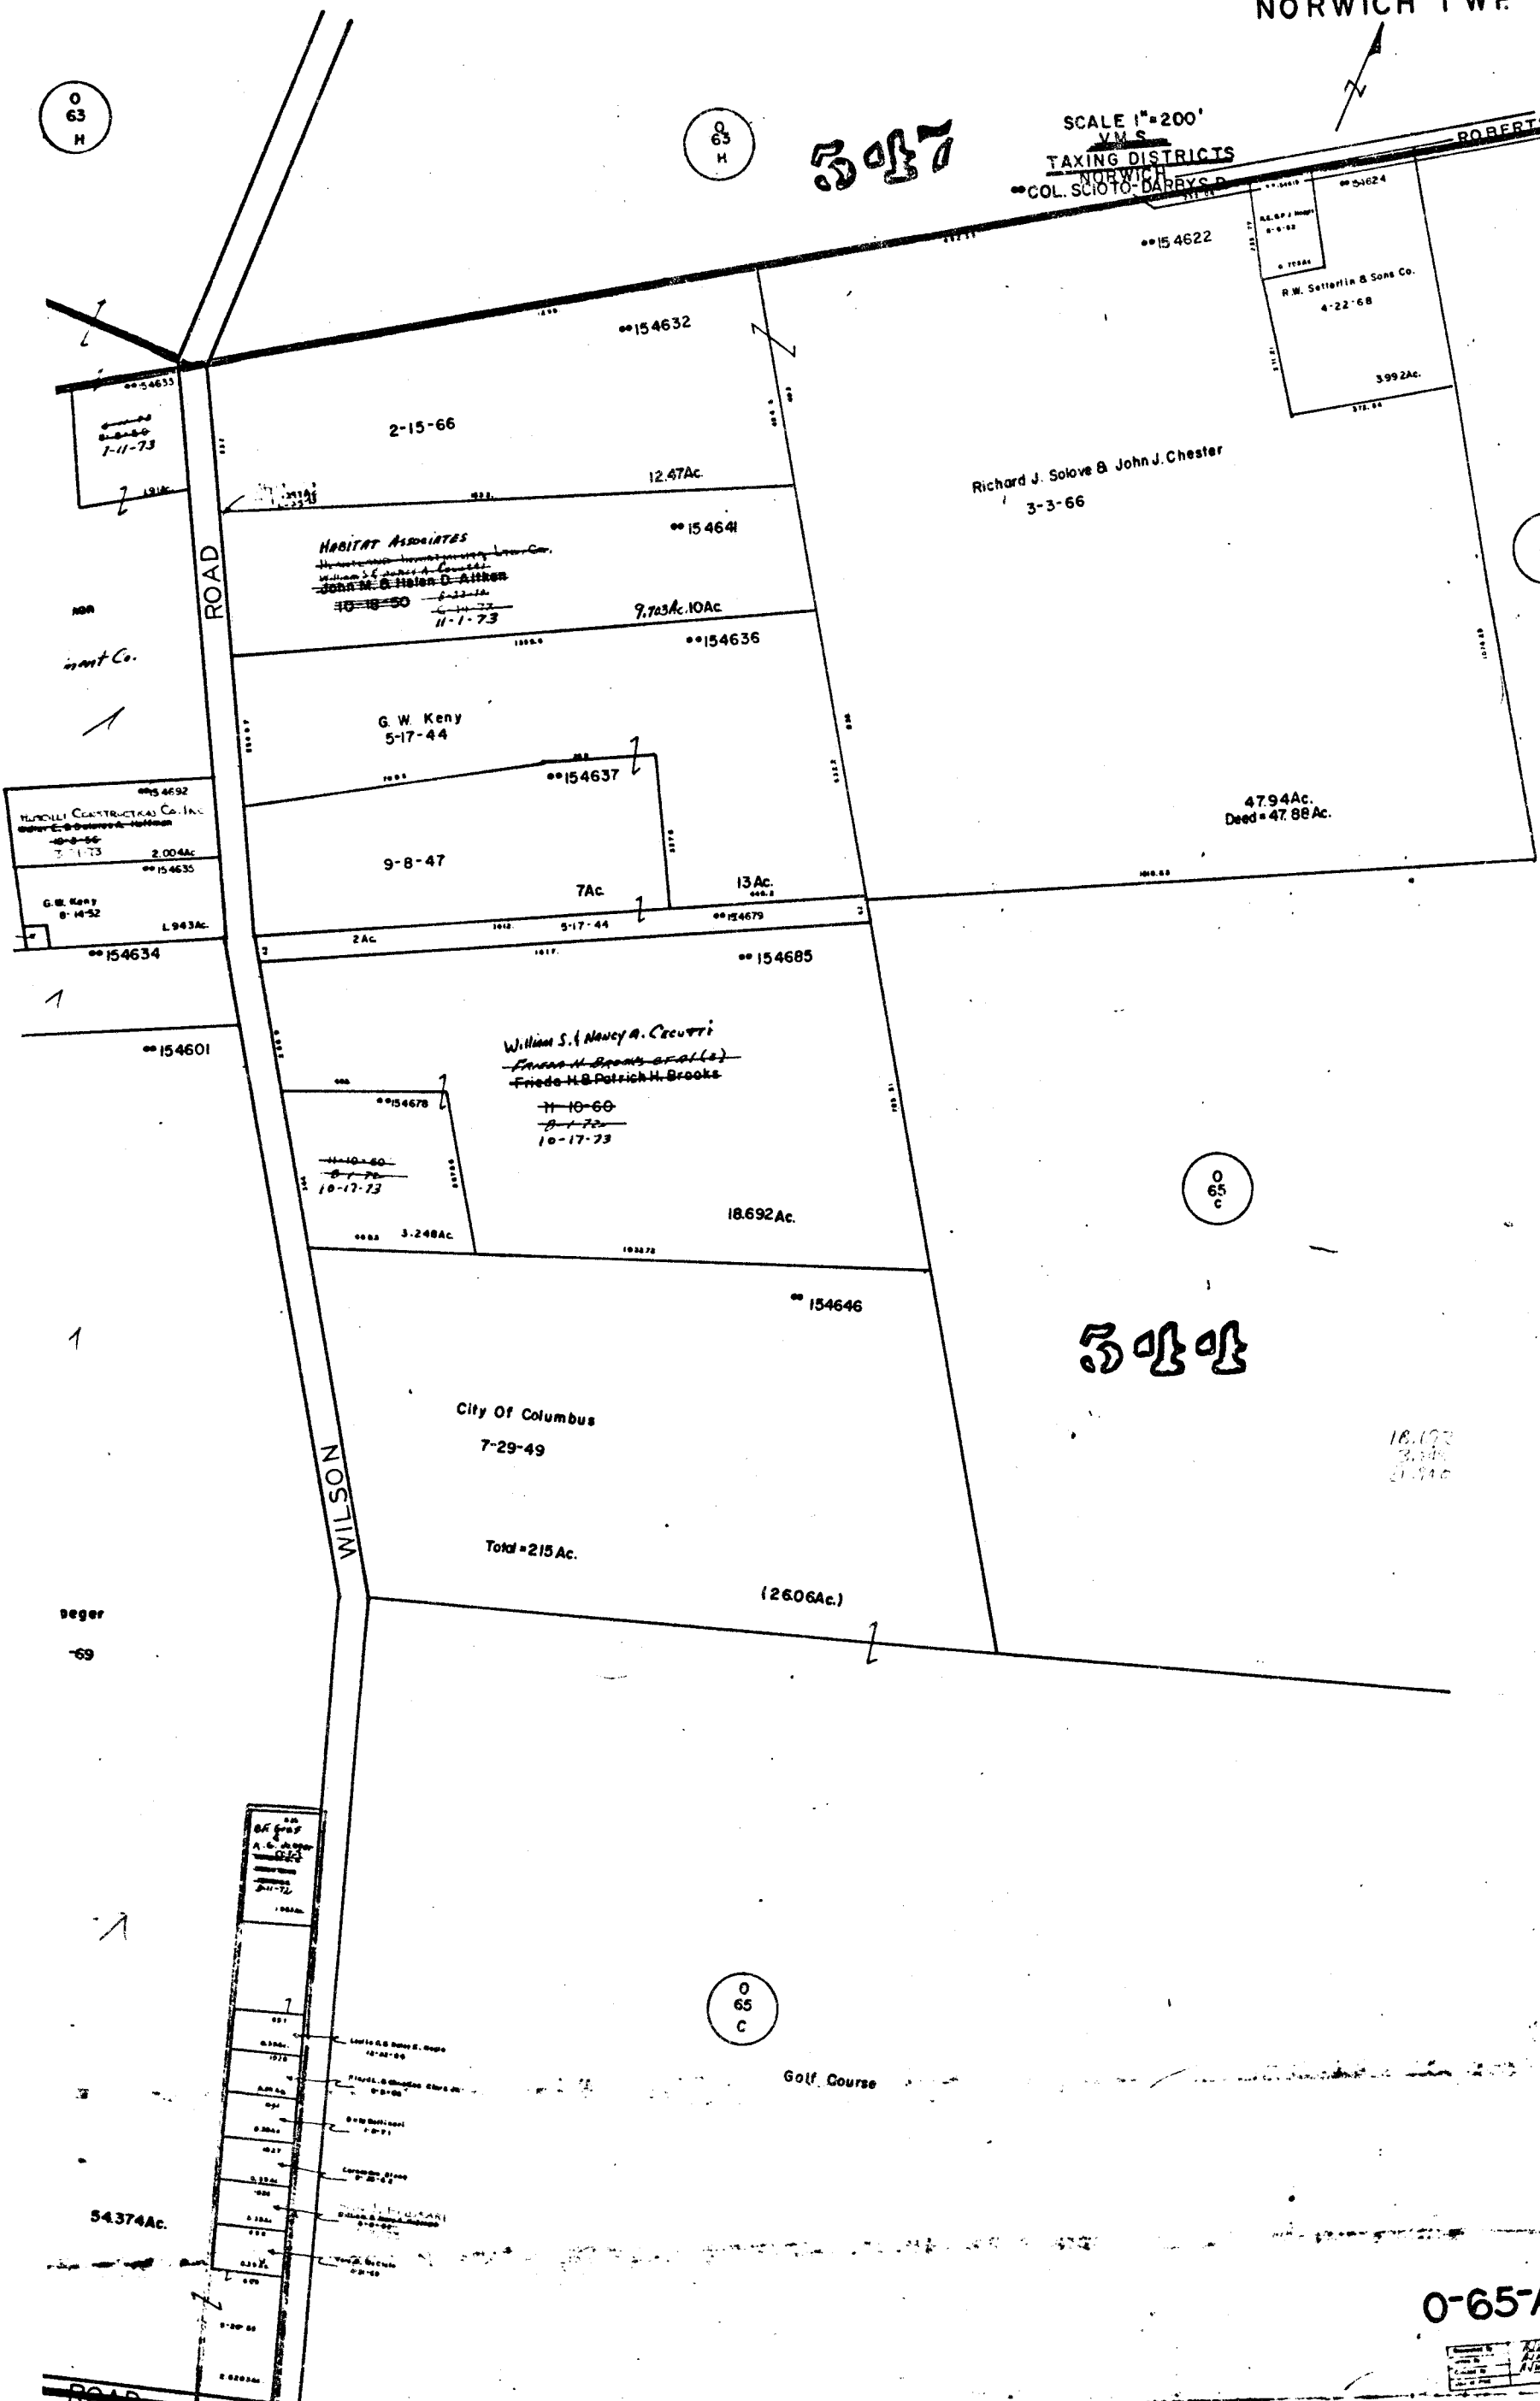

0
65
C

0
65
C

3057

18.192
3.345
21.537

0-65-A

1/2
1/2
1/2

3670