

DELAWARE

0038
CUL GAS OF OHIO, INC.
7-31-71
0918 84

SMOTHERS

20


TWP.

ROAD

BLENDON

SCHOTT

20

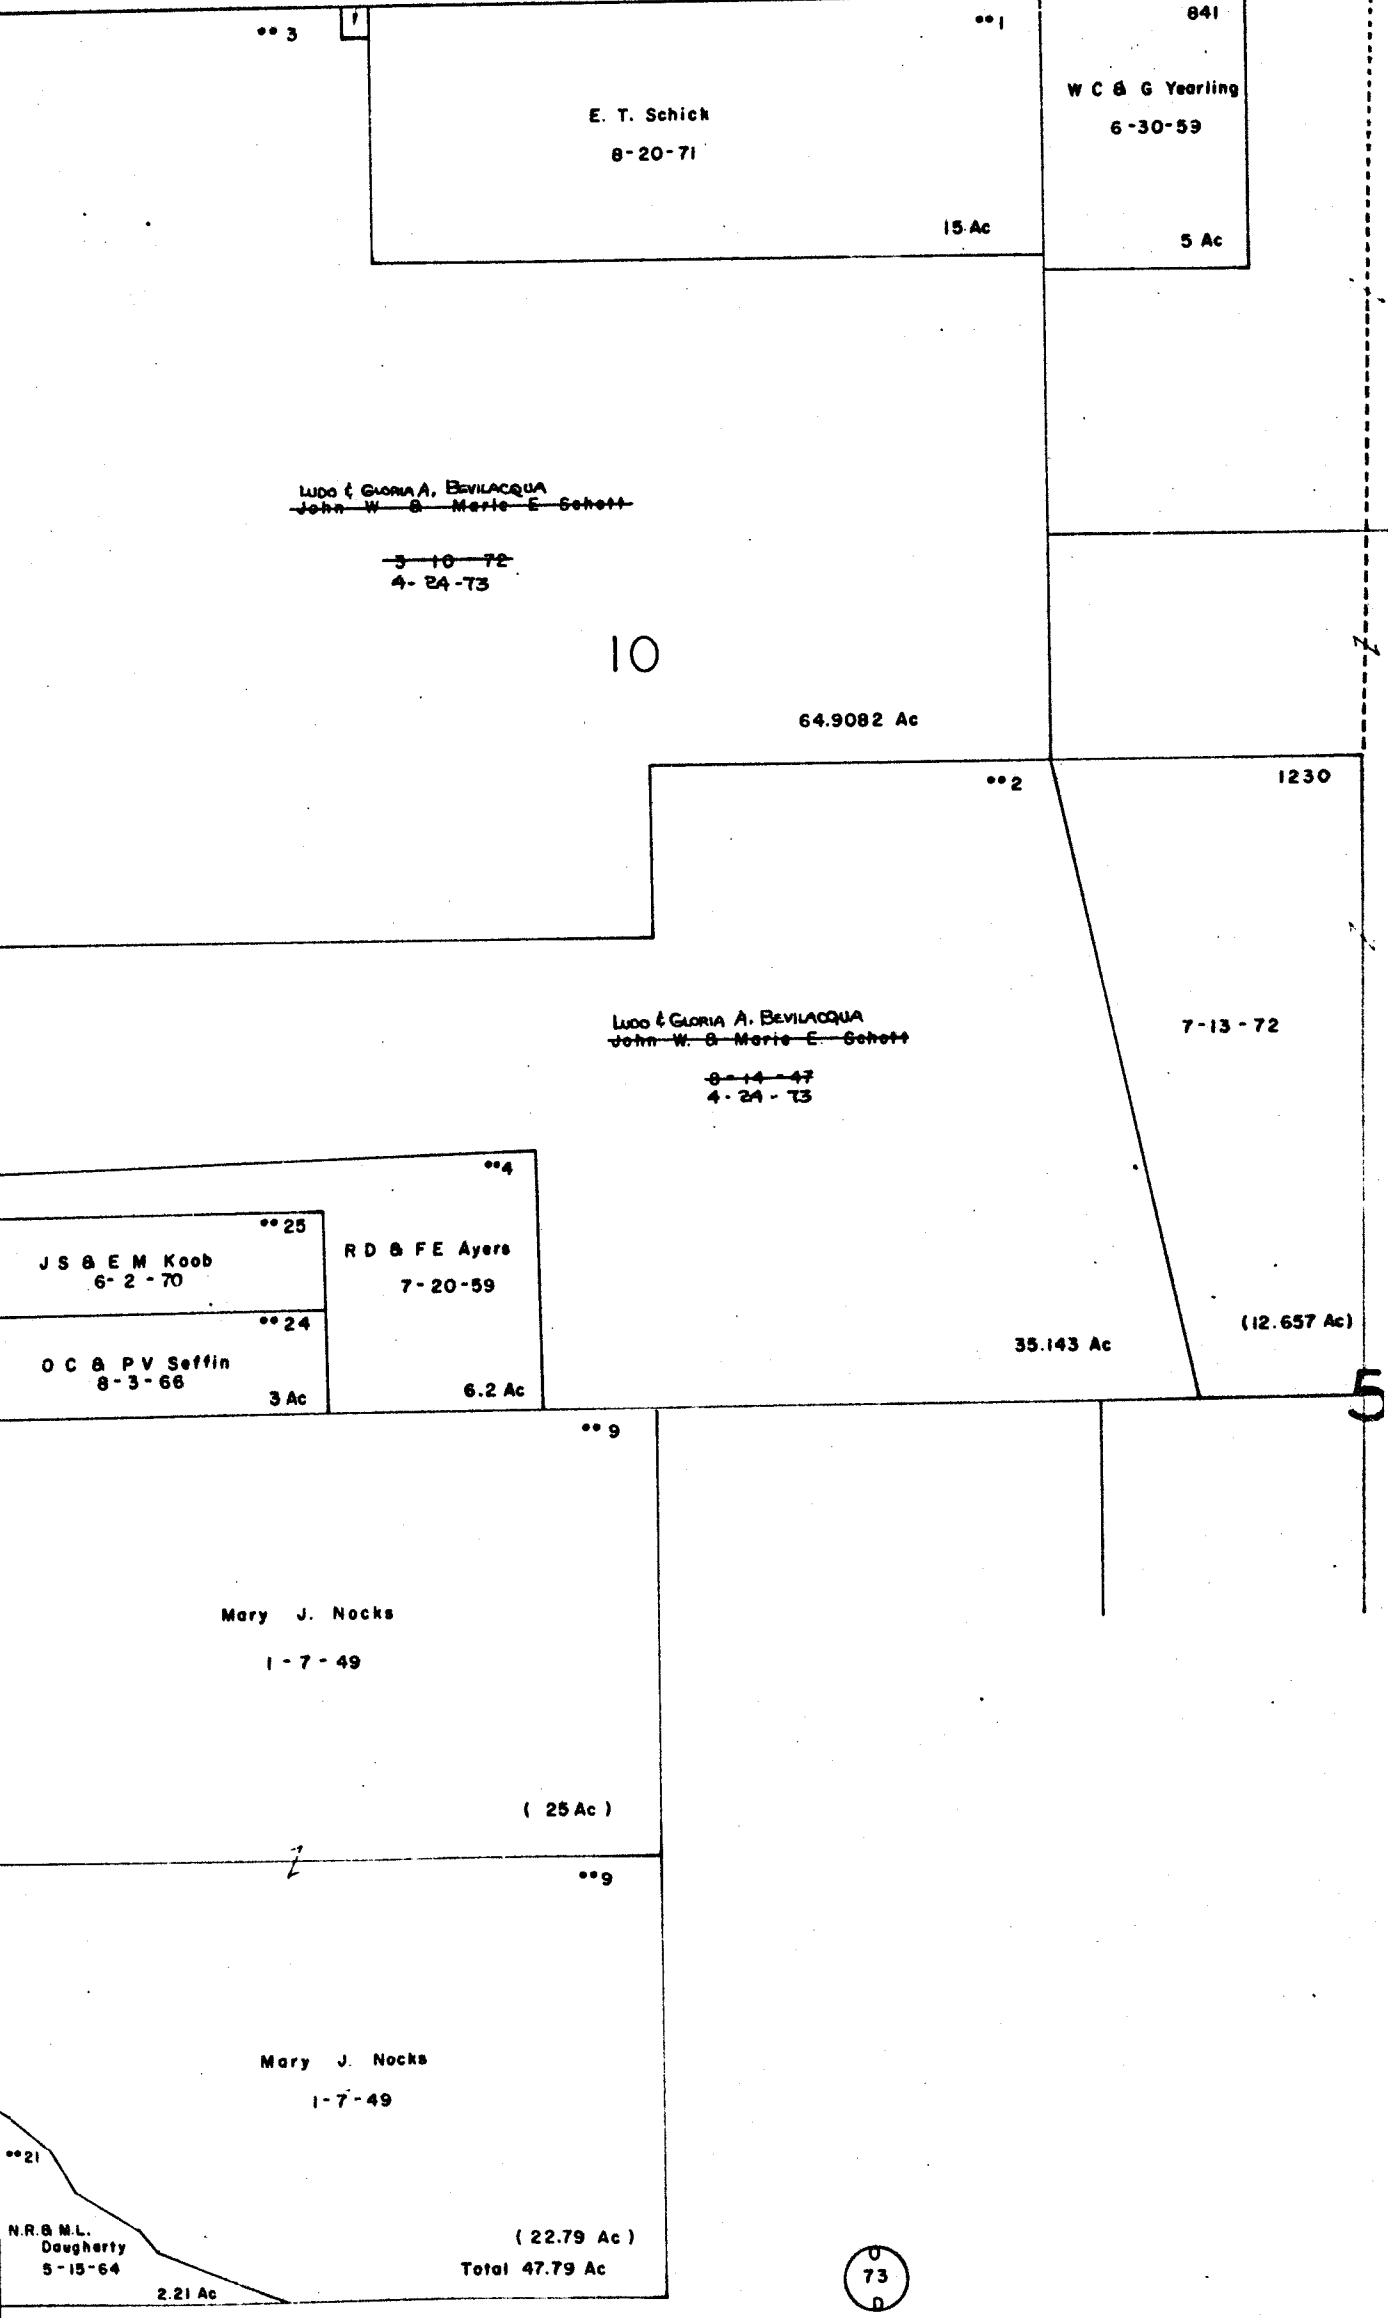

73

O-73-A

PLAIN TWP.

R.16 TWP2

N


SCALE 1" = 200'

TAXING DISTRICT

PLAIN TWP.

**PLAIN-WESTERVILLE S.D.

COUNTY

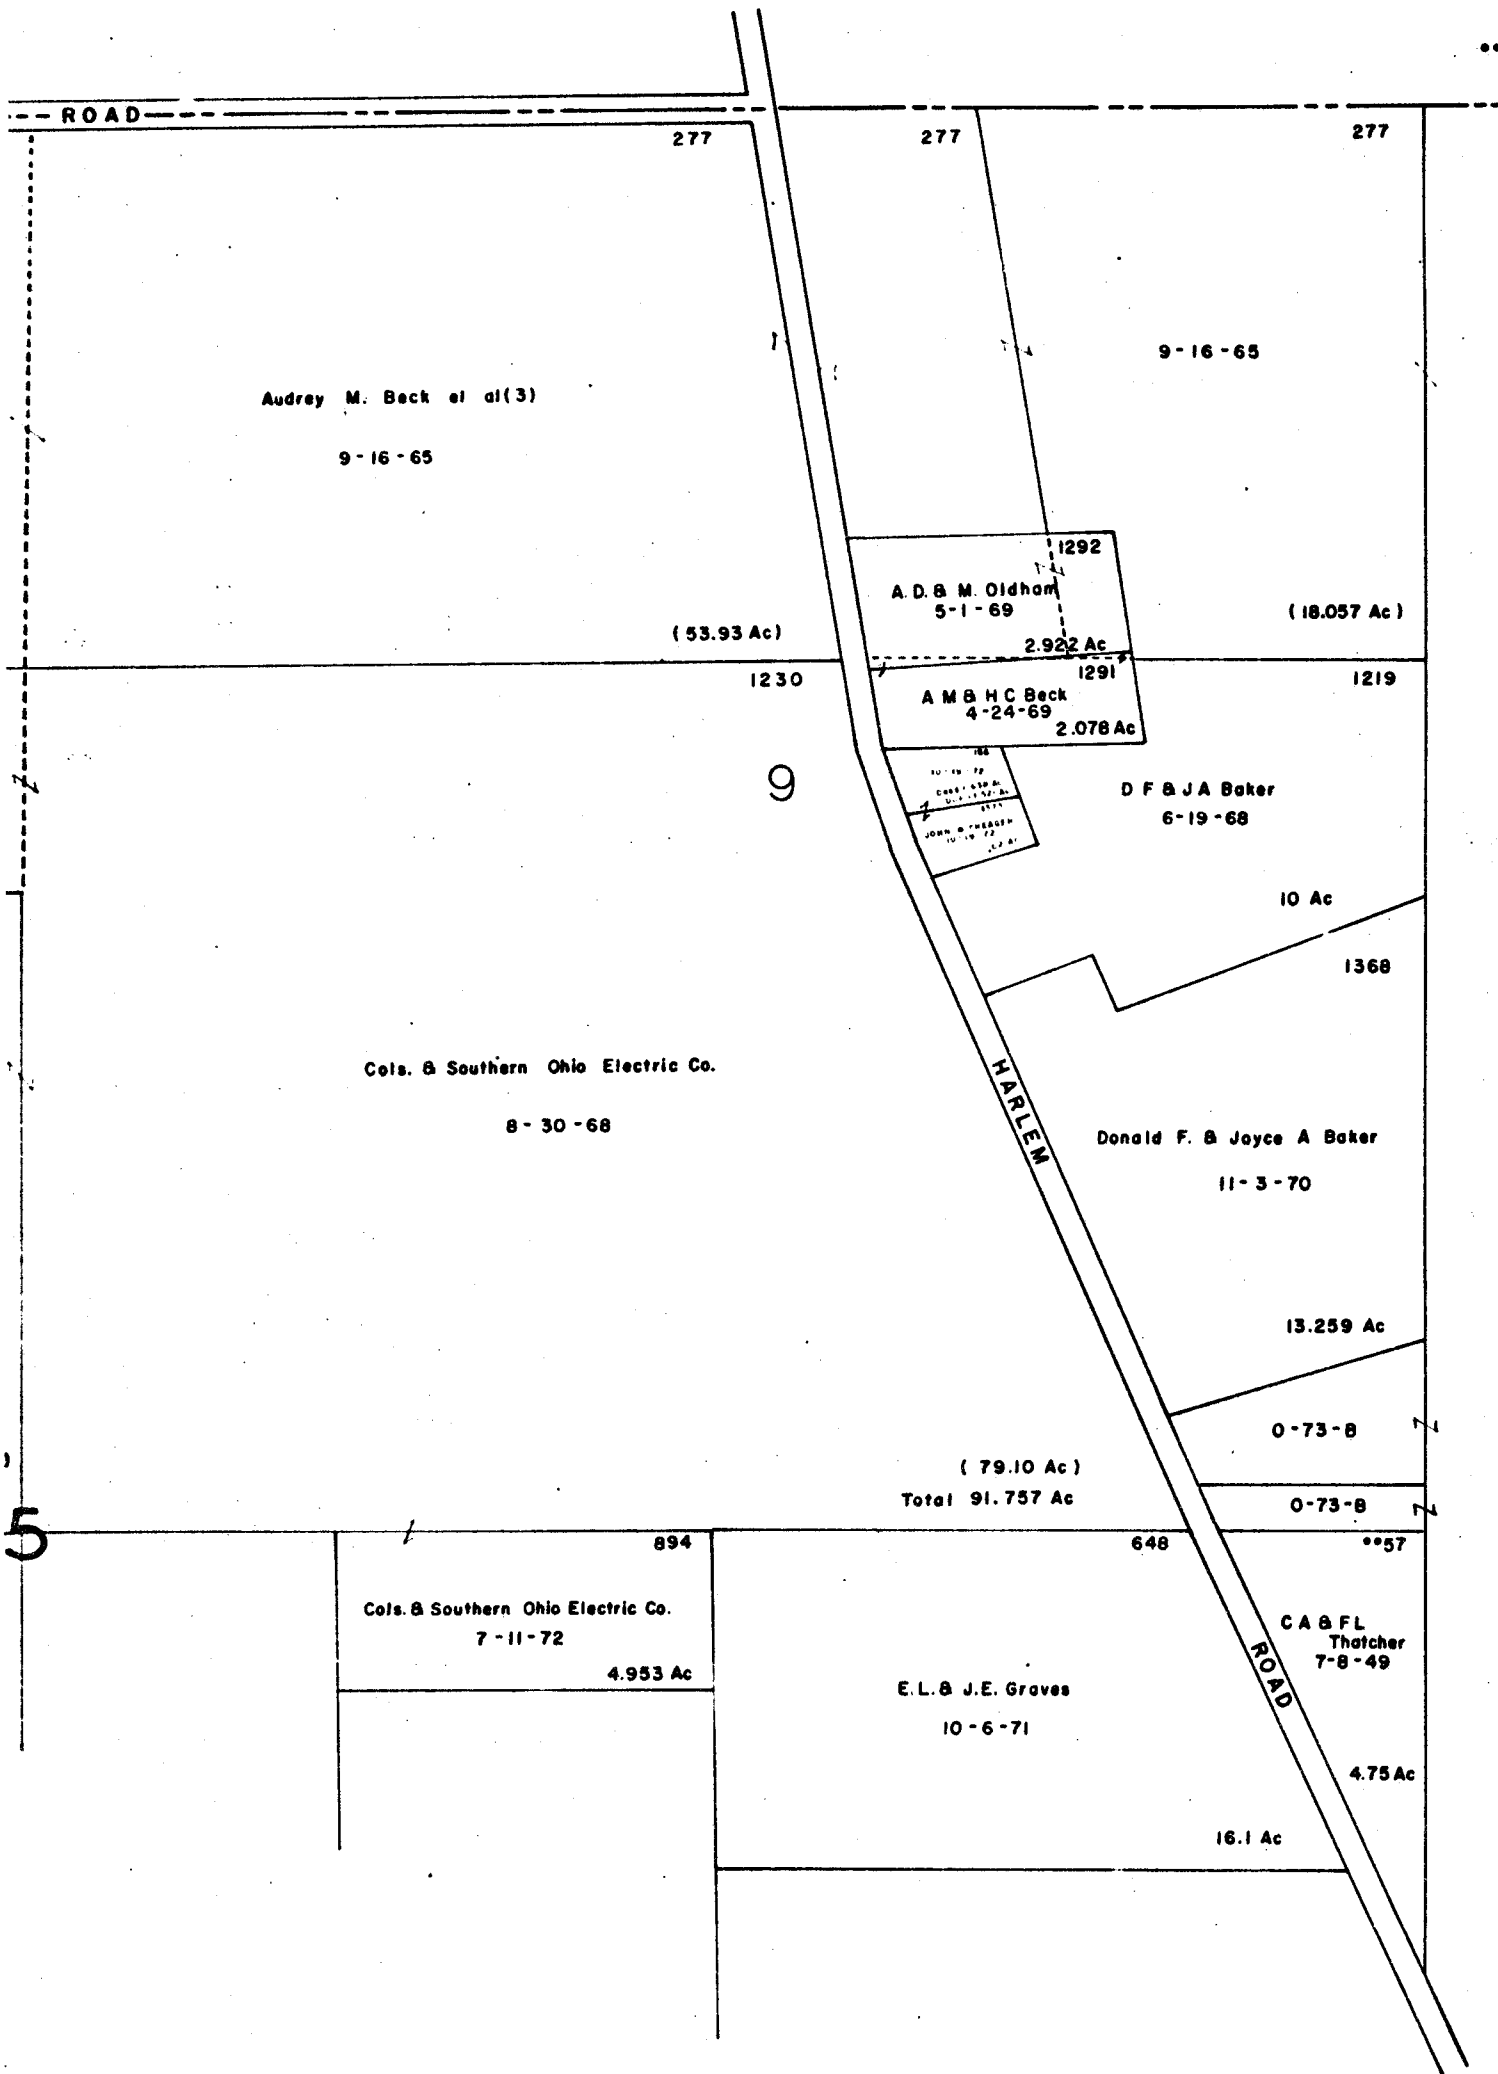

0
73
B

0
73
B

0
73
E

O-73-A

FILE 3758