


DELAWARE

BEVELHEIMER

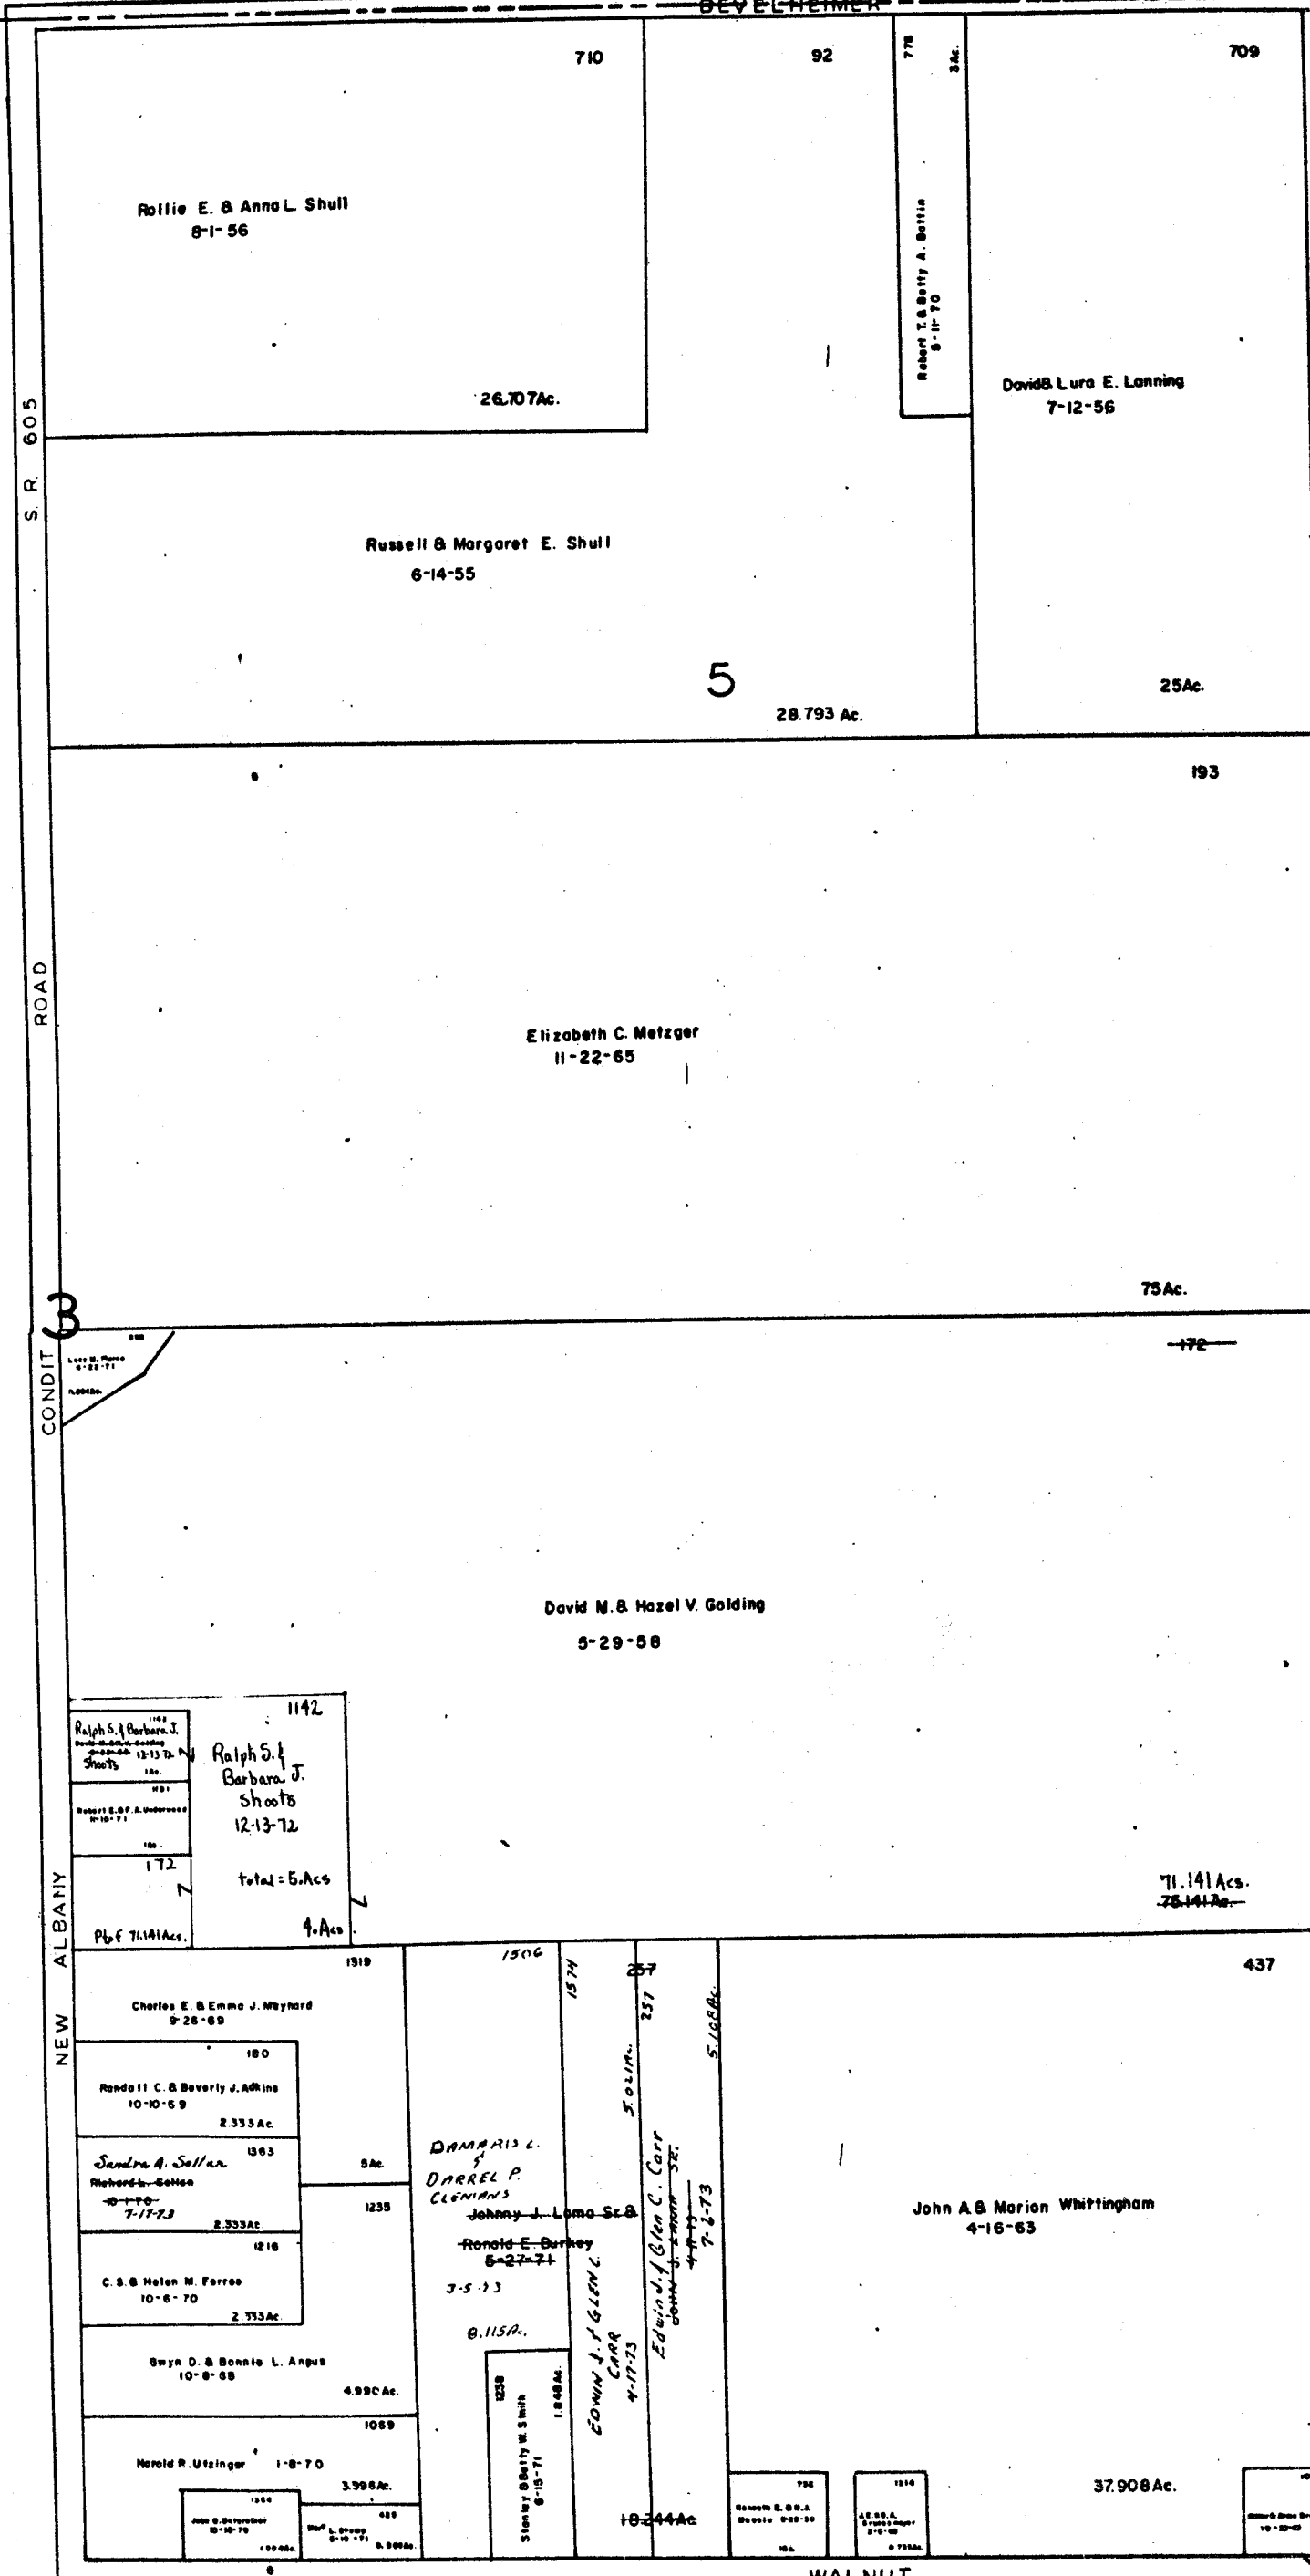

0 73

3

NEW ALBANY ROAD

WALNUT

0 74 D

3777

