



074 C

0-74-E

PLAIN TWP
R.16 TWP2

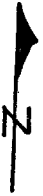

SCALE 1"=200'
TAXING DISTRICTS
PLAIN

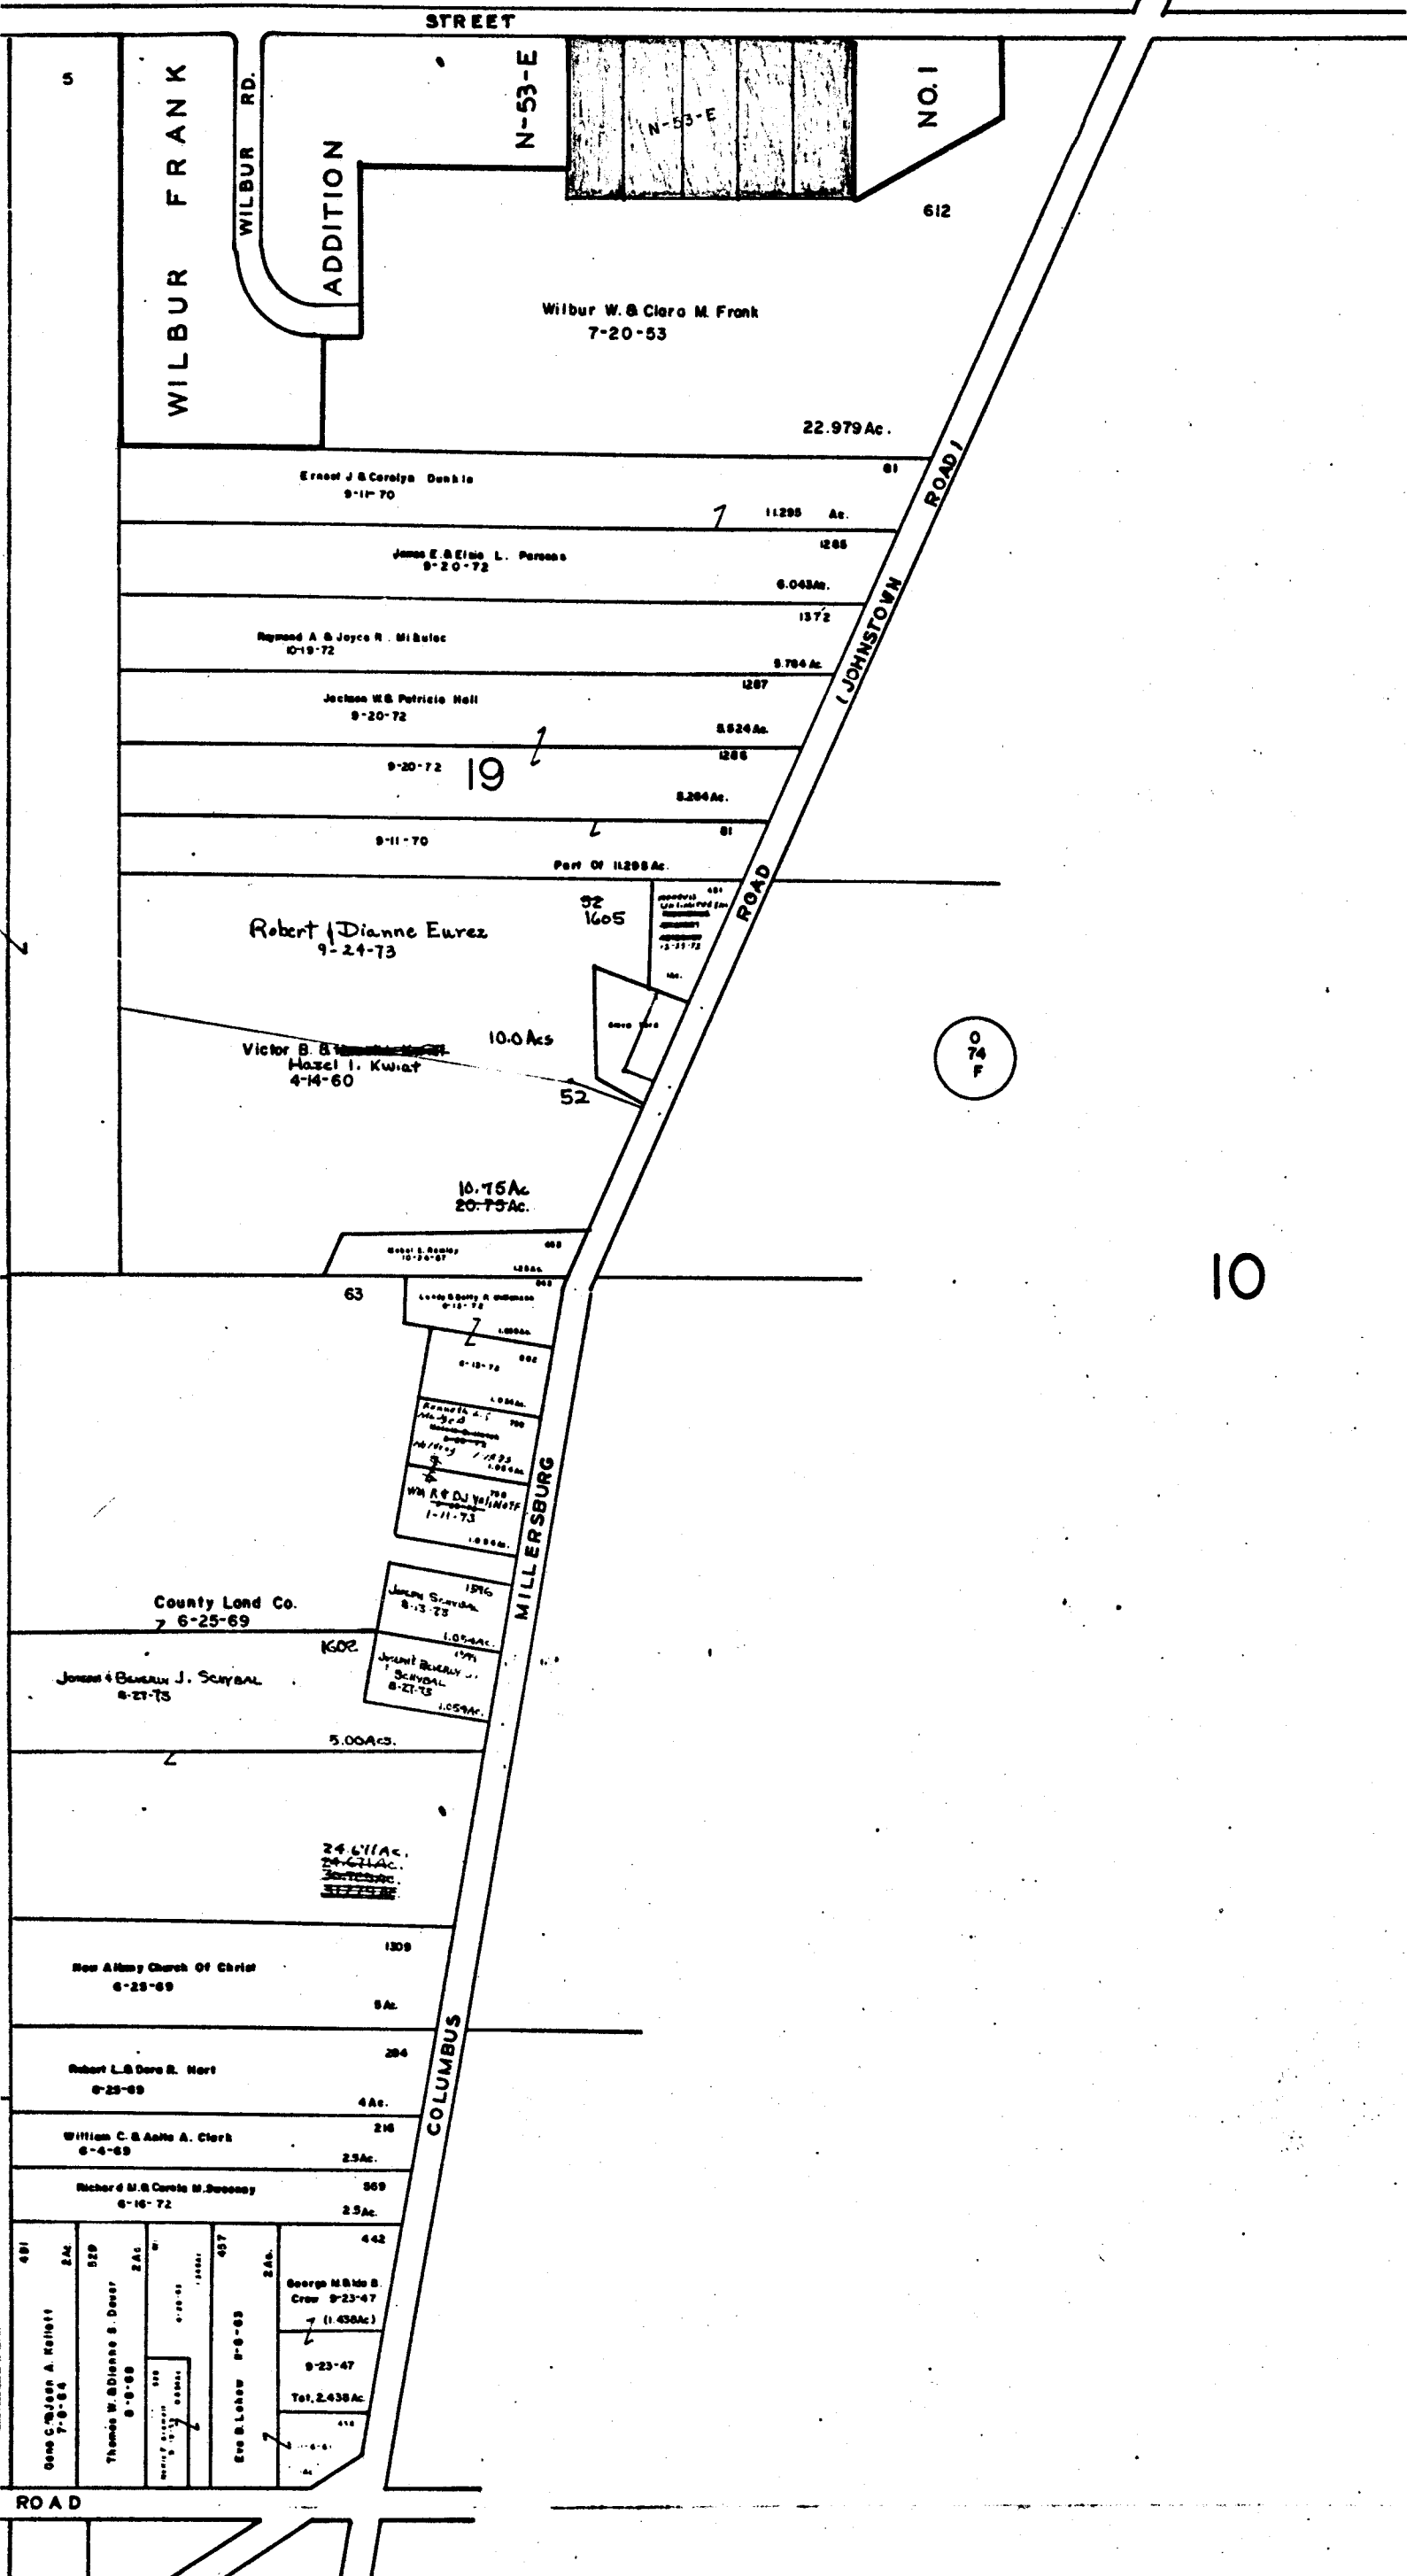

10

074 F

0-74-E

786