


0  
75  
D

T W P

J 40

B L E N D O N

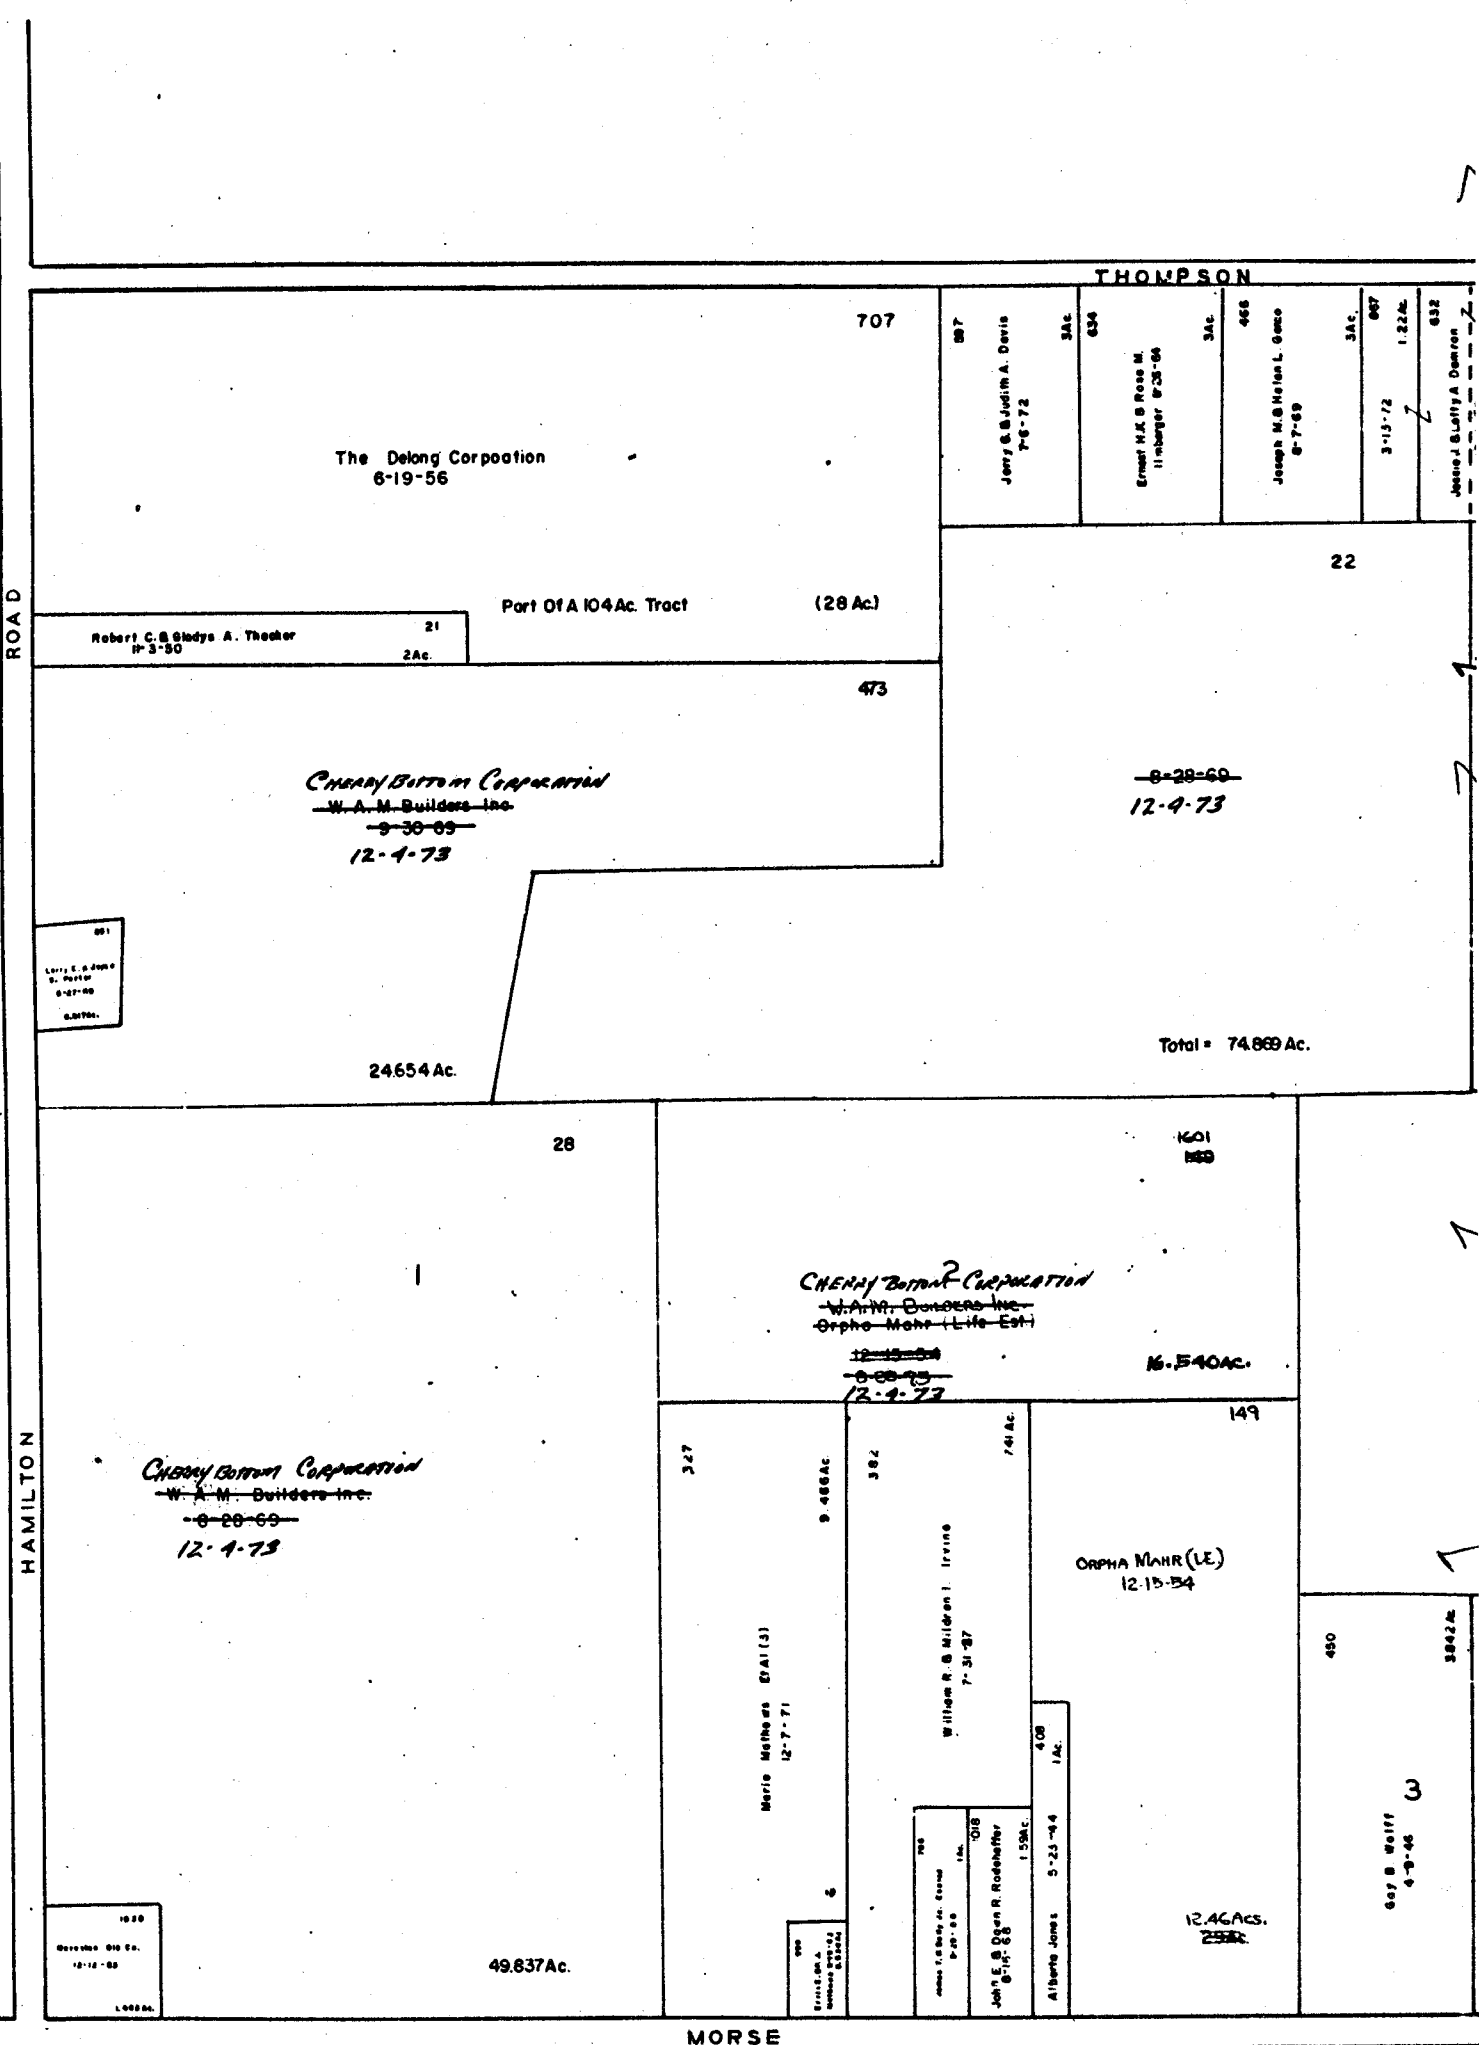


J E F F E R S O N

0-75-G

PLAIN TWP  
R.16 TWP.2

SCALE 1"=200'  
TAXING DISTRICTS  
PLAIN

0  
75  
E

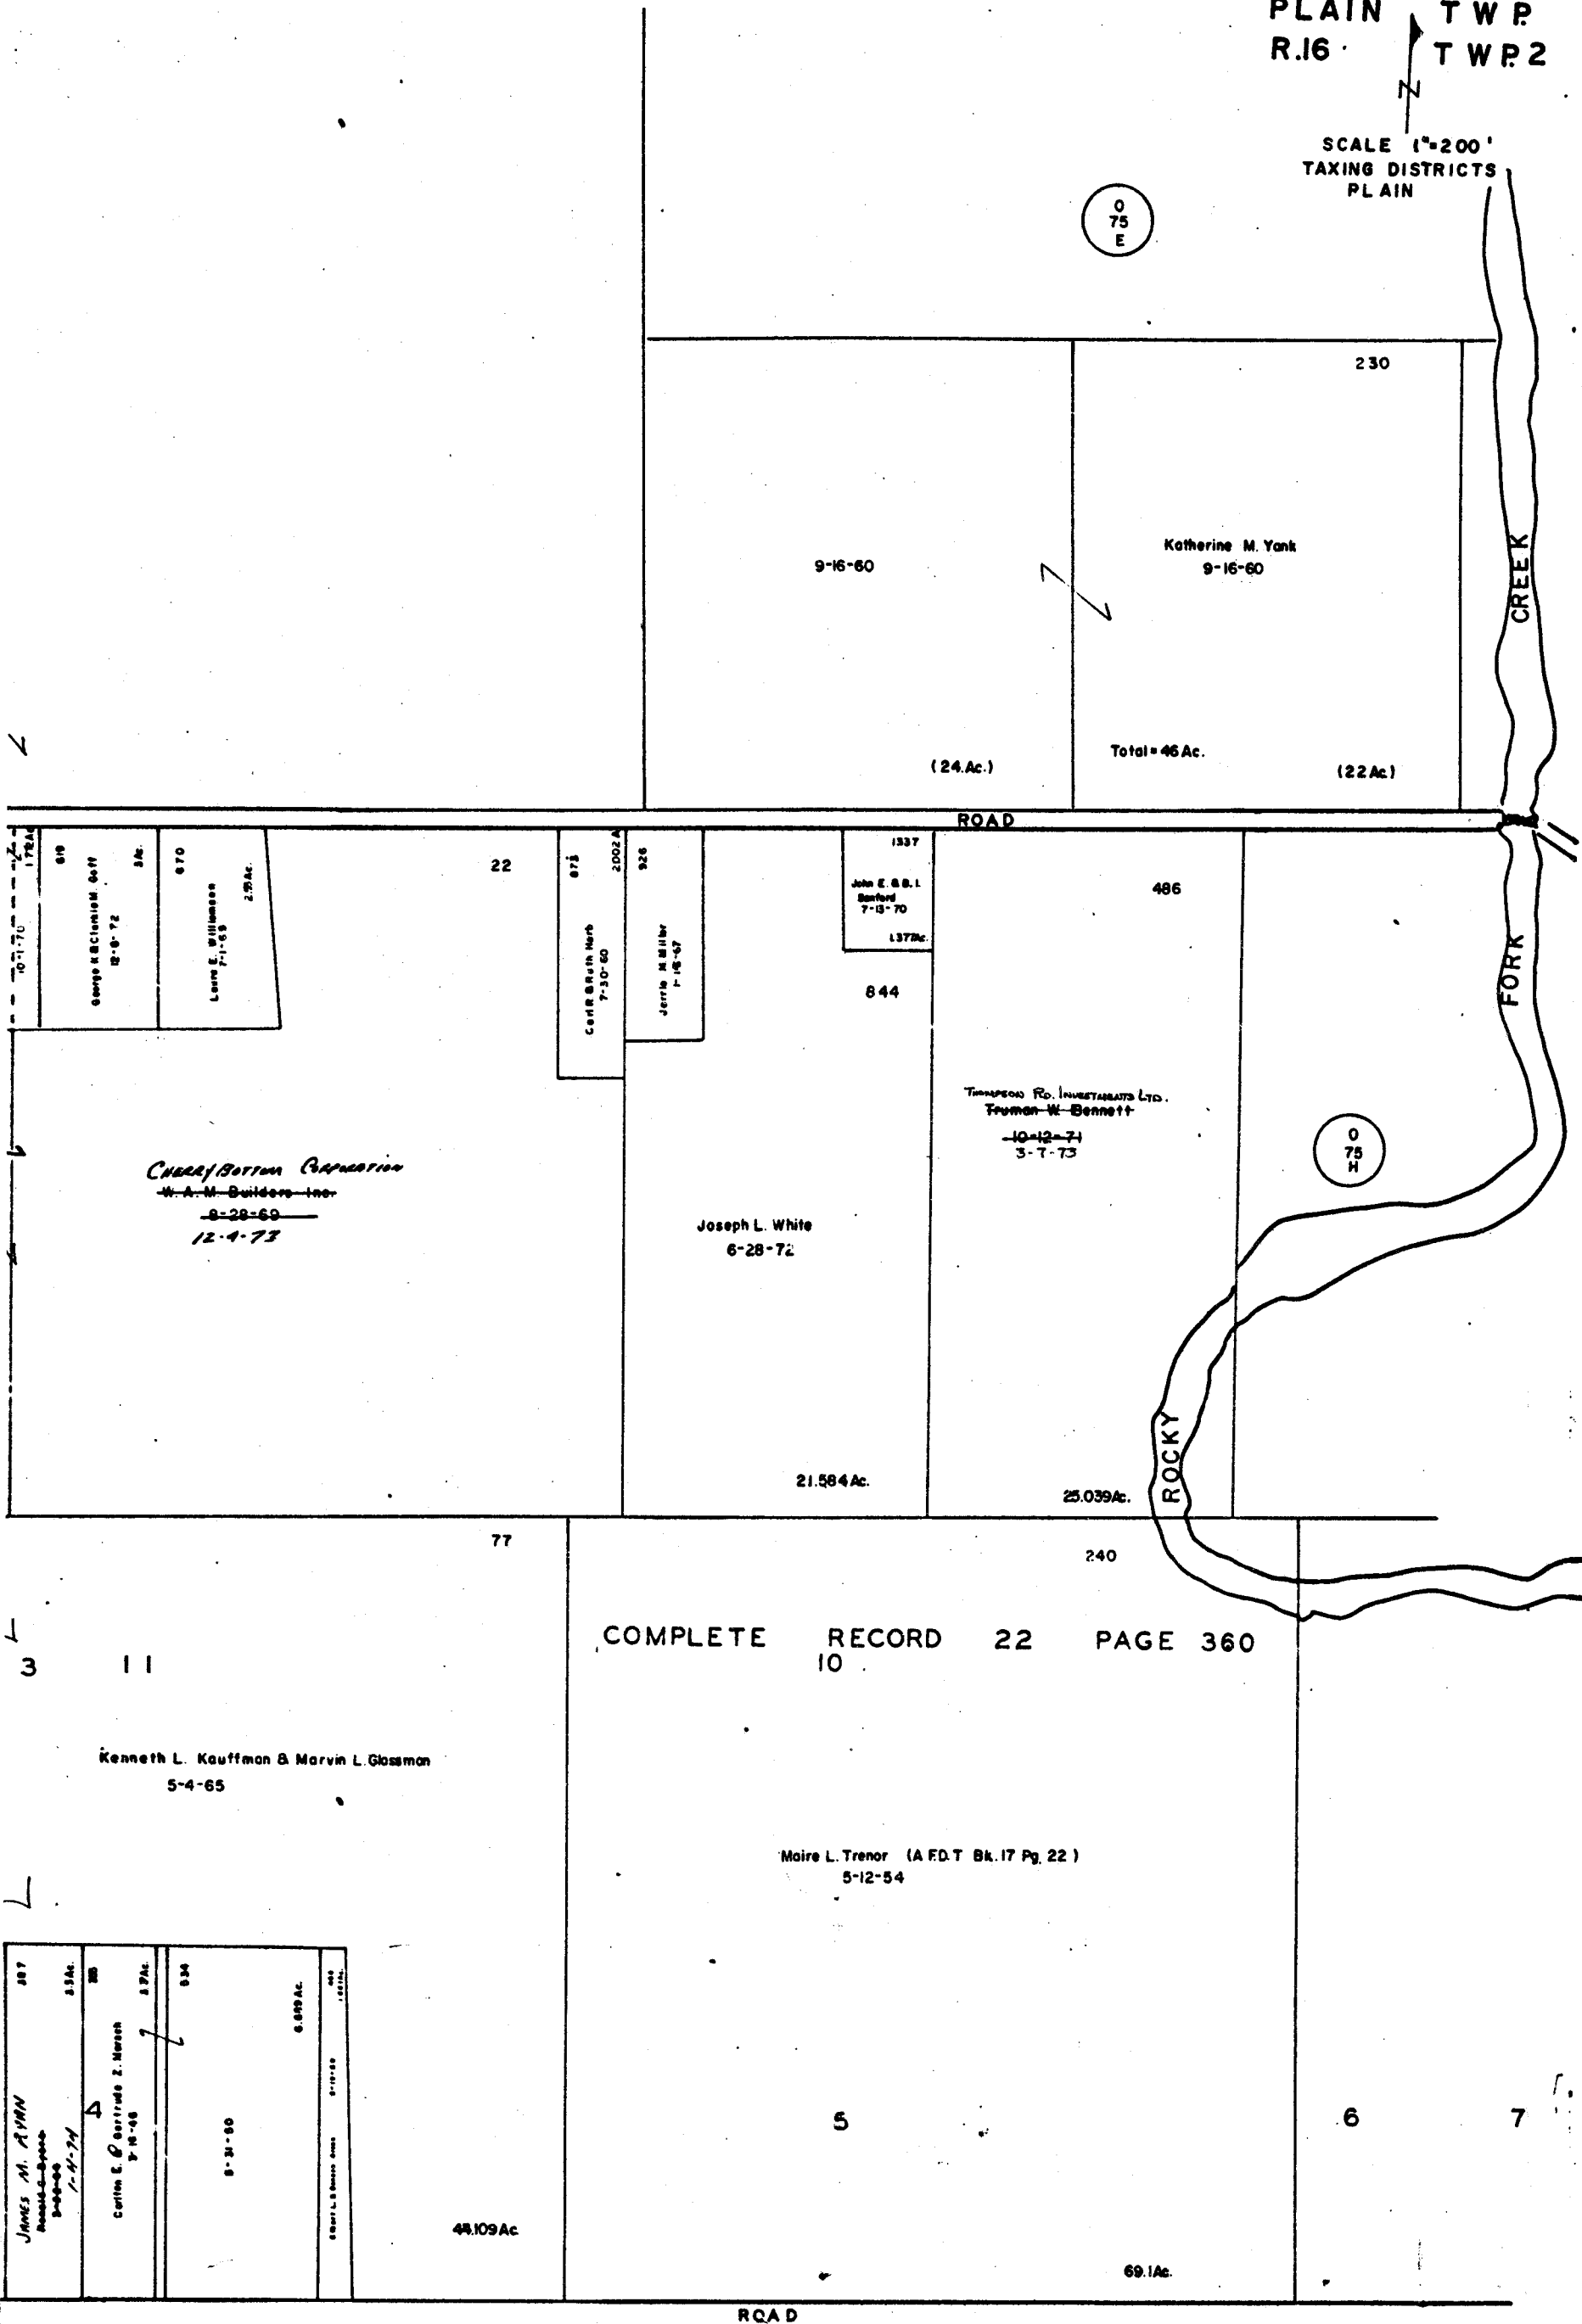

0  
37

T W P

0-75-G

3810
