


0
74

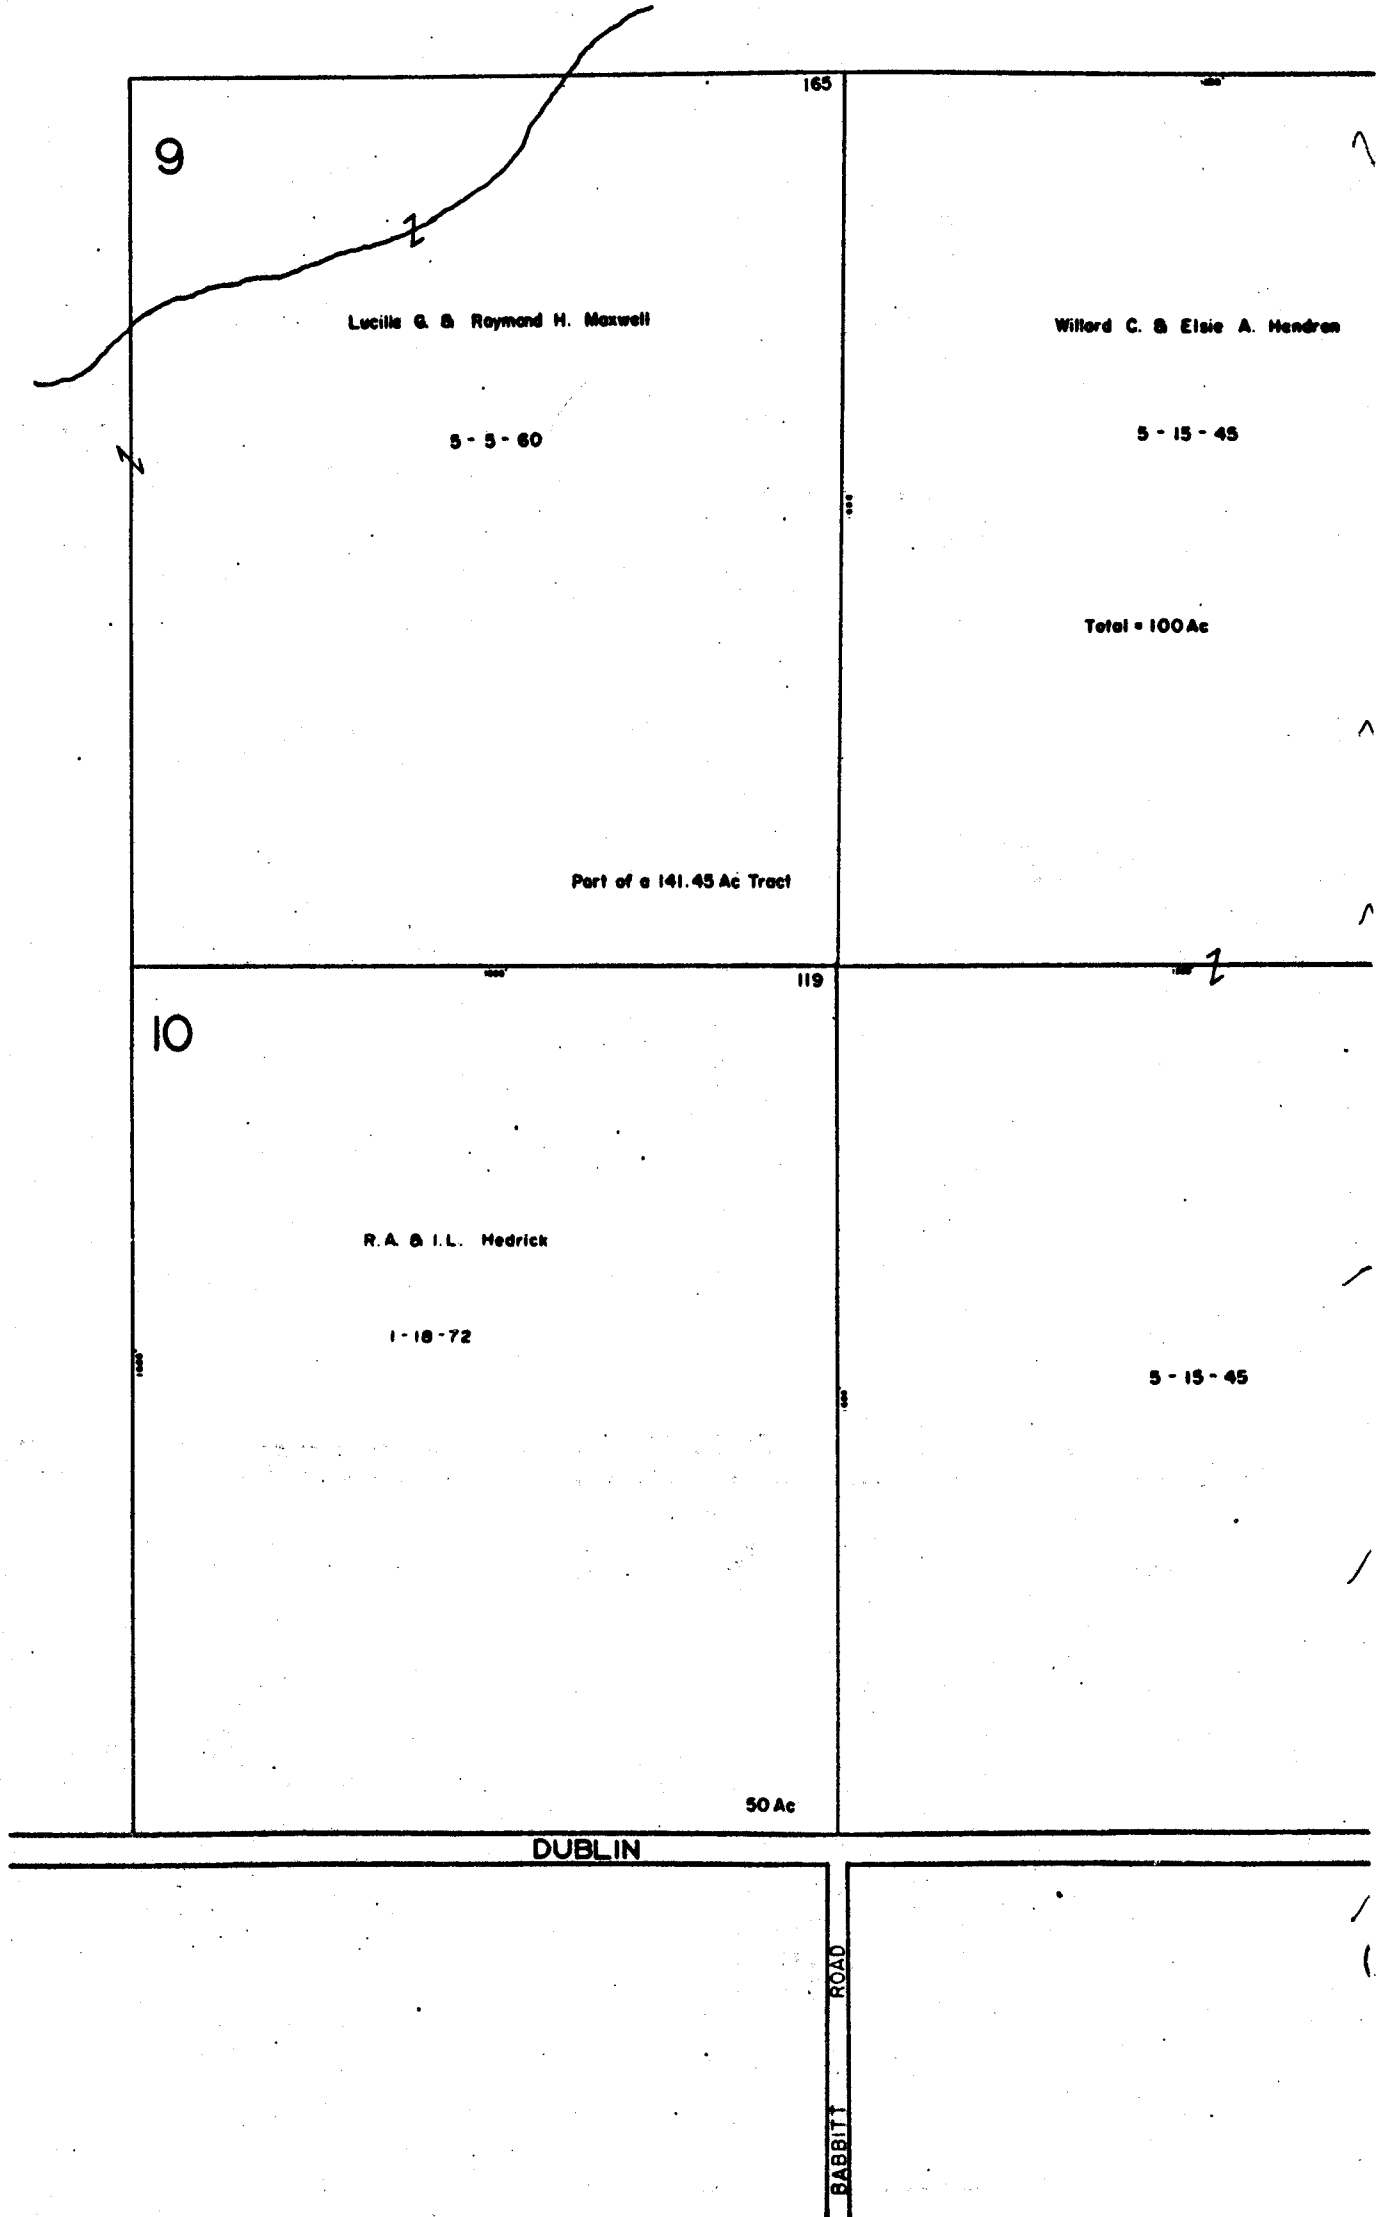


O-76-C

PLAIN TWP.
R.16 TWP.2



SCALE 1" = 200'
TAXING DISTRICT
PLAIN TWP.

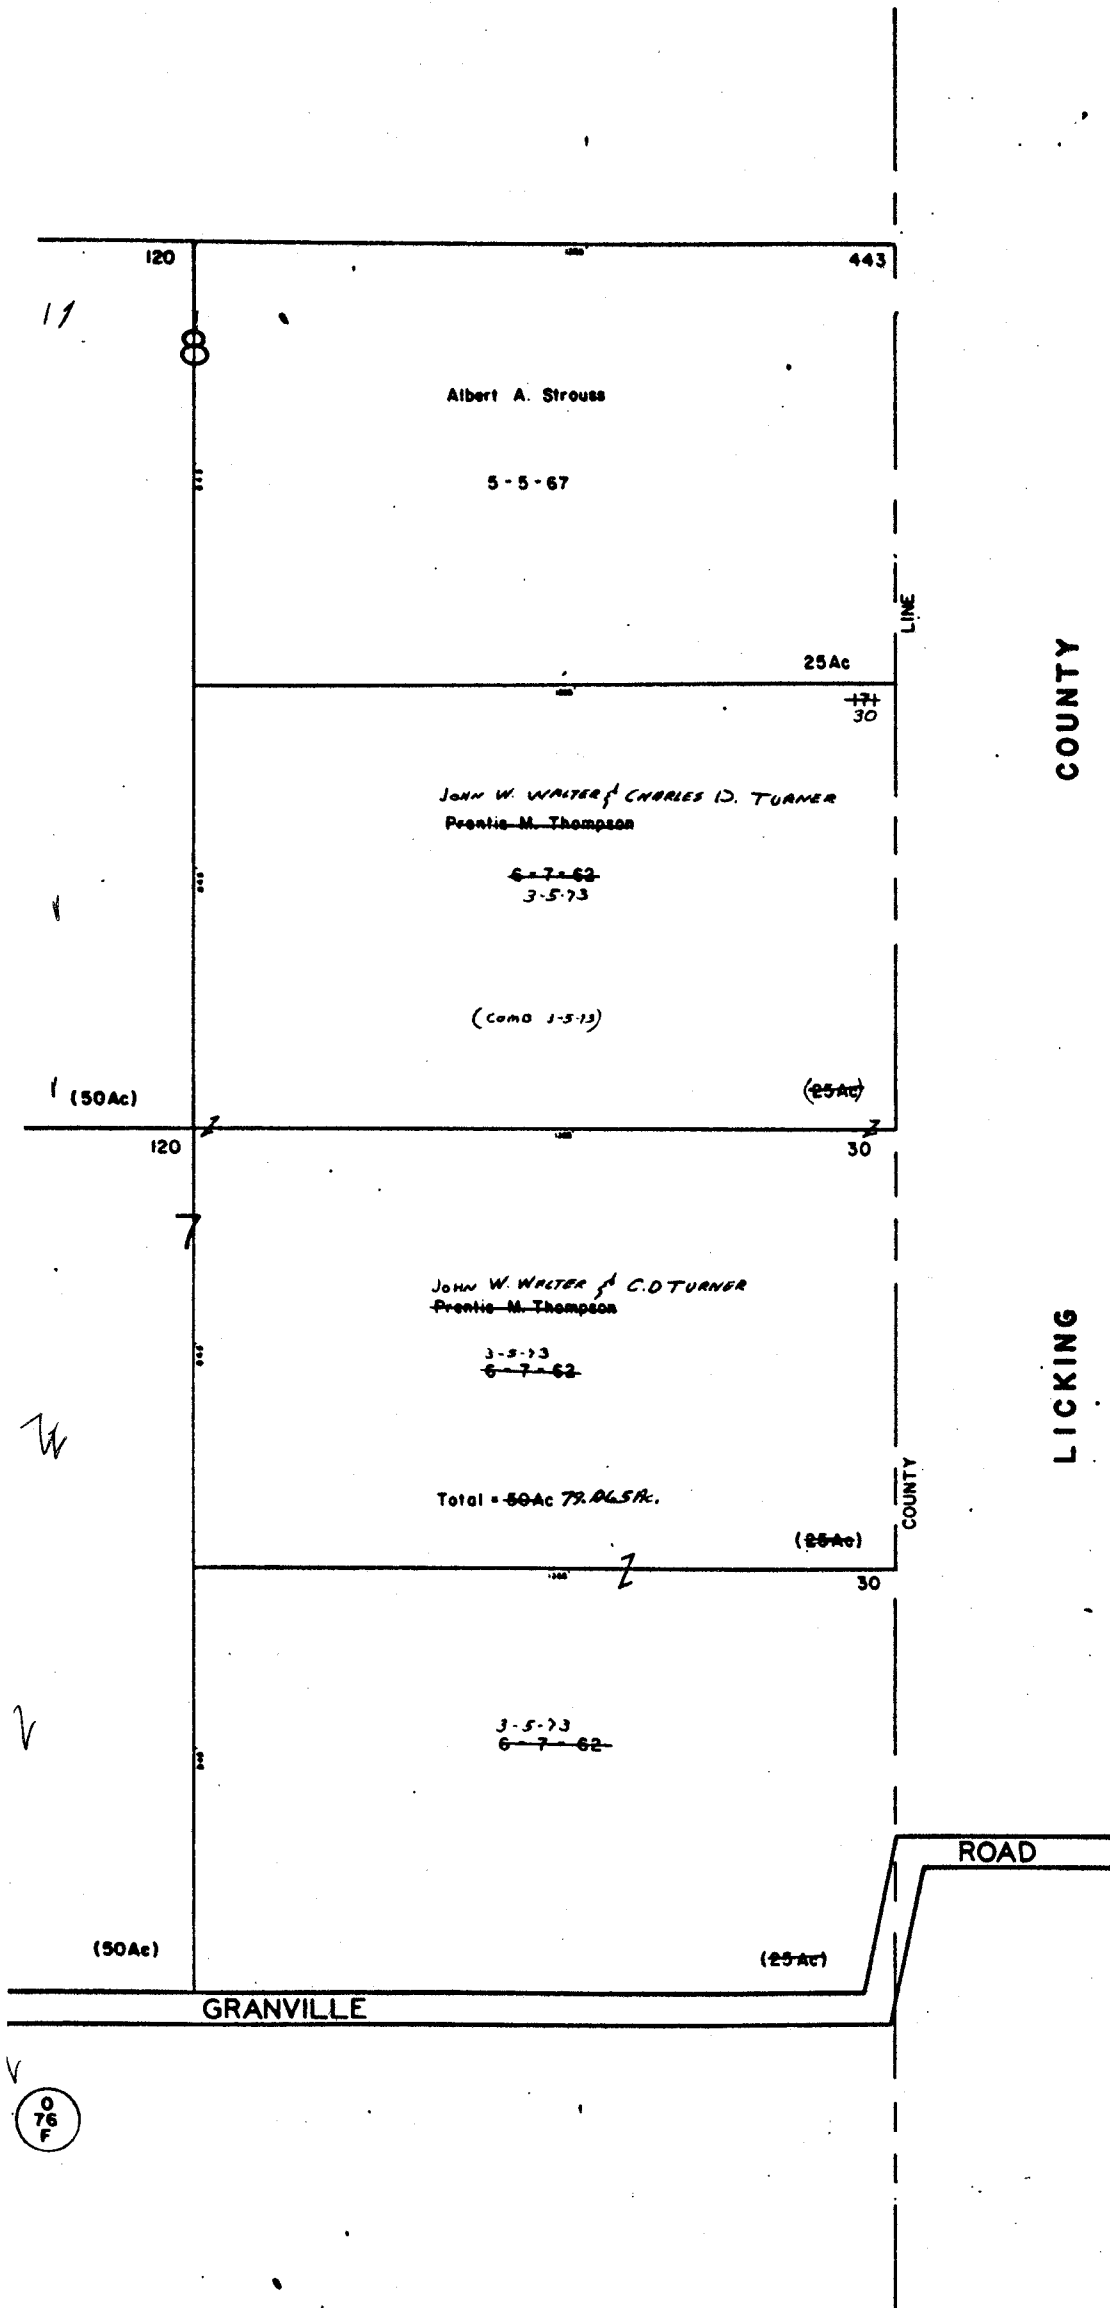

3822
O-76-C

DATE	1974
BY	...
...	...