


0
76
B

0
76
B

0
76
B

DUBLIN

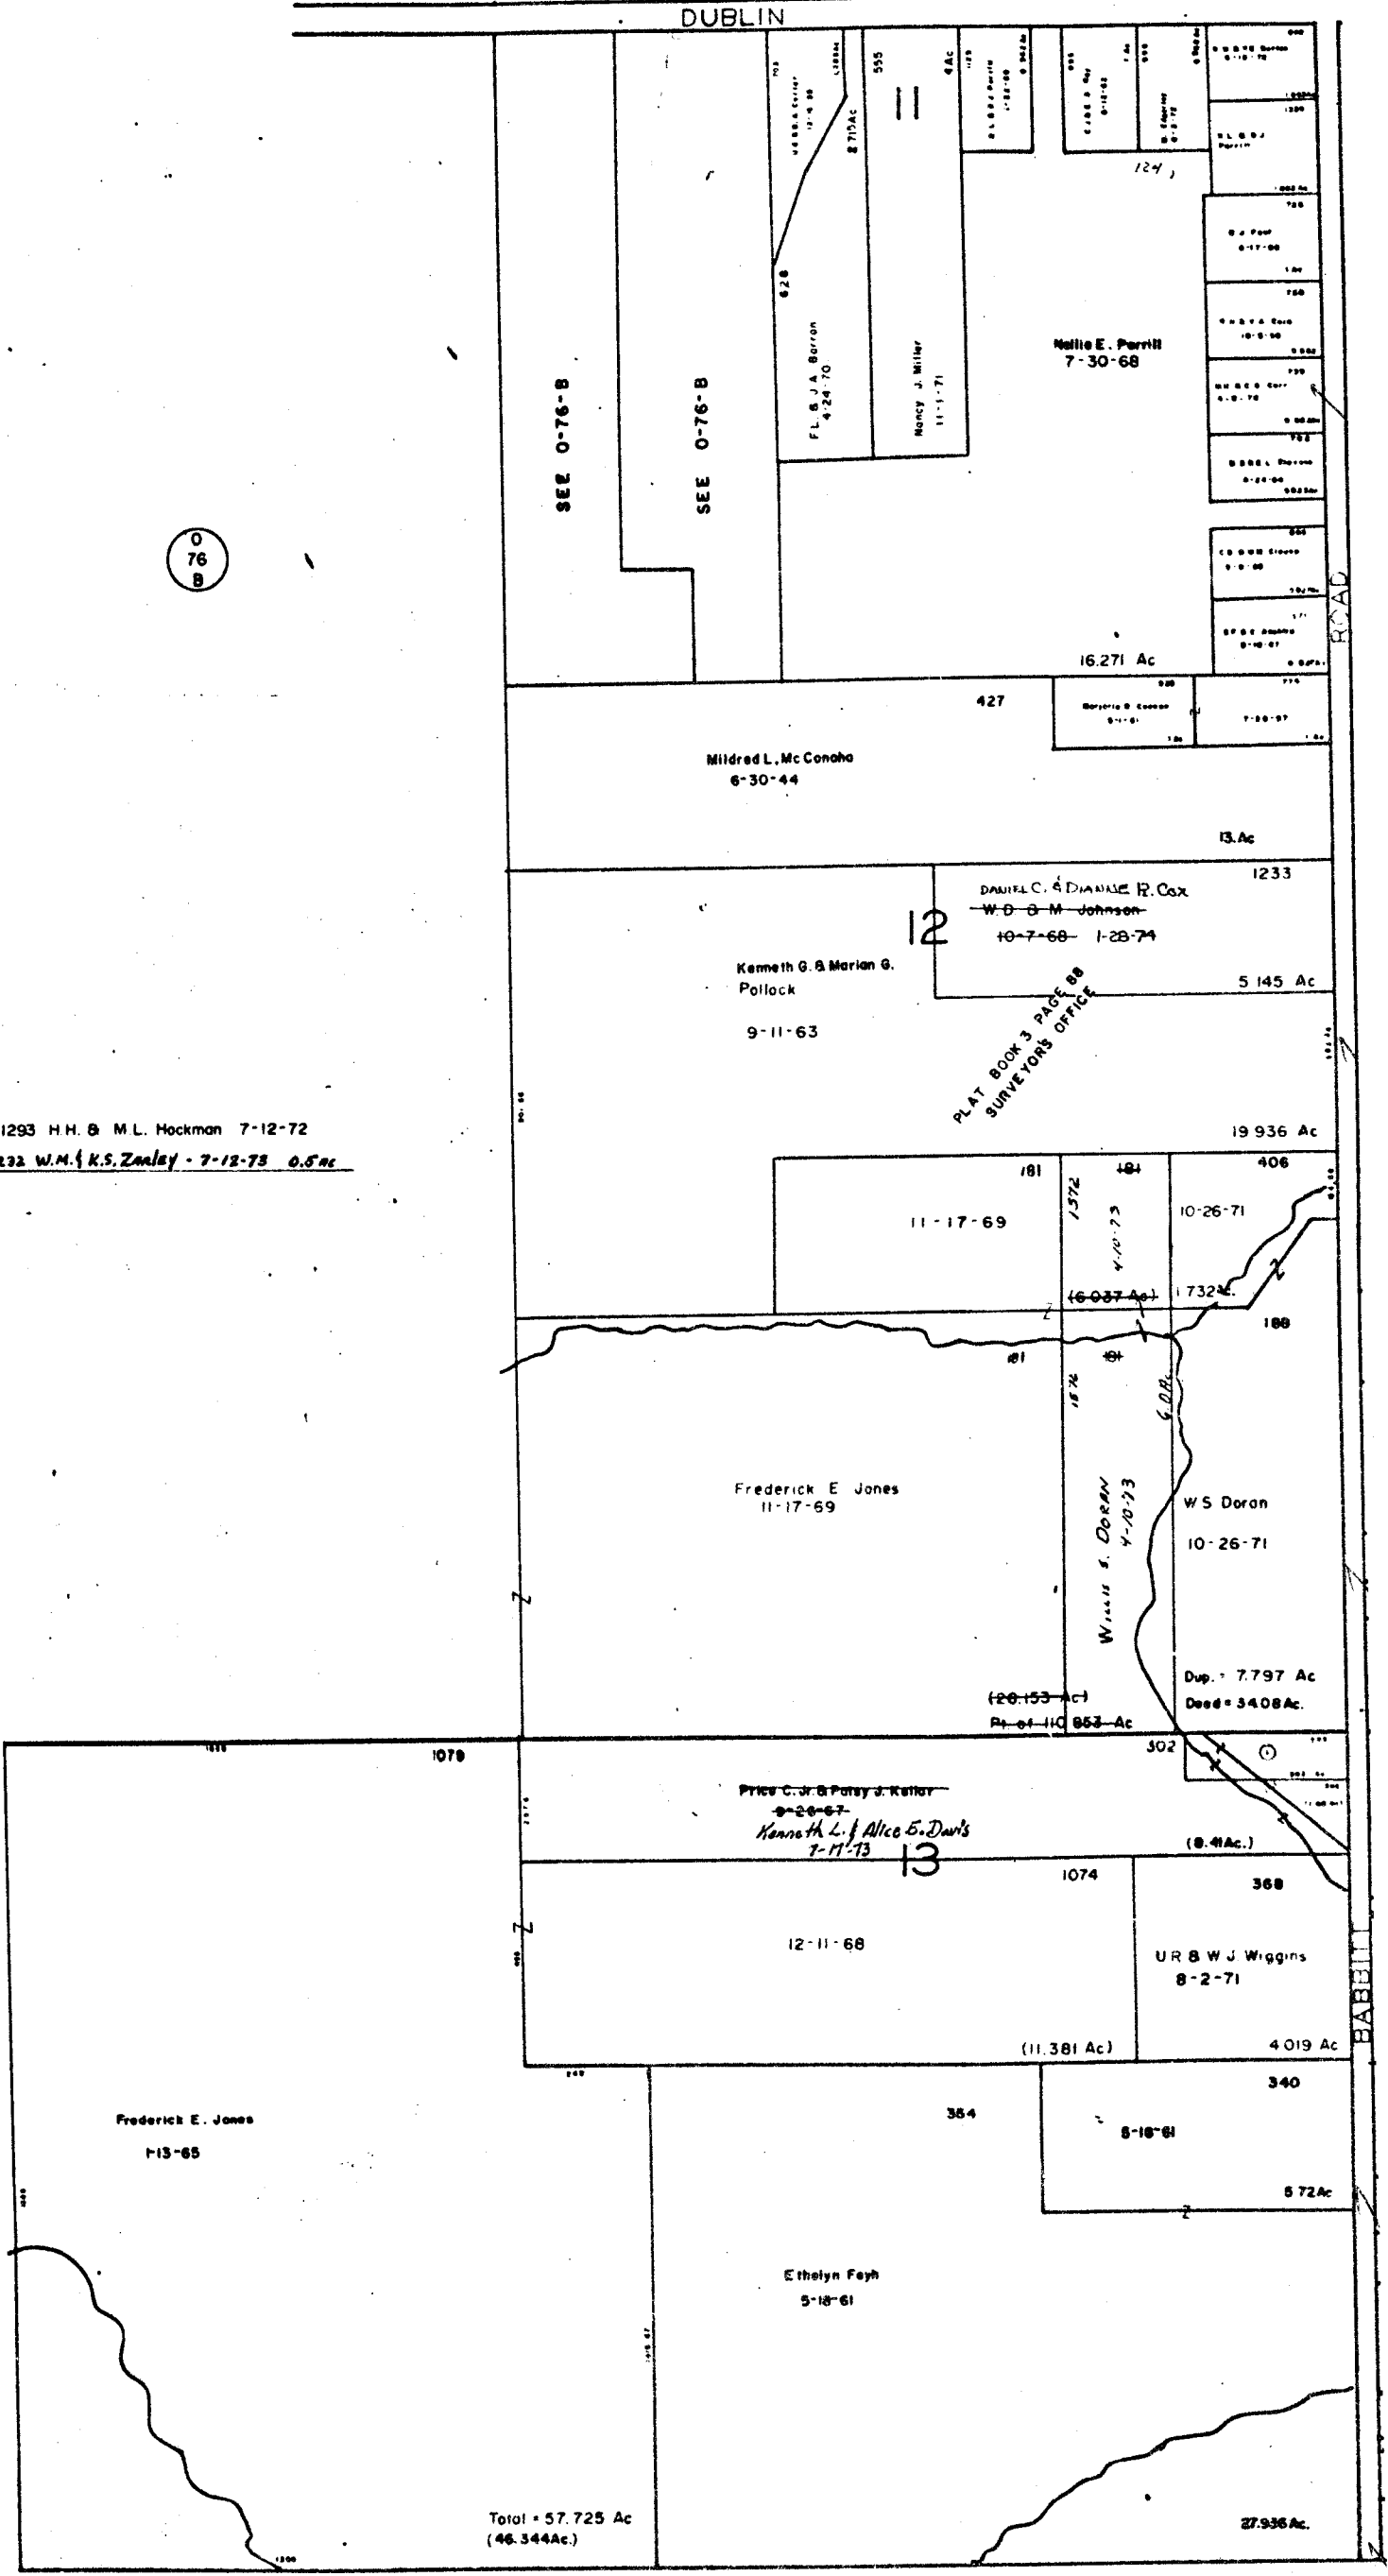

① 1293 H.H. & M.L. Hockman 7-12-72
 ② 1232 W.M. & K.S. Zimley - 7-12-73 0.5 ac


0
76
C

0-76-F

PLAIN TWP
R.16 TWP.2



SCALE 1"=200'
TAXING DISTRICTS
PLAIN

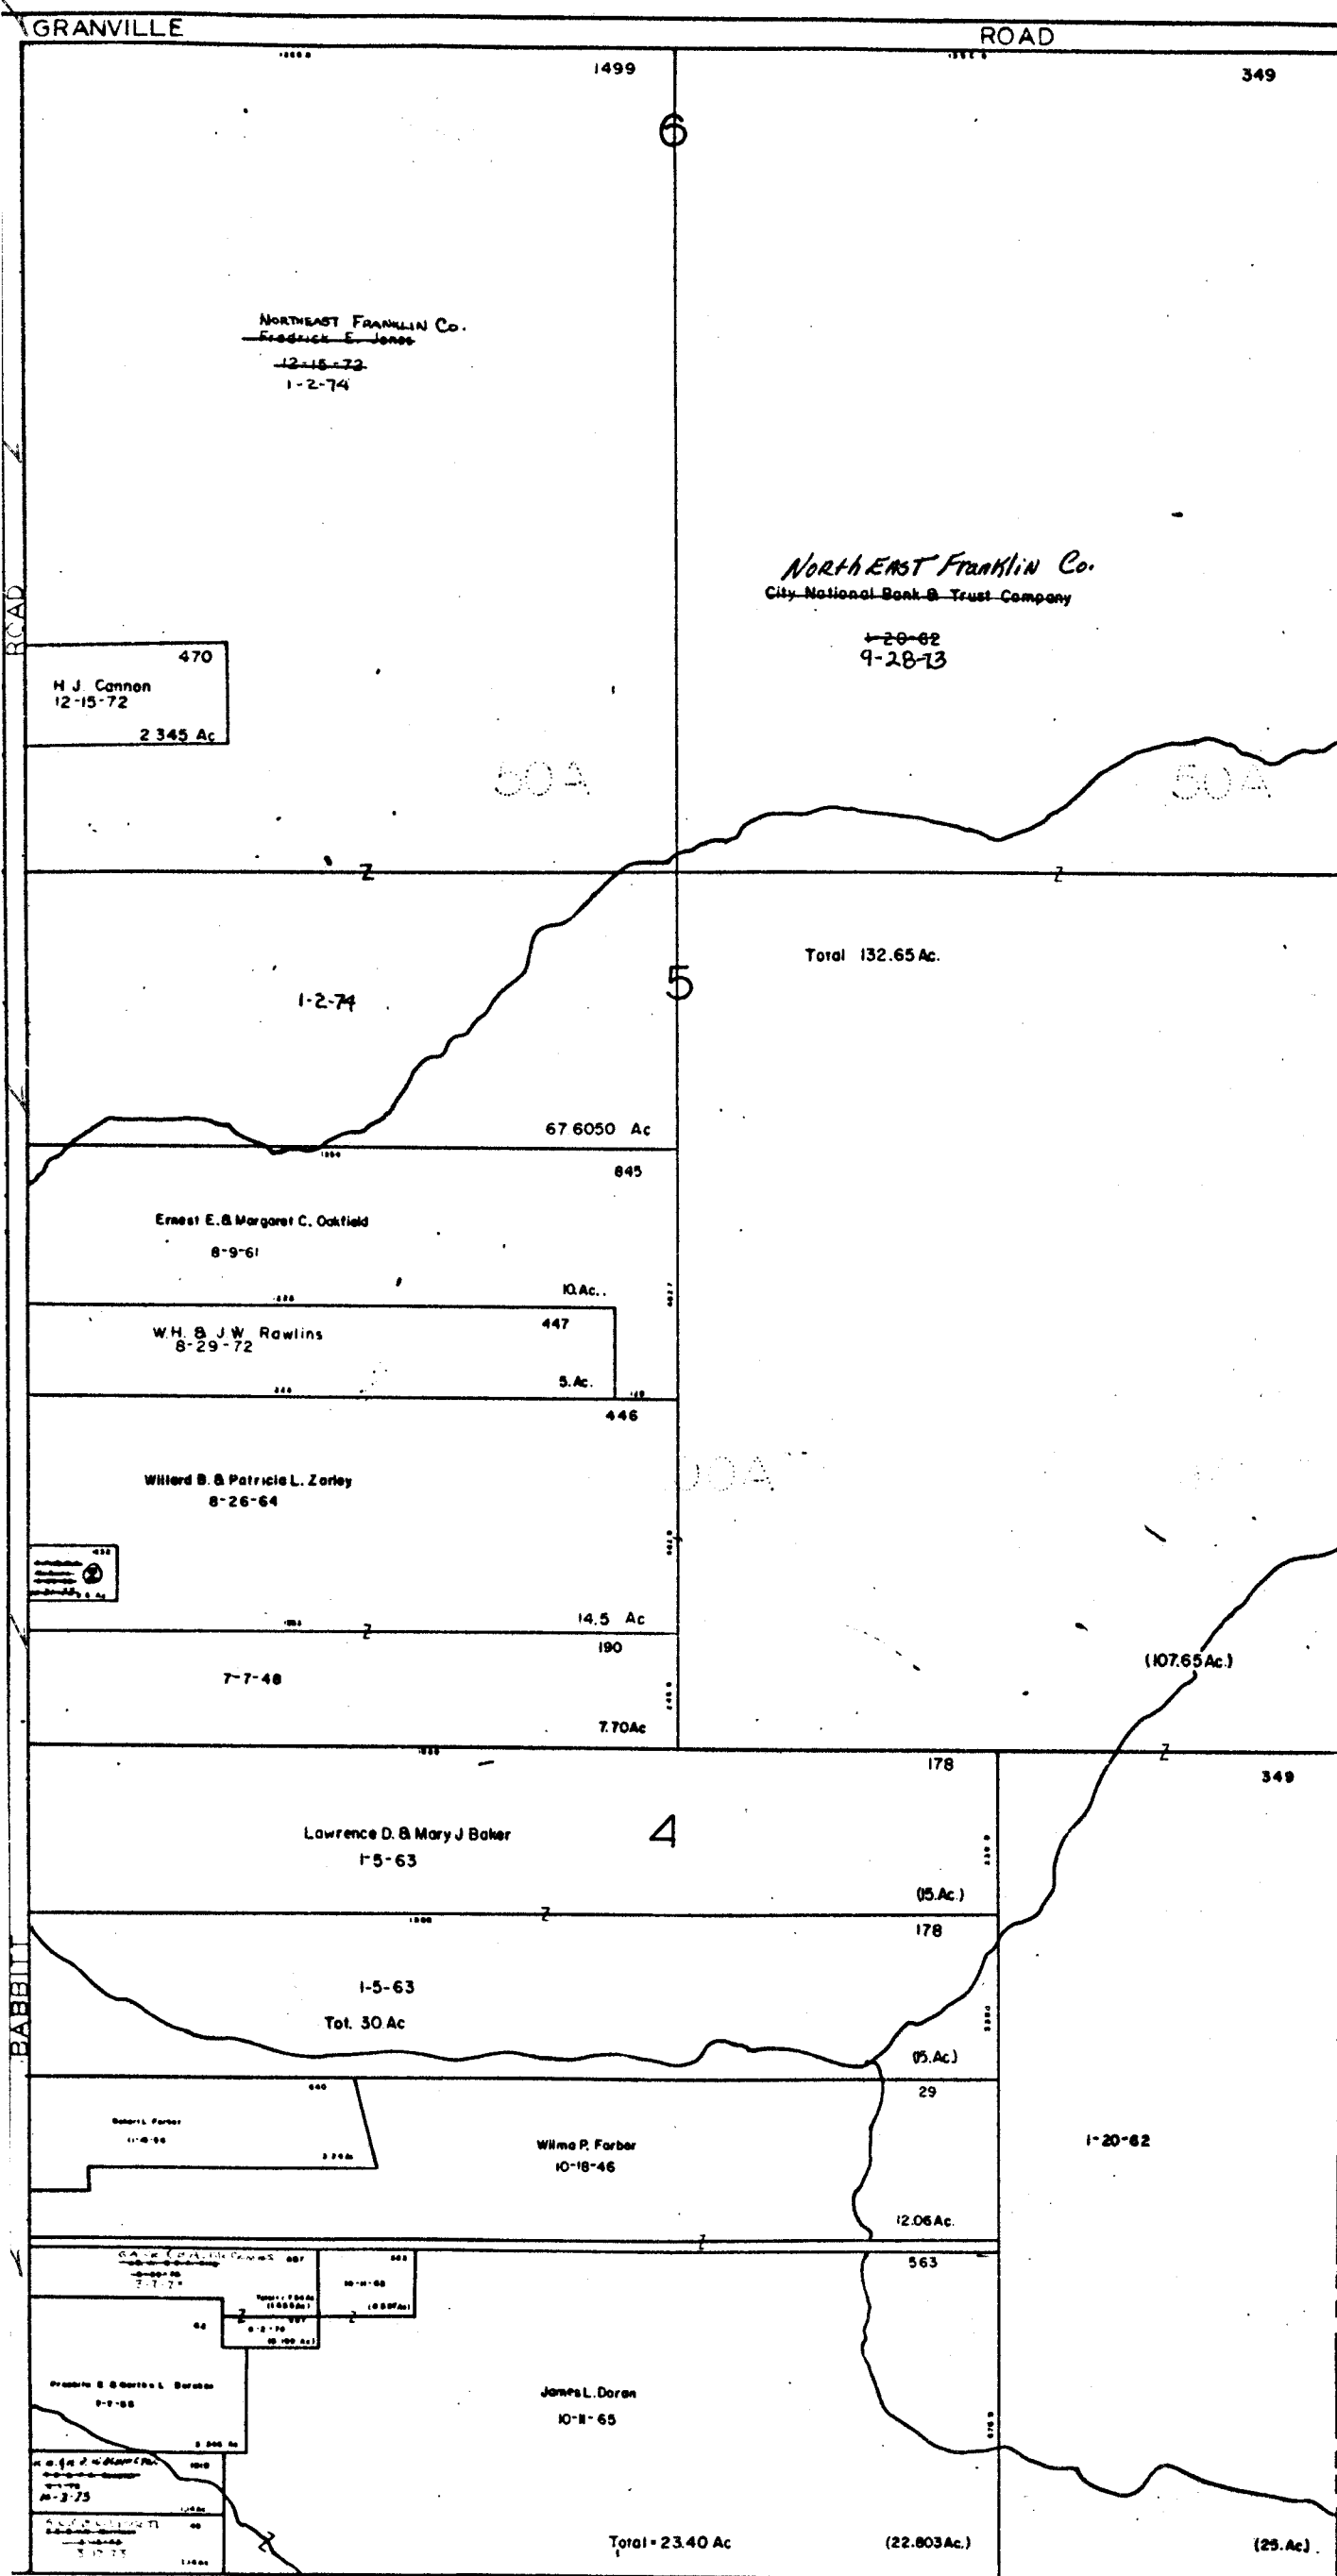

0
76
J

3828

0-76-F