


0
76
E

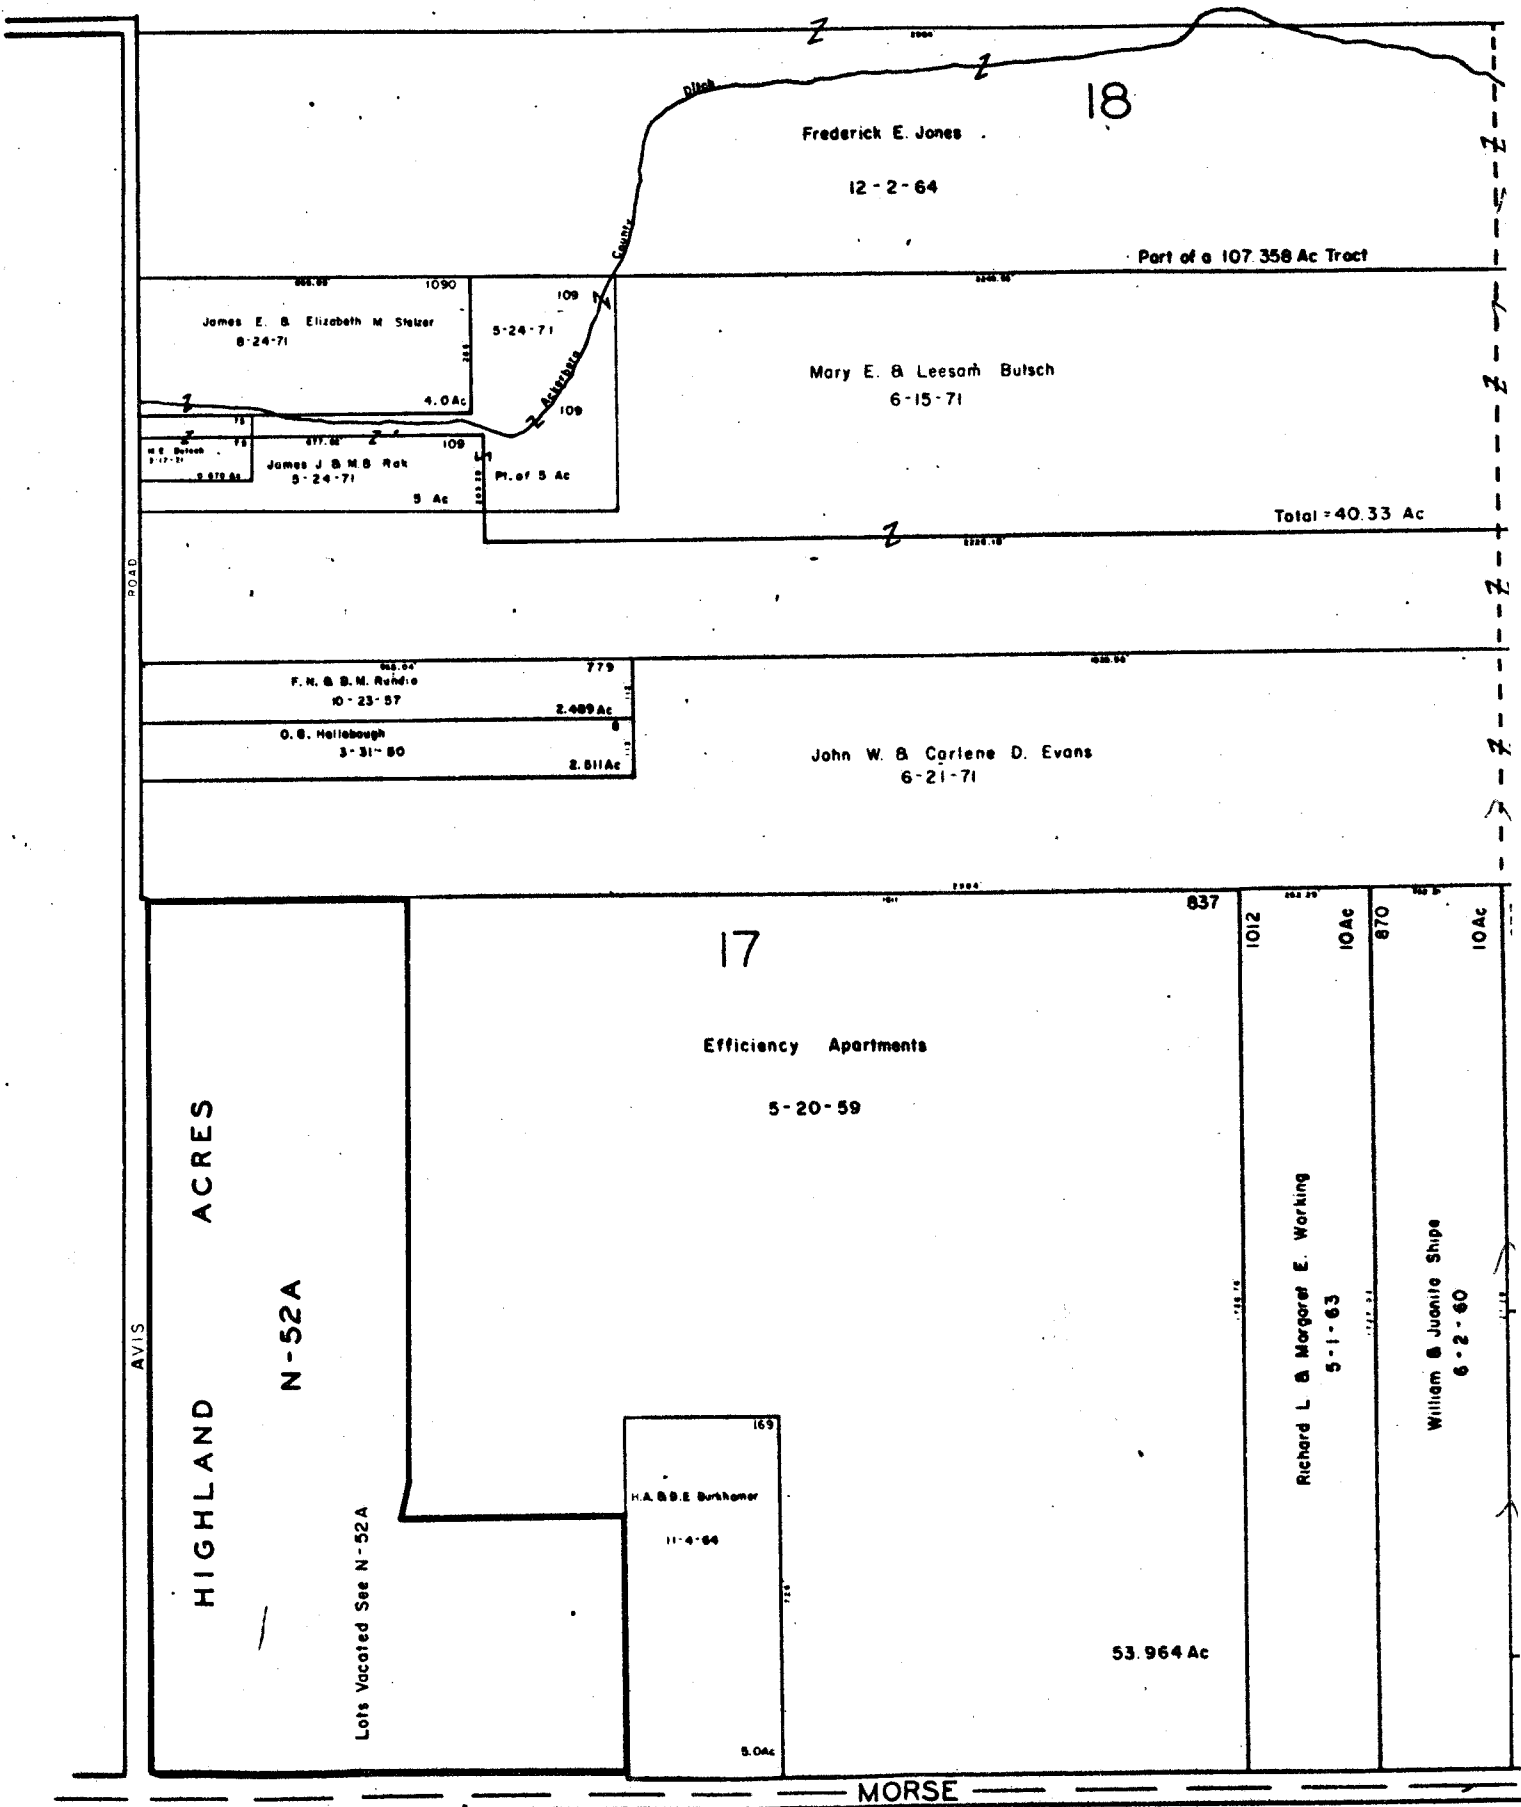

0
76
G

0
38

JEFFERSON


O-76-H

PLAIN TWP.
R.16 TWP.2



SCALE 1" = 200'
TAXING DISTRICT
PLAIN TWP.

① 297- Malaga R. OYSTER 10-29-73 0.850 ac.

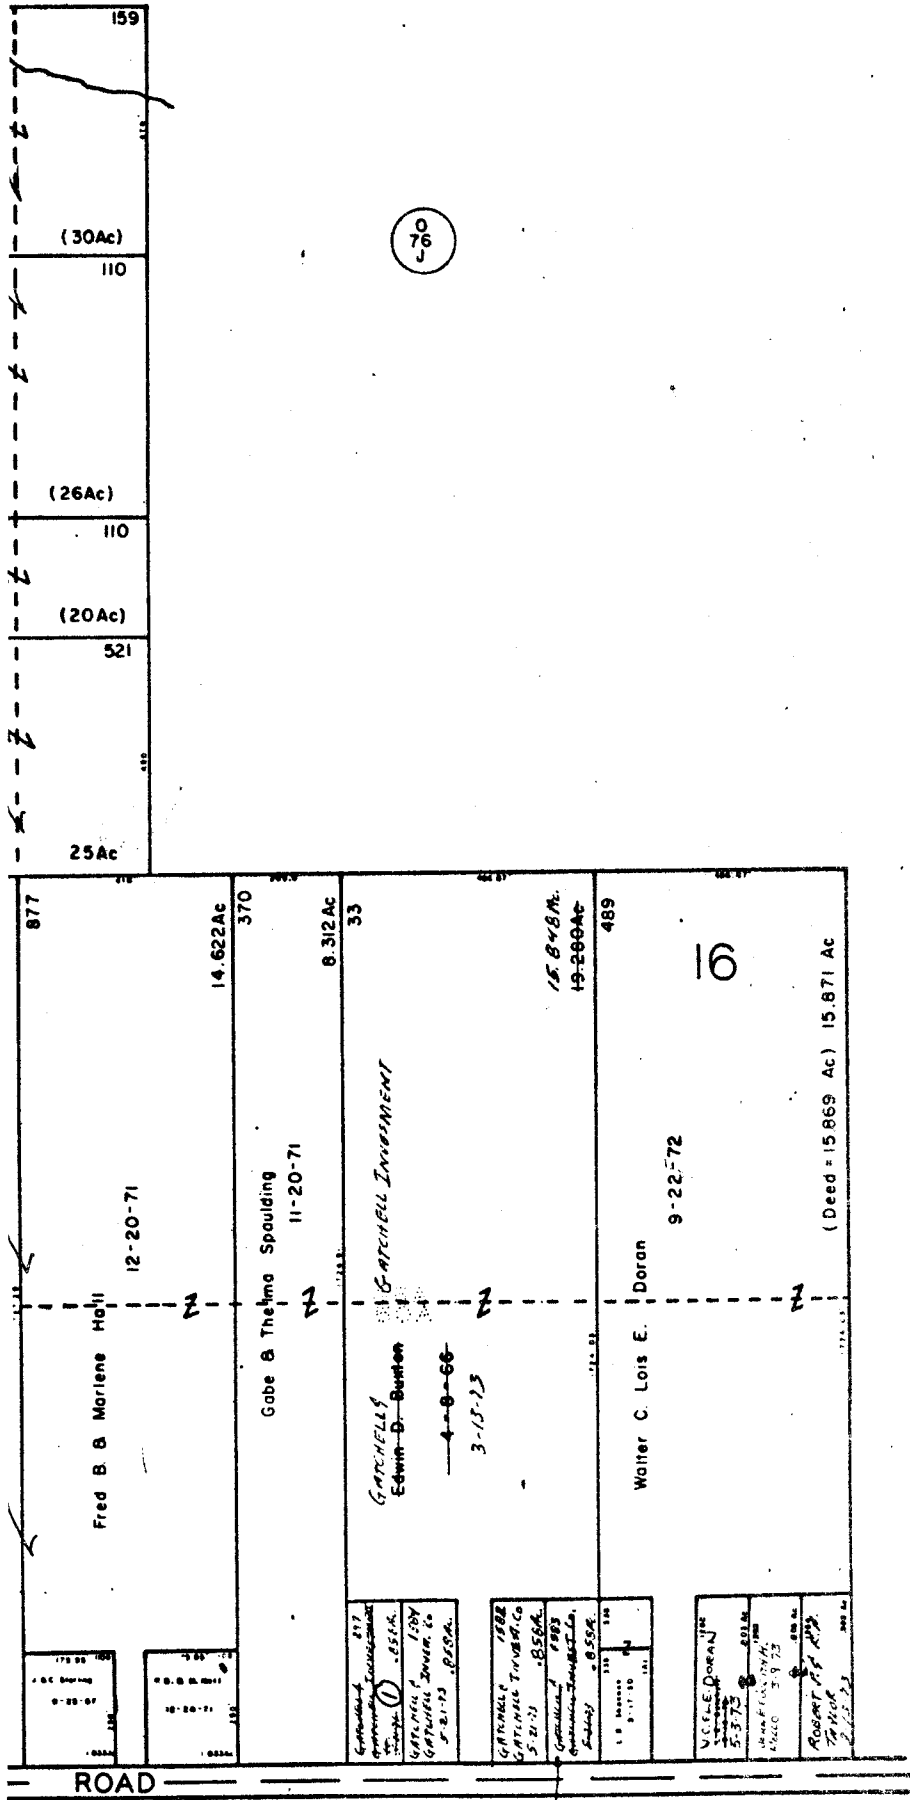

TWP.

Charles D. J. Wood
Martha Wood
9-24-10

3832

O-76-H

