

B R O W N T W P.

0
12

••577

70066

Catherine A. Wehr
6-11-64

22.45 Ac

AMITY

••576

E. A. Erwin (L & 1/2) & Ohio National Bank Tr. (Fee 1/2)
5-3-73

0
88
C

24.22 Ac.

P E C S T R R

18

6214

Bridge

City National Bank & Trust Co. Tr. et al (3)
11-2-73

0
88
C

2887

24
F. A. Hanson
11-22-58
1.66 Ac.

180.3 Ac.

147699


(NATIONAL ROAD)

PRAIRIE TWP.



VMS
 SCALE 1"=200'
 TAXING DISTRICTS
 PRAIRIE TWP.
 •• PRAIRIE TWP. - SCIOTO DARBY SD

1	5019	H. B. M. R. Bege	11-8-64	.661 Ac.
2	5014	Edward L. Young	8-24-64	.661 Ac.
3	5015	Glayde G. Coughl	8-21-73	.661 Ac.
4	5013	C.F. & S.A. Coughl	7-2-73	.661 Ac.
5	5182	R.M. & M.S. Cline	9-29-67	.669 Ac.
6	5183	R.M. & M.S. Cline	9-29-67	.669 Ac.
7	5114	P.V. & M.I. Stout	8-25-73	1.378 Ac.
8	5172	D & L Development Inc	8-9-73	.669 Ac.
9	5173	Jo Anne G. Georiton	8-10-72	.669 Ac.
10	5174	L.E. & C.J. Rood	8-17-72	.669 Ac.
11	5175	Carolyn & Patricia Rood Mildred Georiton	2-1-74 8-9-67	.669 Ac.
12	5093	G.M. George	3-12-69	.669 Ac.
13	4288	G.A. & S.S. Wright	8-1-72	.768 Ac.
14	5199	G.M. George	3-12-69	.623 Ac.
15	5200	G.M. George	3-12-69	.620 Ac.
16	5159	George Petropoulos	12-22-66	.620 Ac.
17	5160	George Petropoulos	12-22-66	.620 Ac.
18	5161	J.C.V. Jr. & D.J. Richardson	10-18-67	.620 Ac.
19	5162	George Petropoulos	12-22-66	.666 Ac.

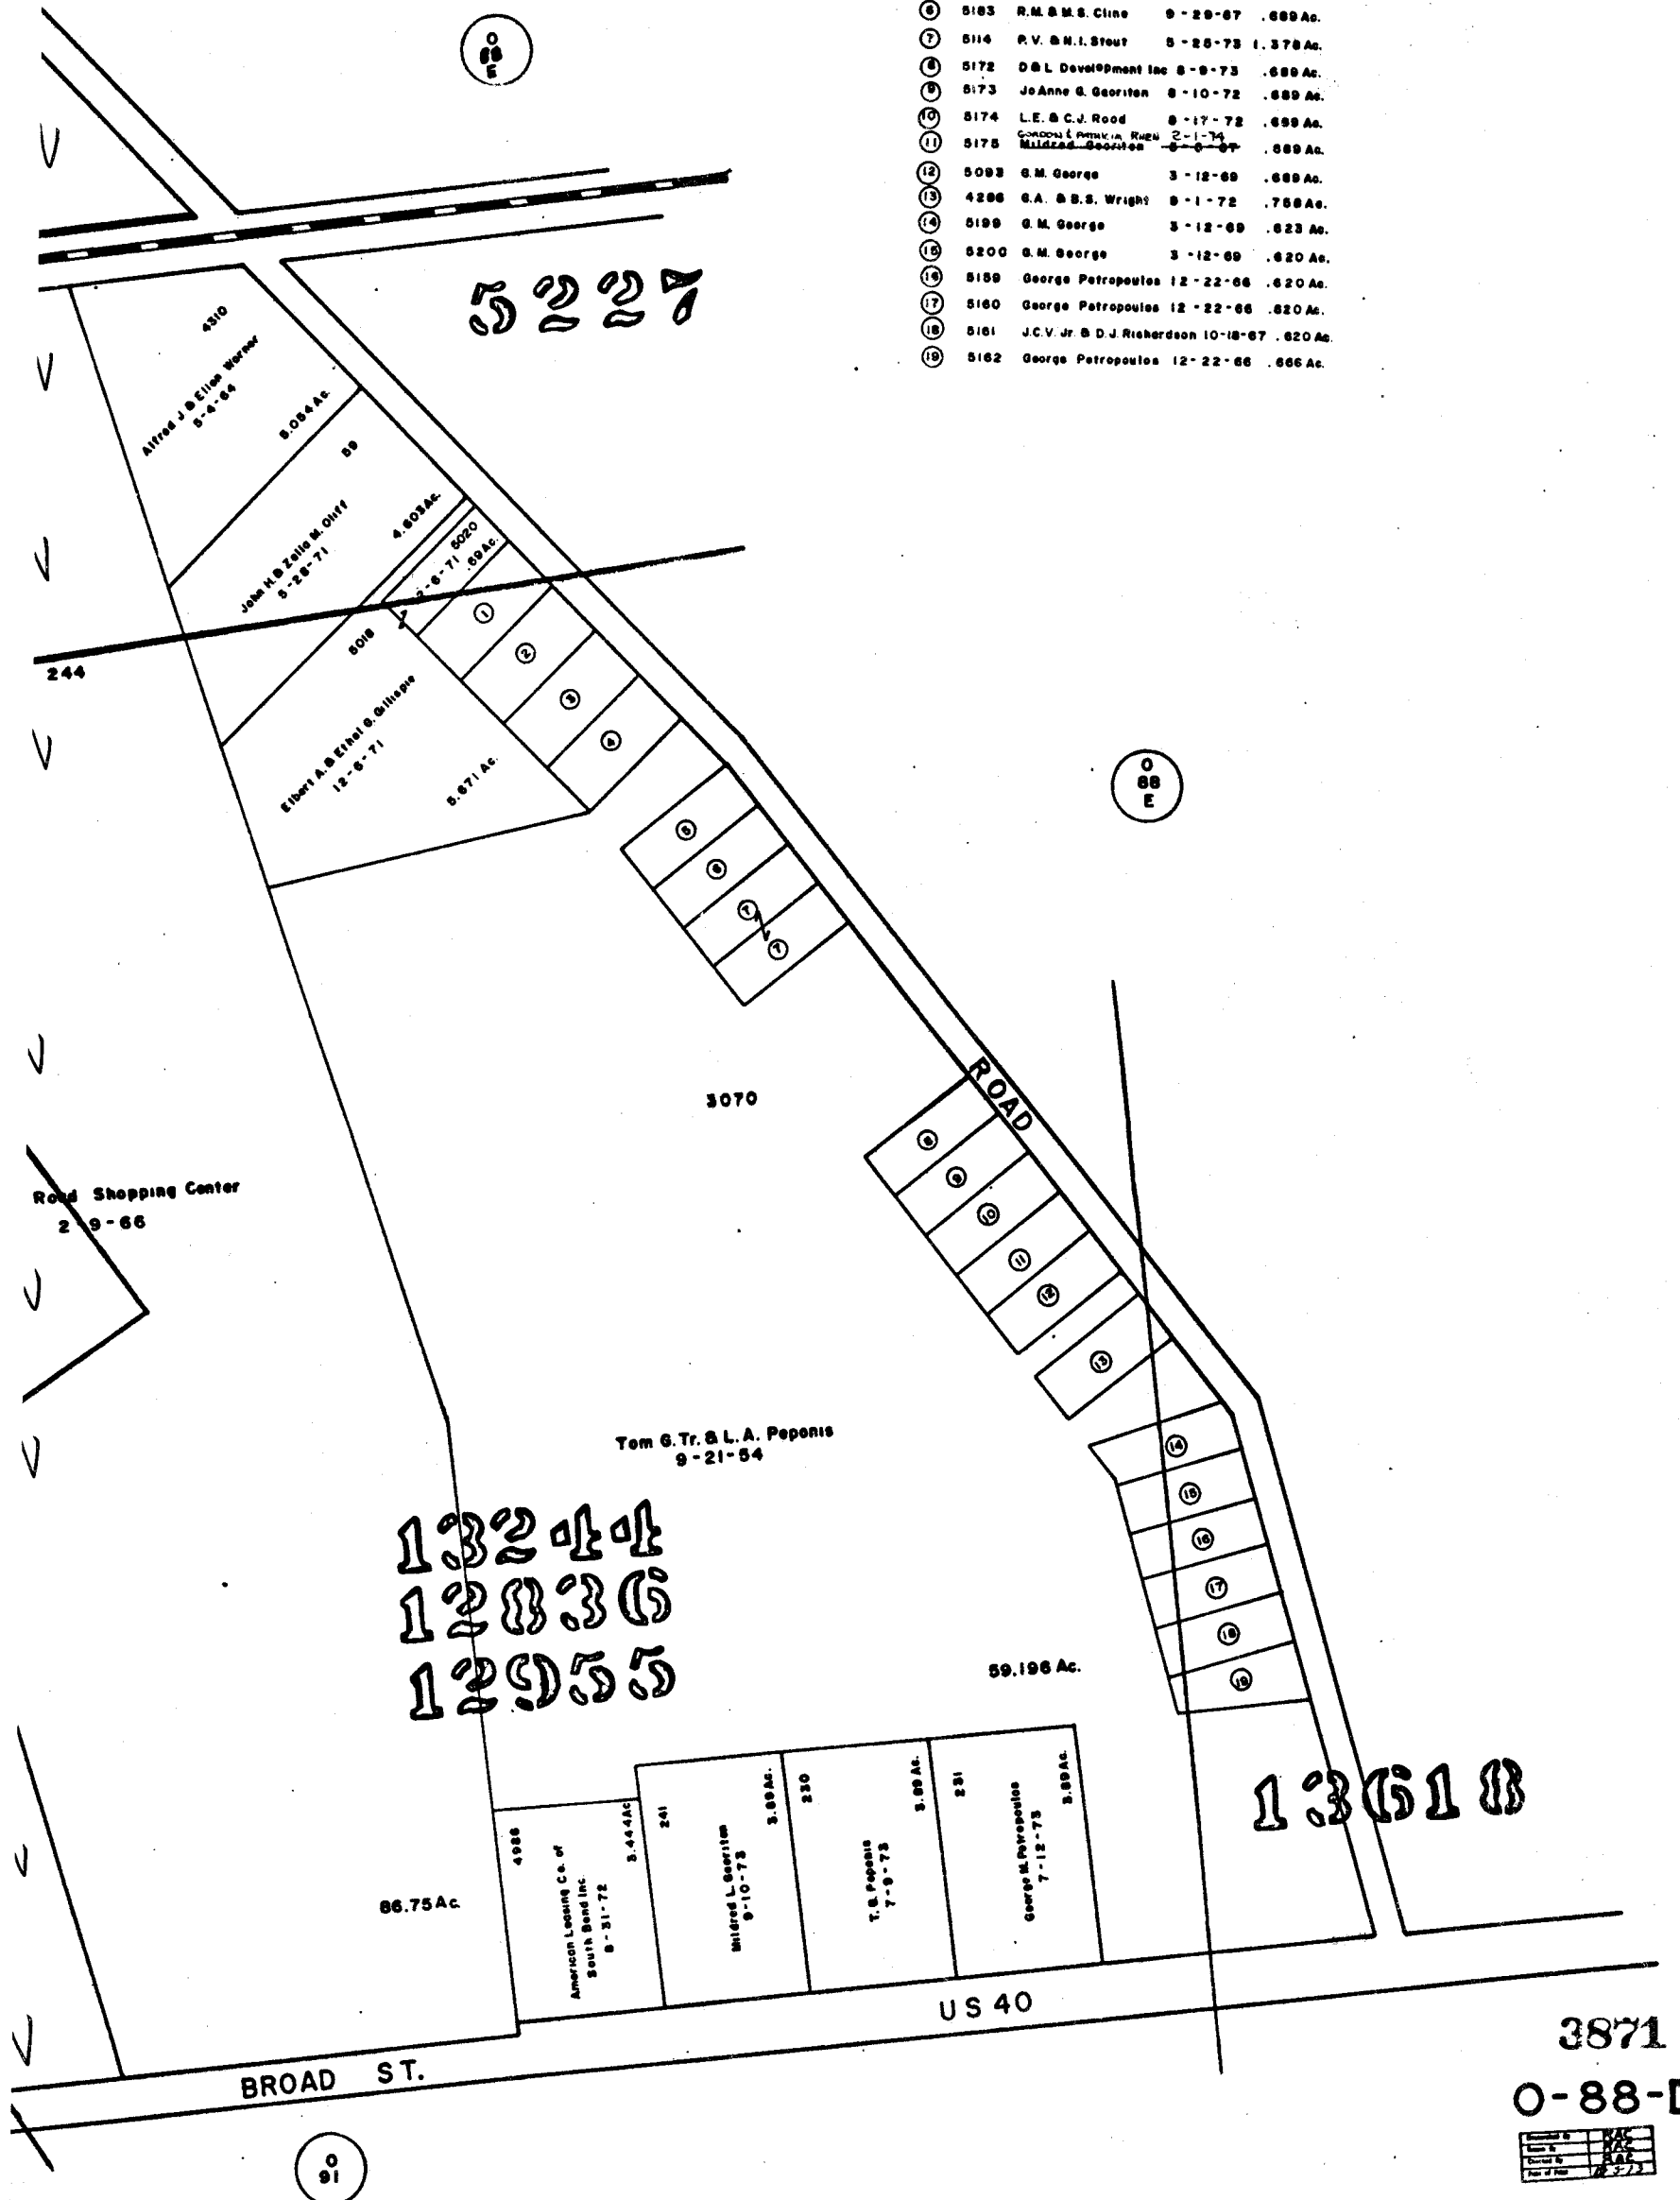

3871
 O-88-D