

0
92
C

Killbuck Financial Corp. &
Services Resources, Inc.
7-20-73

141

GALLOWAY ROAD

9221

(61 A)
*150370

7-20-73

(22 Ac)

(23.62 Ac)
Total 114.37 Ac

7-20-73

*150370
(1.80 Ac)

7-20-73

29.9

HALL

*100771

292

Country Condominiums, Ltd.
5-8-72

Anno M. Emde
6-6-47

1

25 Ac

25 Ac

0
95
E

0
95
B

O-92-F
PRAIRE TWP.




SCALE 1"=200'

V. M. S.

TAXING DISTRICT

PRAIRE TWP.

* COLS. SOUTHWESTERN S.D.

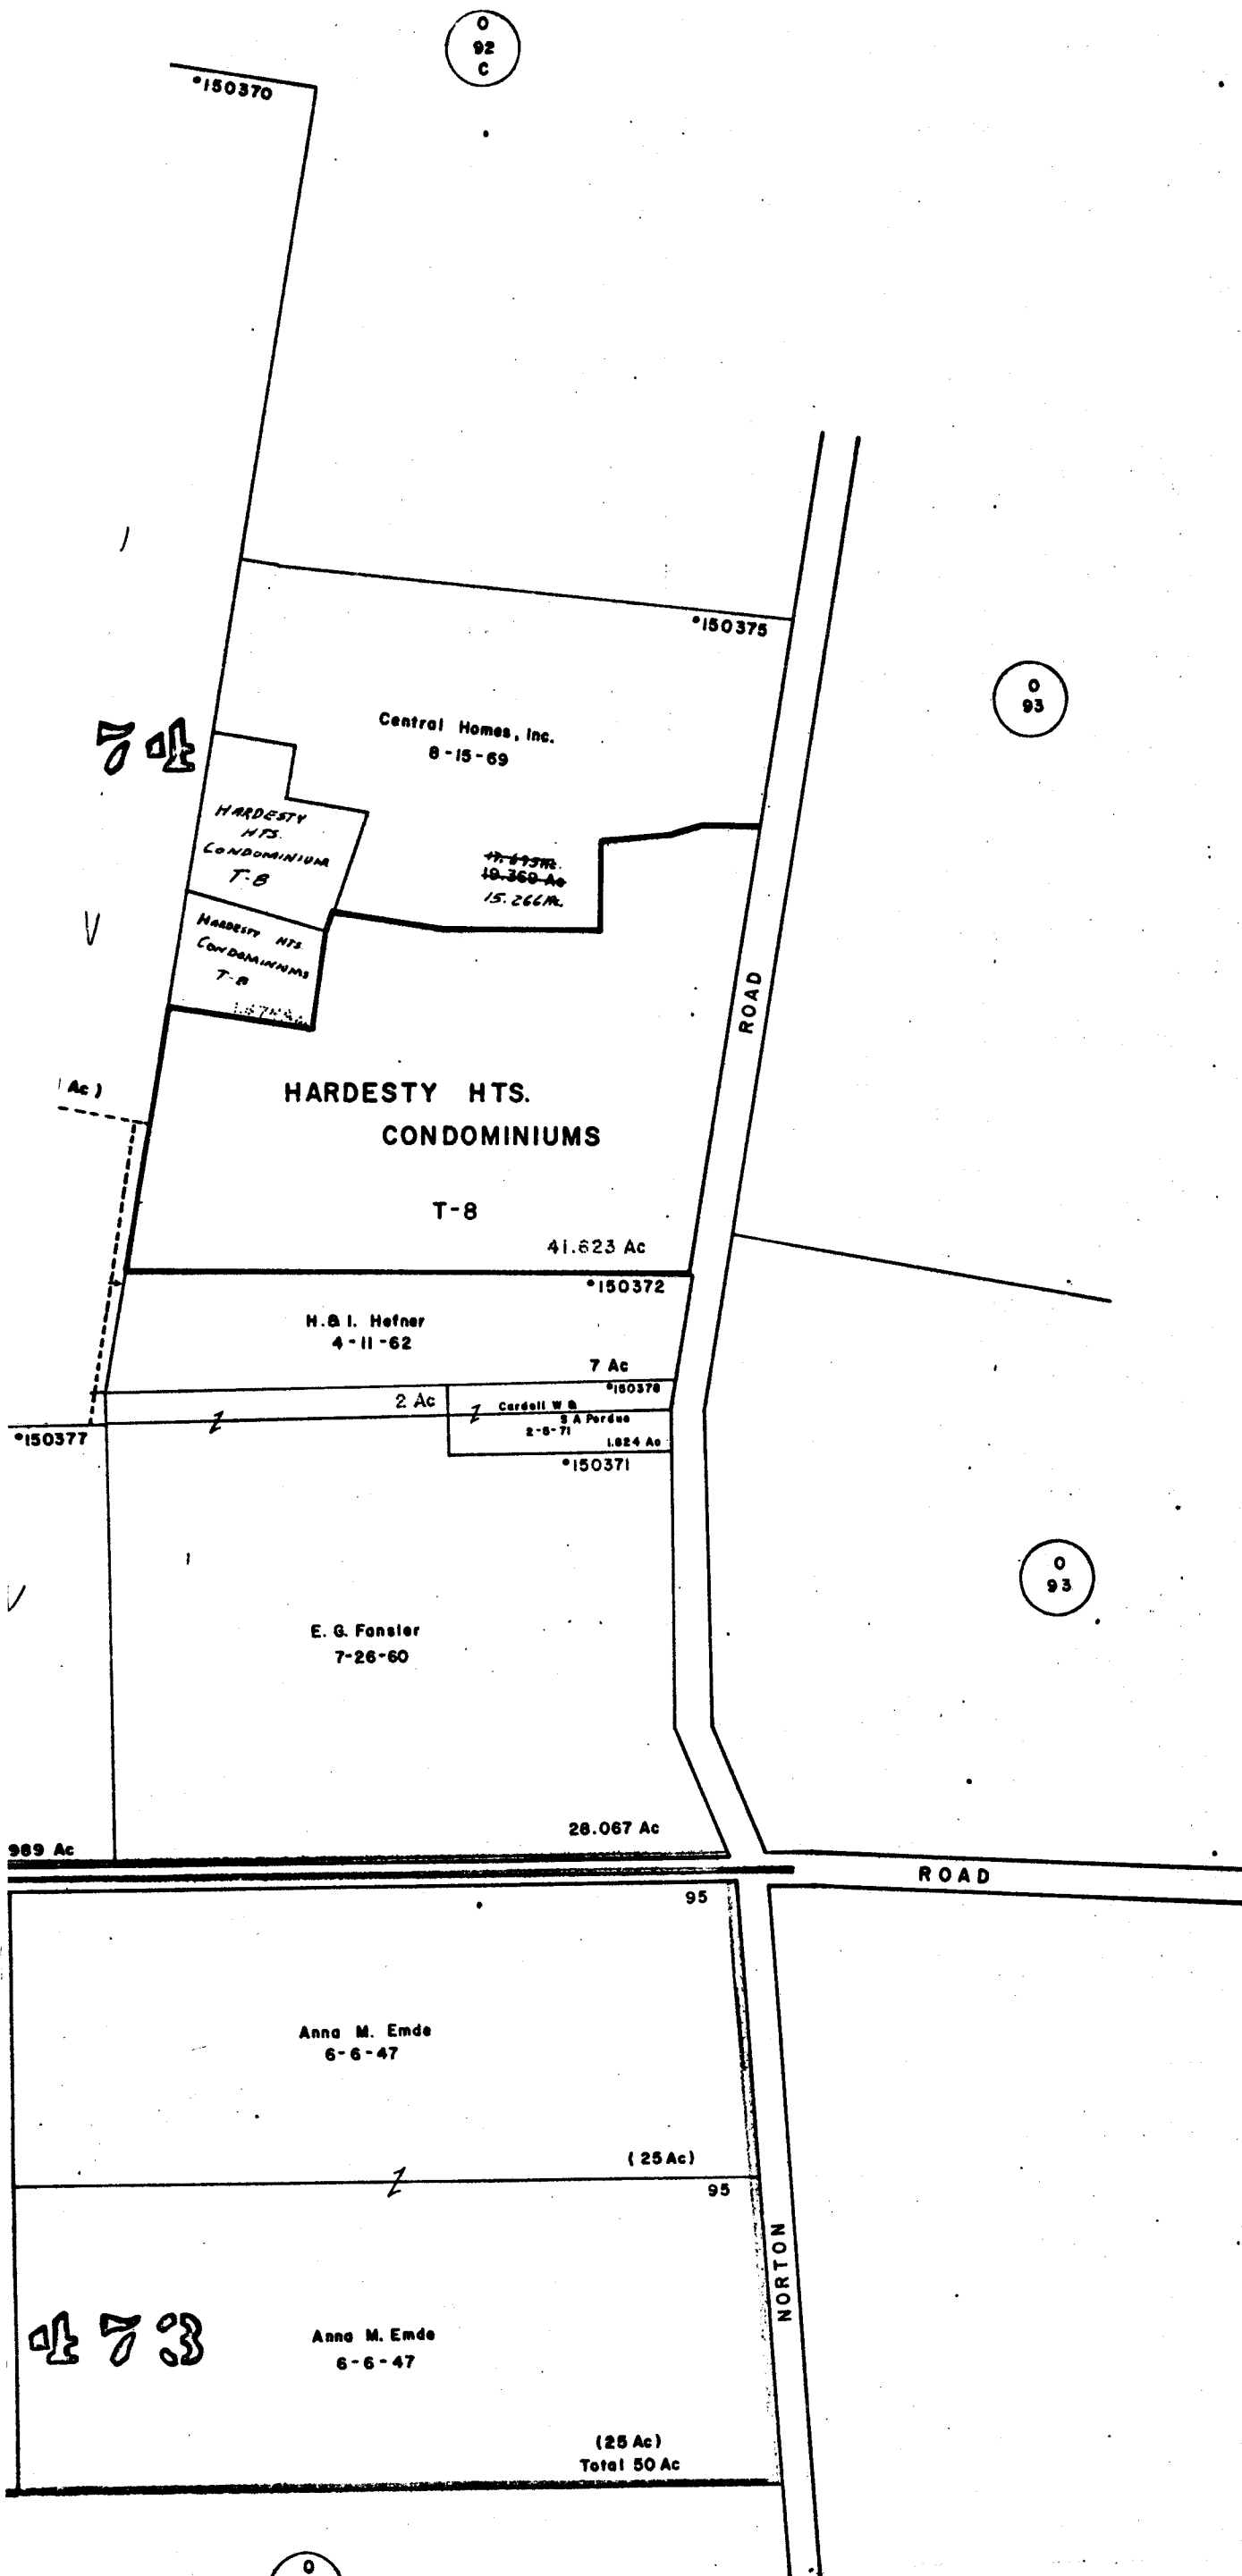

O-92-F

3929