

0
92


0
96

SCALE 1" = 200'

VMS

TAXING DISTRICT

COLS. - SOUTHWESTERN 30

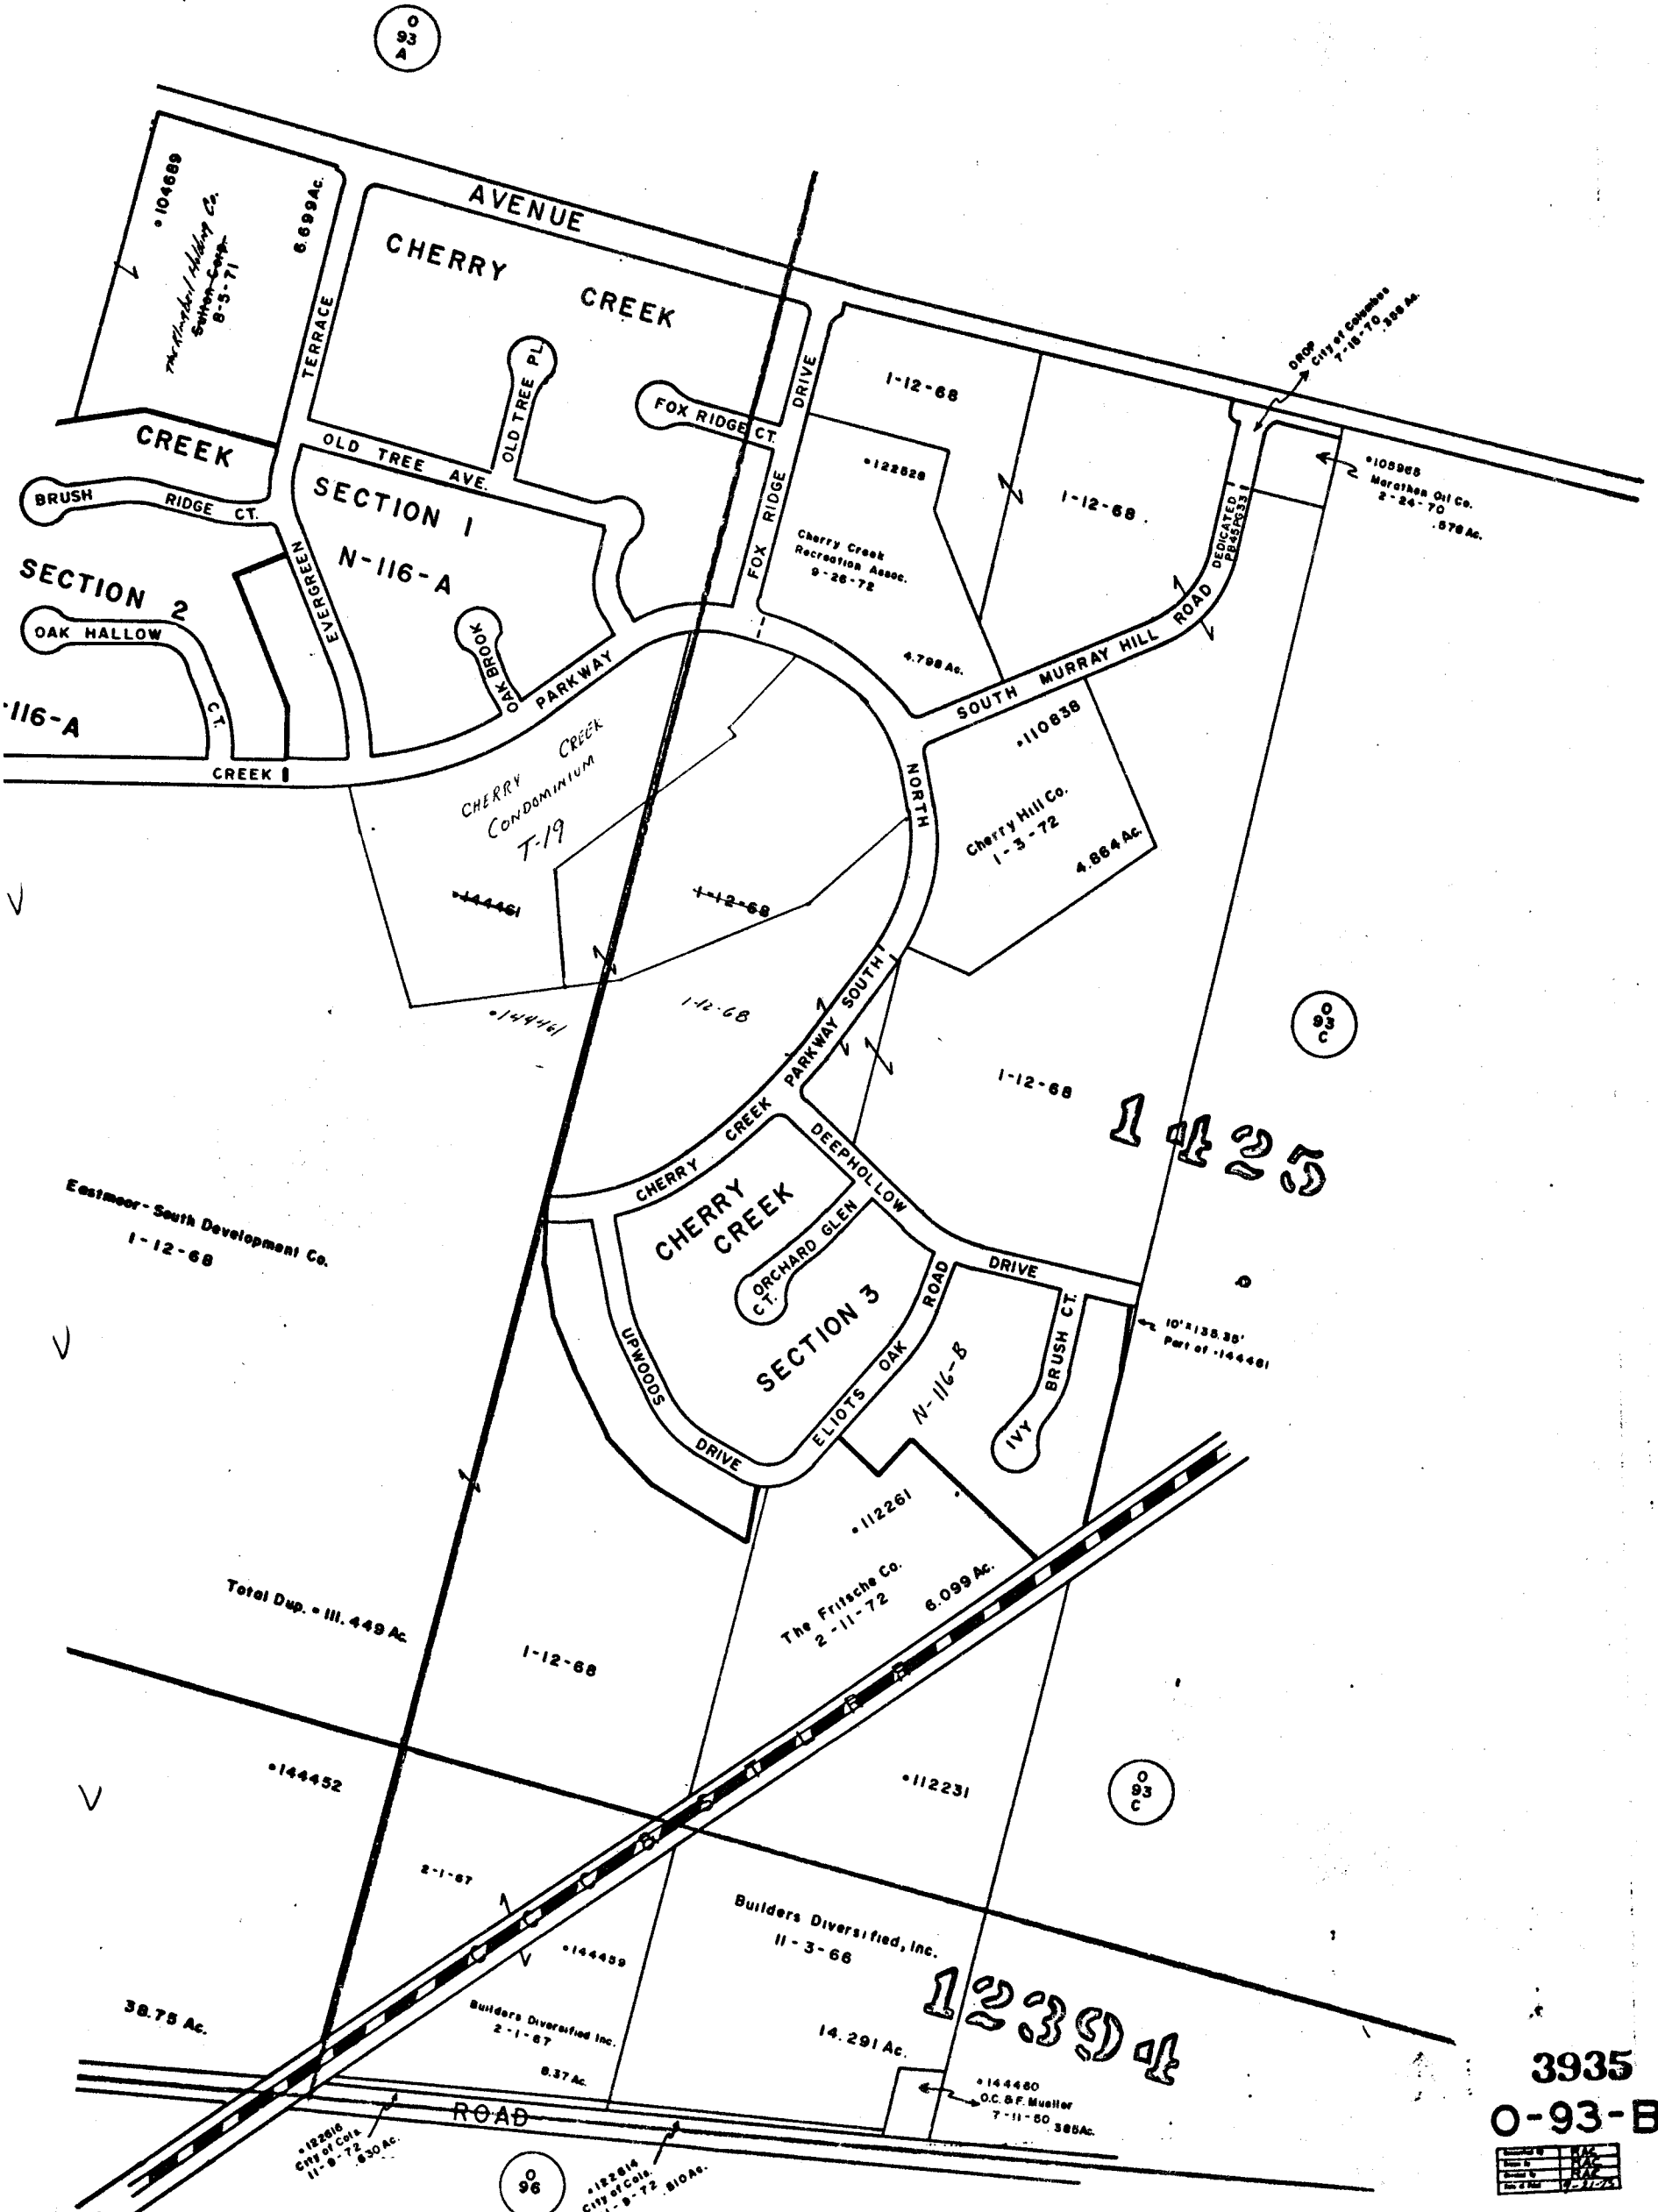

3935
 O-93-B
