


0
99
C

MEEKLYNN

N-108-B PARCELS

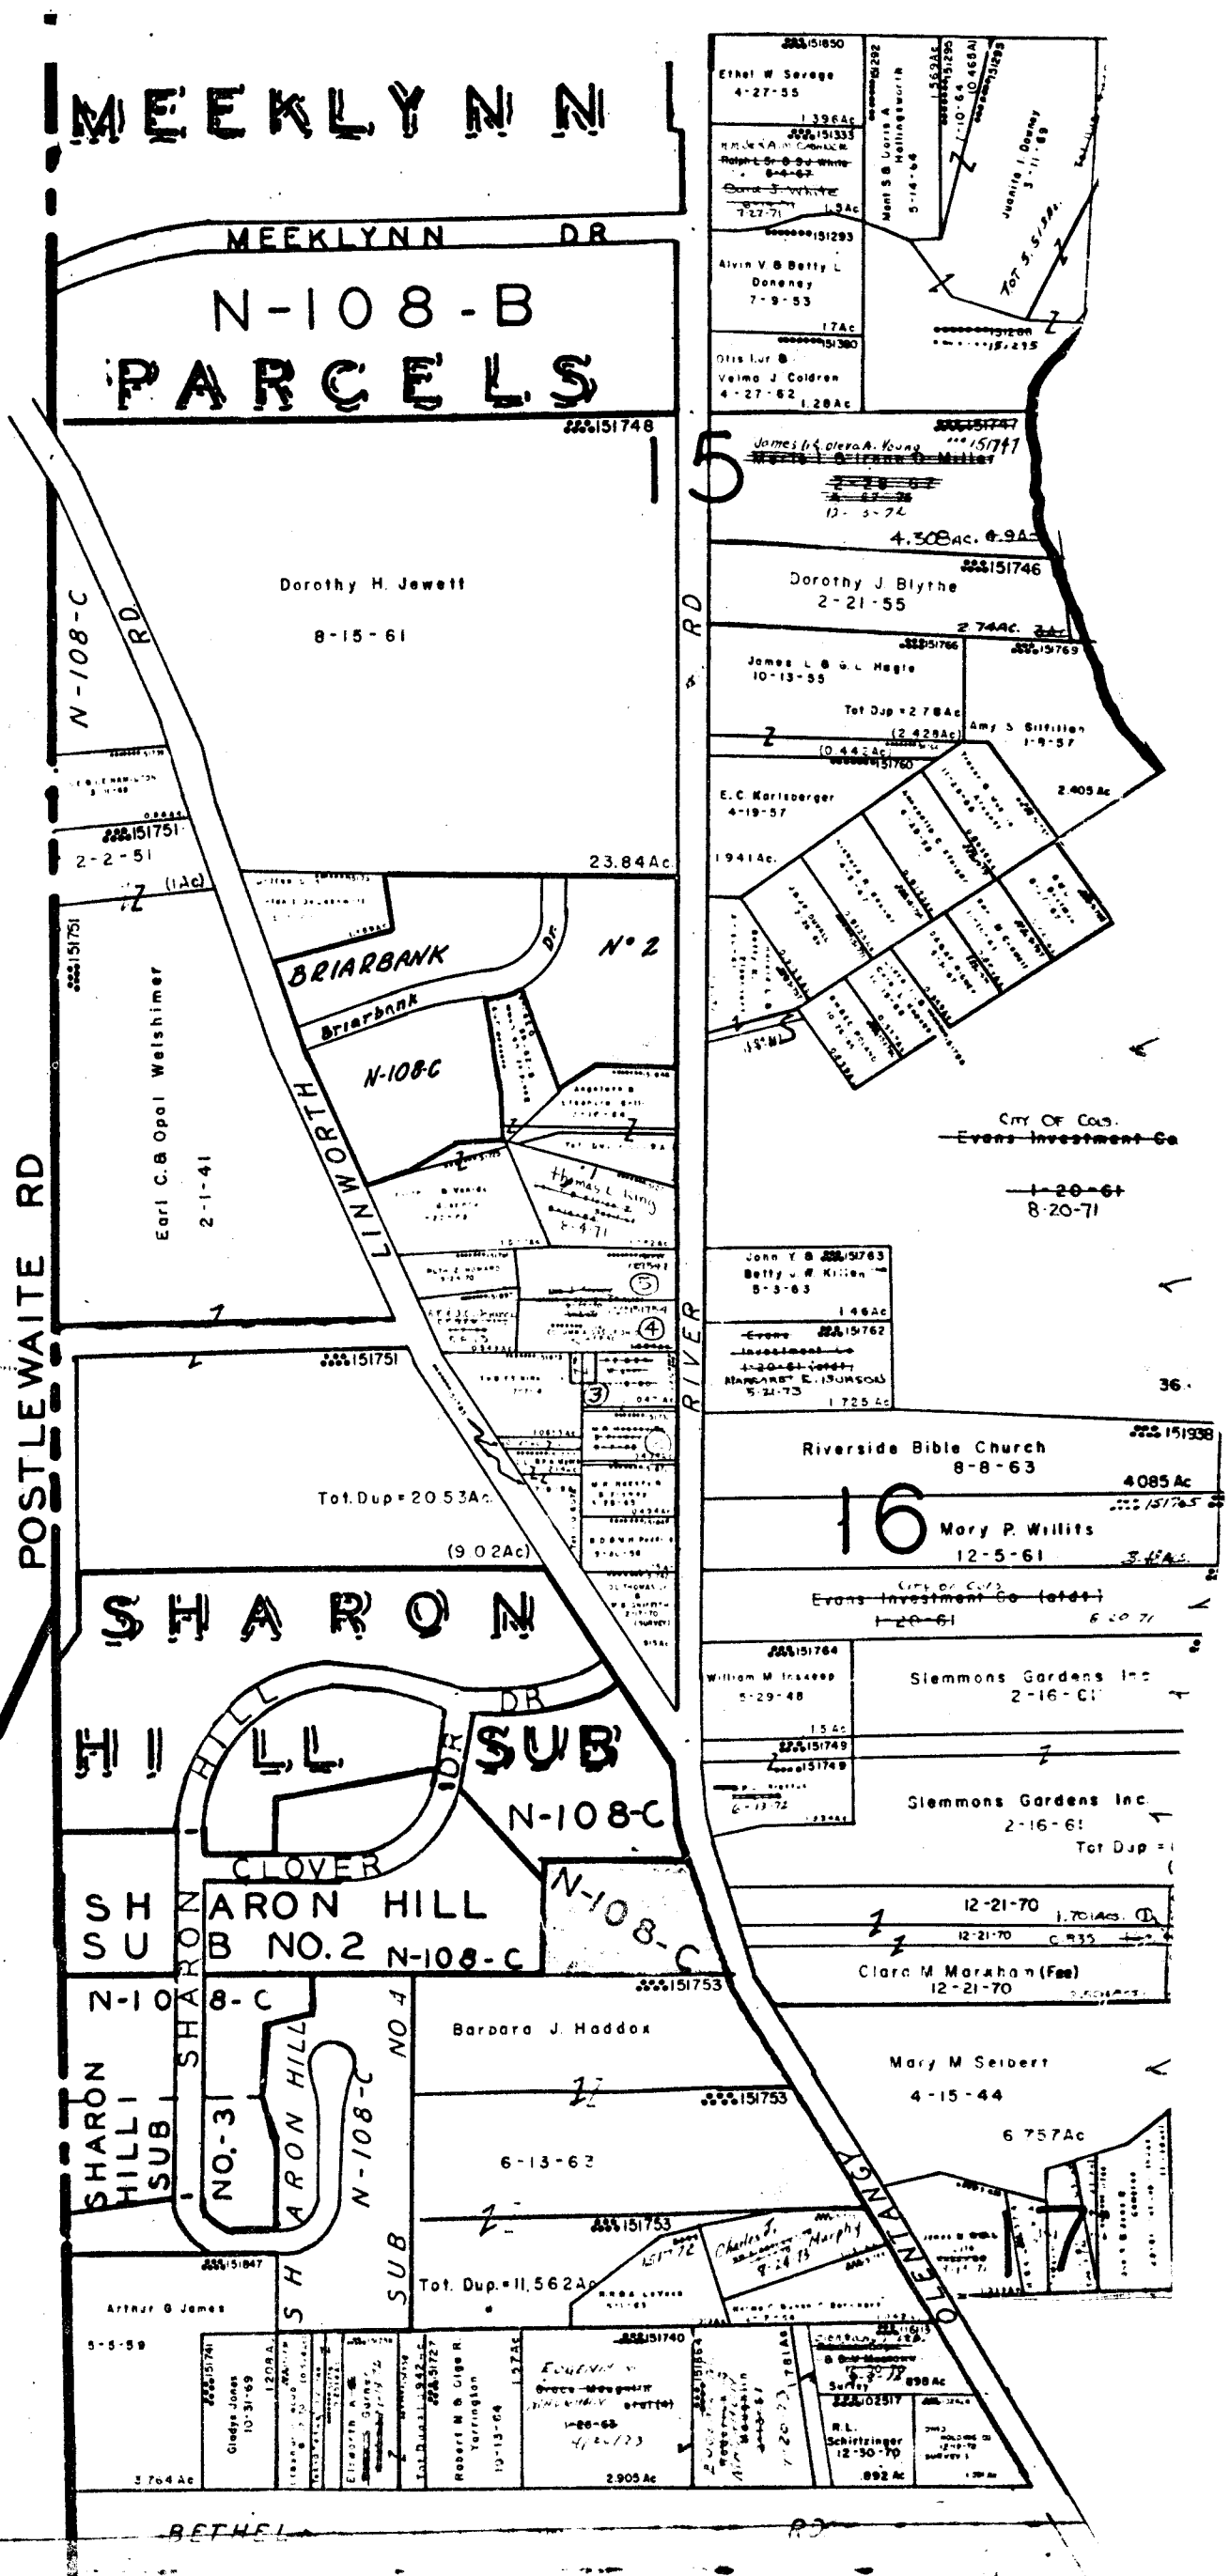


0
70



SCALE 1"=200'
TAXING DISTRICTS

SHARON TWP.
*COL-WORTH. S.D.
***SHARON-COLS. S.D.
***CITY OF COLUMBUS

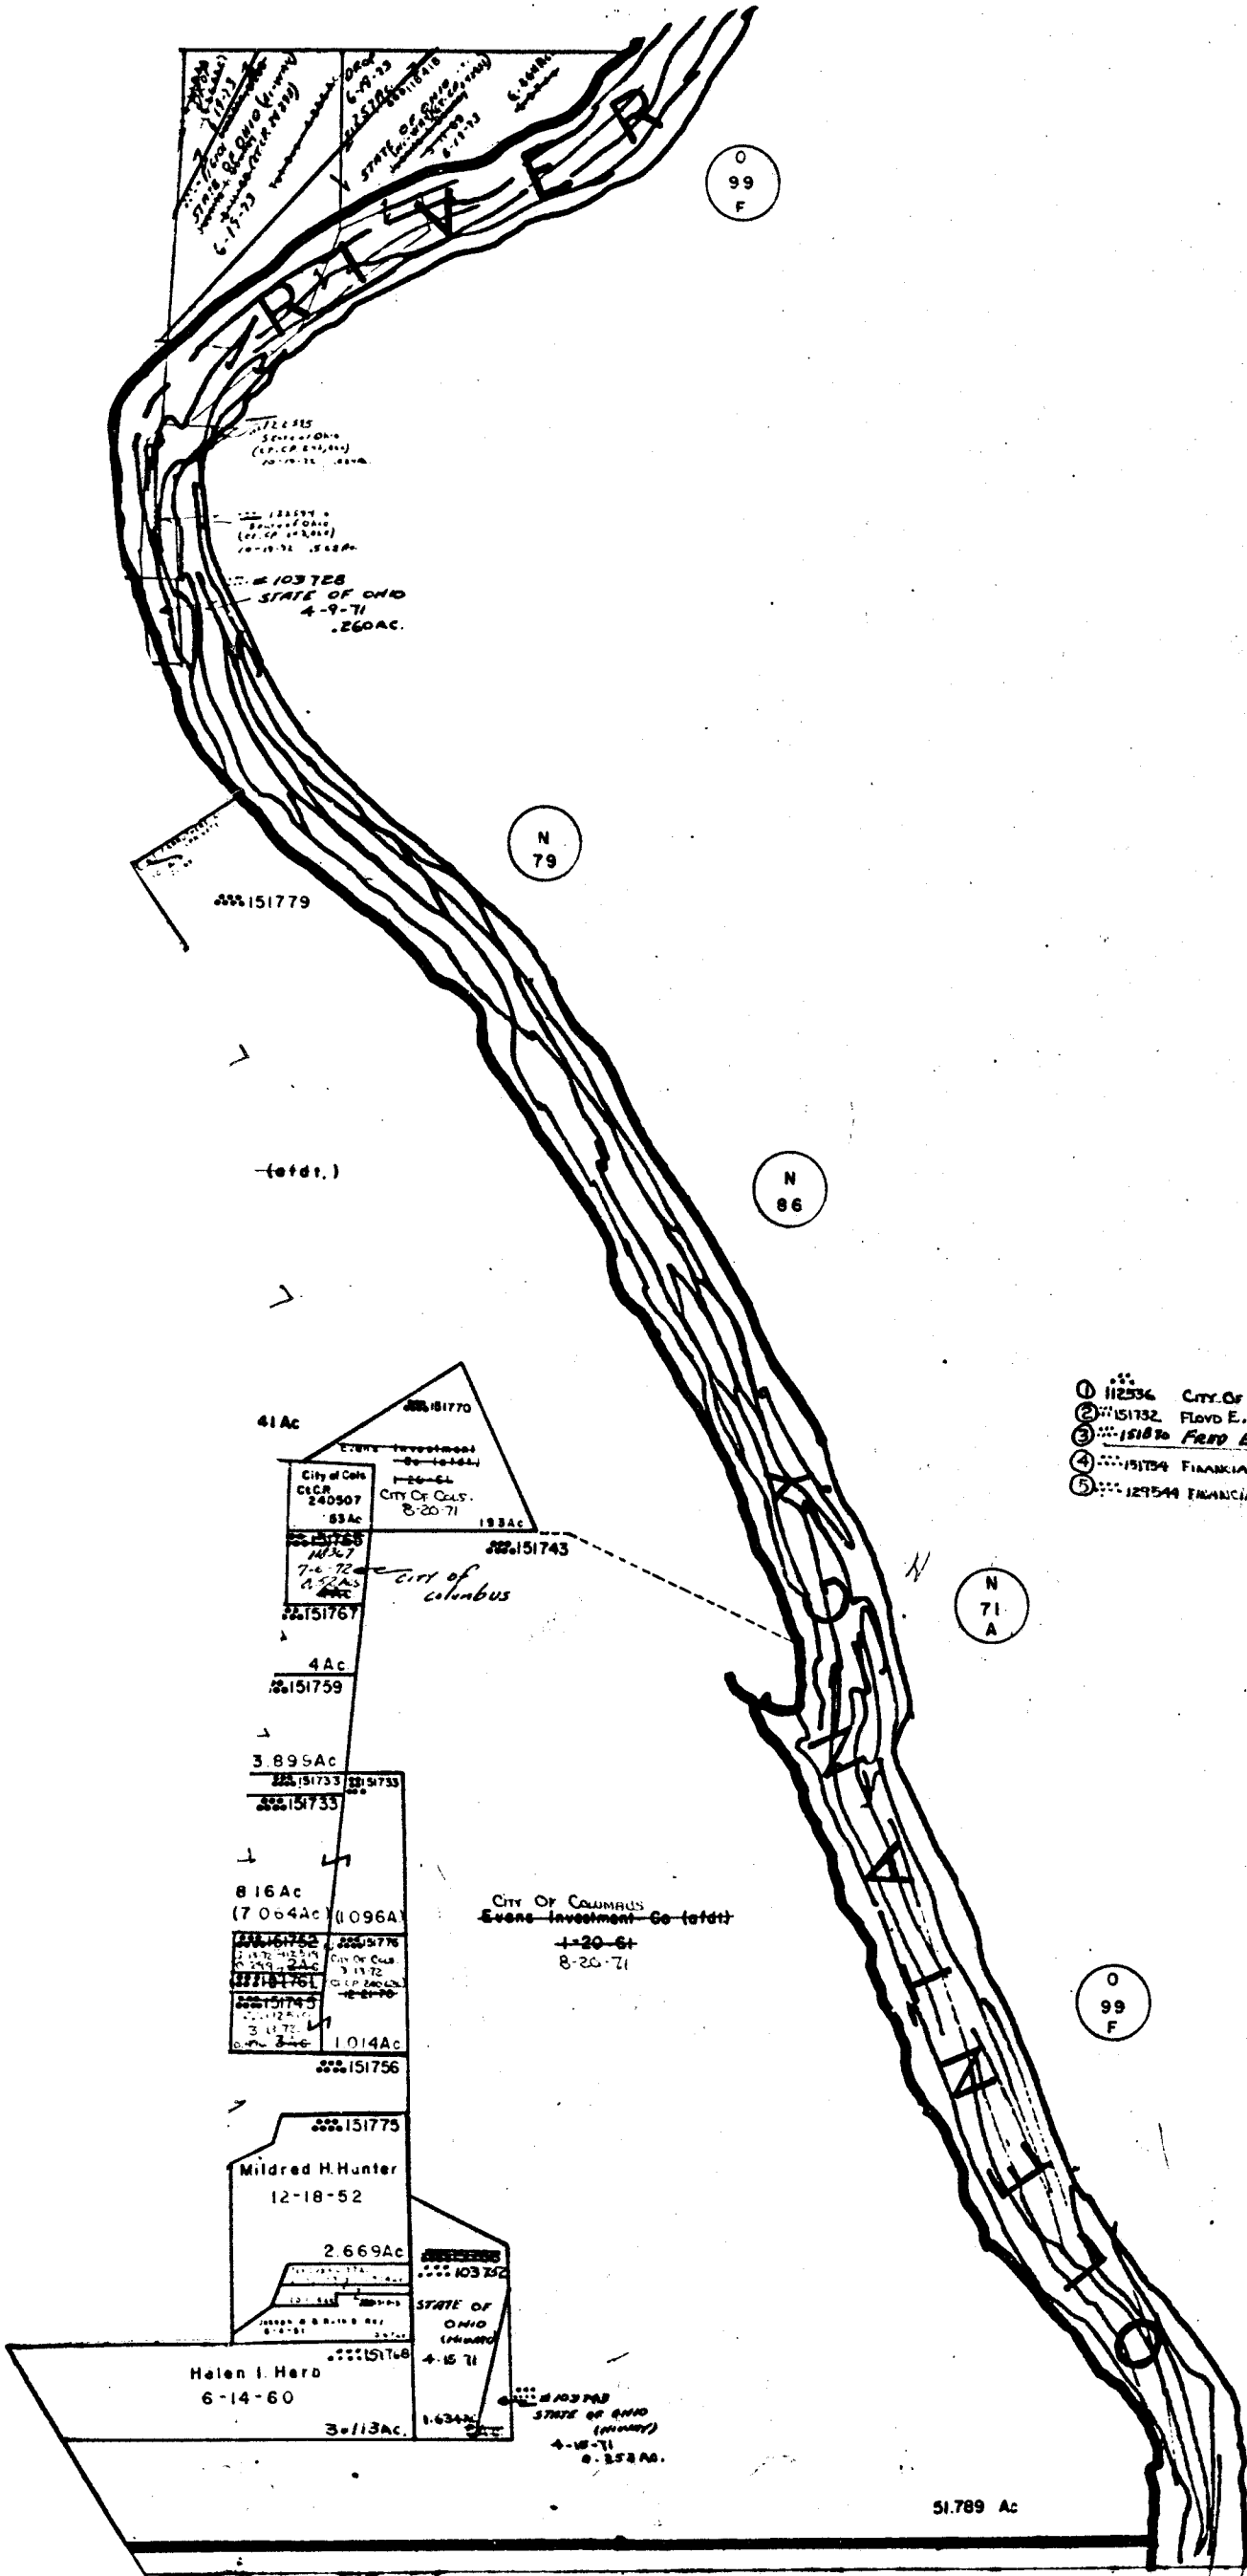

- ① 112536 CITY OF COLS. (CT. OF 240622) 3-13-72 0.165 Ac.
- ② 151732 FLOYD E. & VIRGINIA ROBINSON 7-2-73 0.494 Ac.
- ③ 151870 FRED E. WIGMORE 10-12-73 0.471 Ac.
- ④ 151794 FINANCIAL OBJECTIVES CORP. 10-18-73 0.7168 Ac.
- ⑤ 129544 FINANCIAL OBJECTIVES CORP. 10-18-73 0.872 Ac.