



O-99-G

SHARON TWP.  
R.18 TWP.2



SCALE 1"=200'

TAXING DISTRICTS

• COLS. WORTH S.D.

••• CITY OF COLS.


N  
70  
C

N  
86

N  
70  
B

100  
100

100

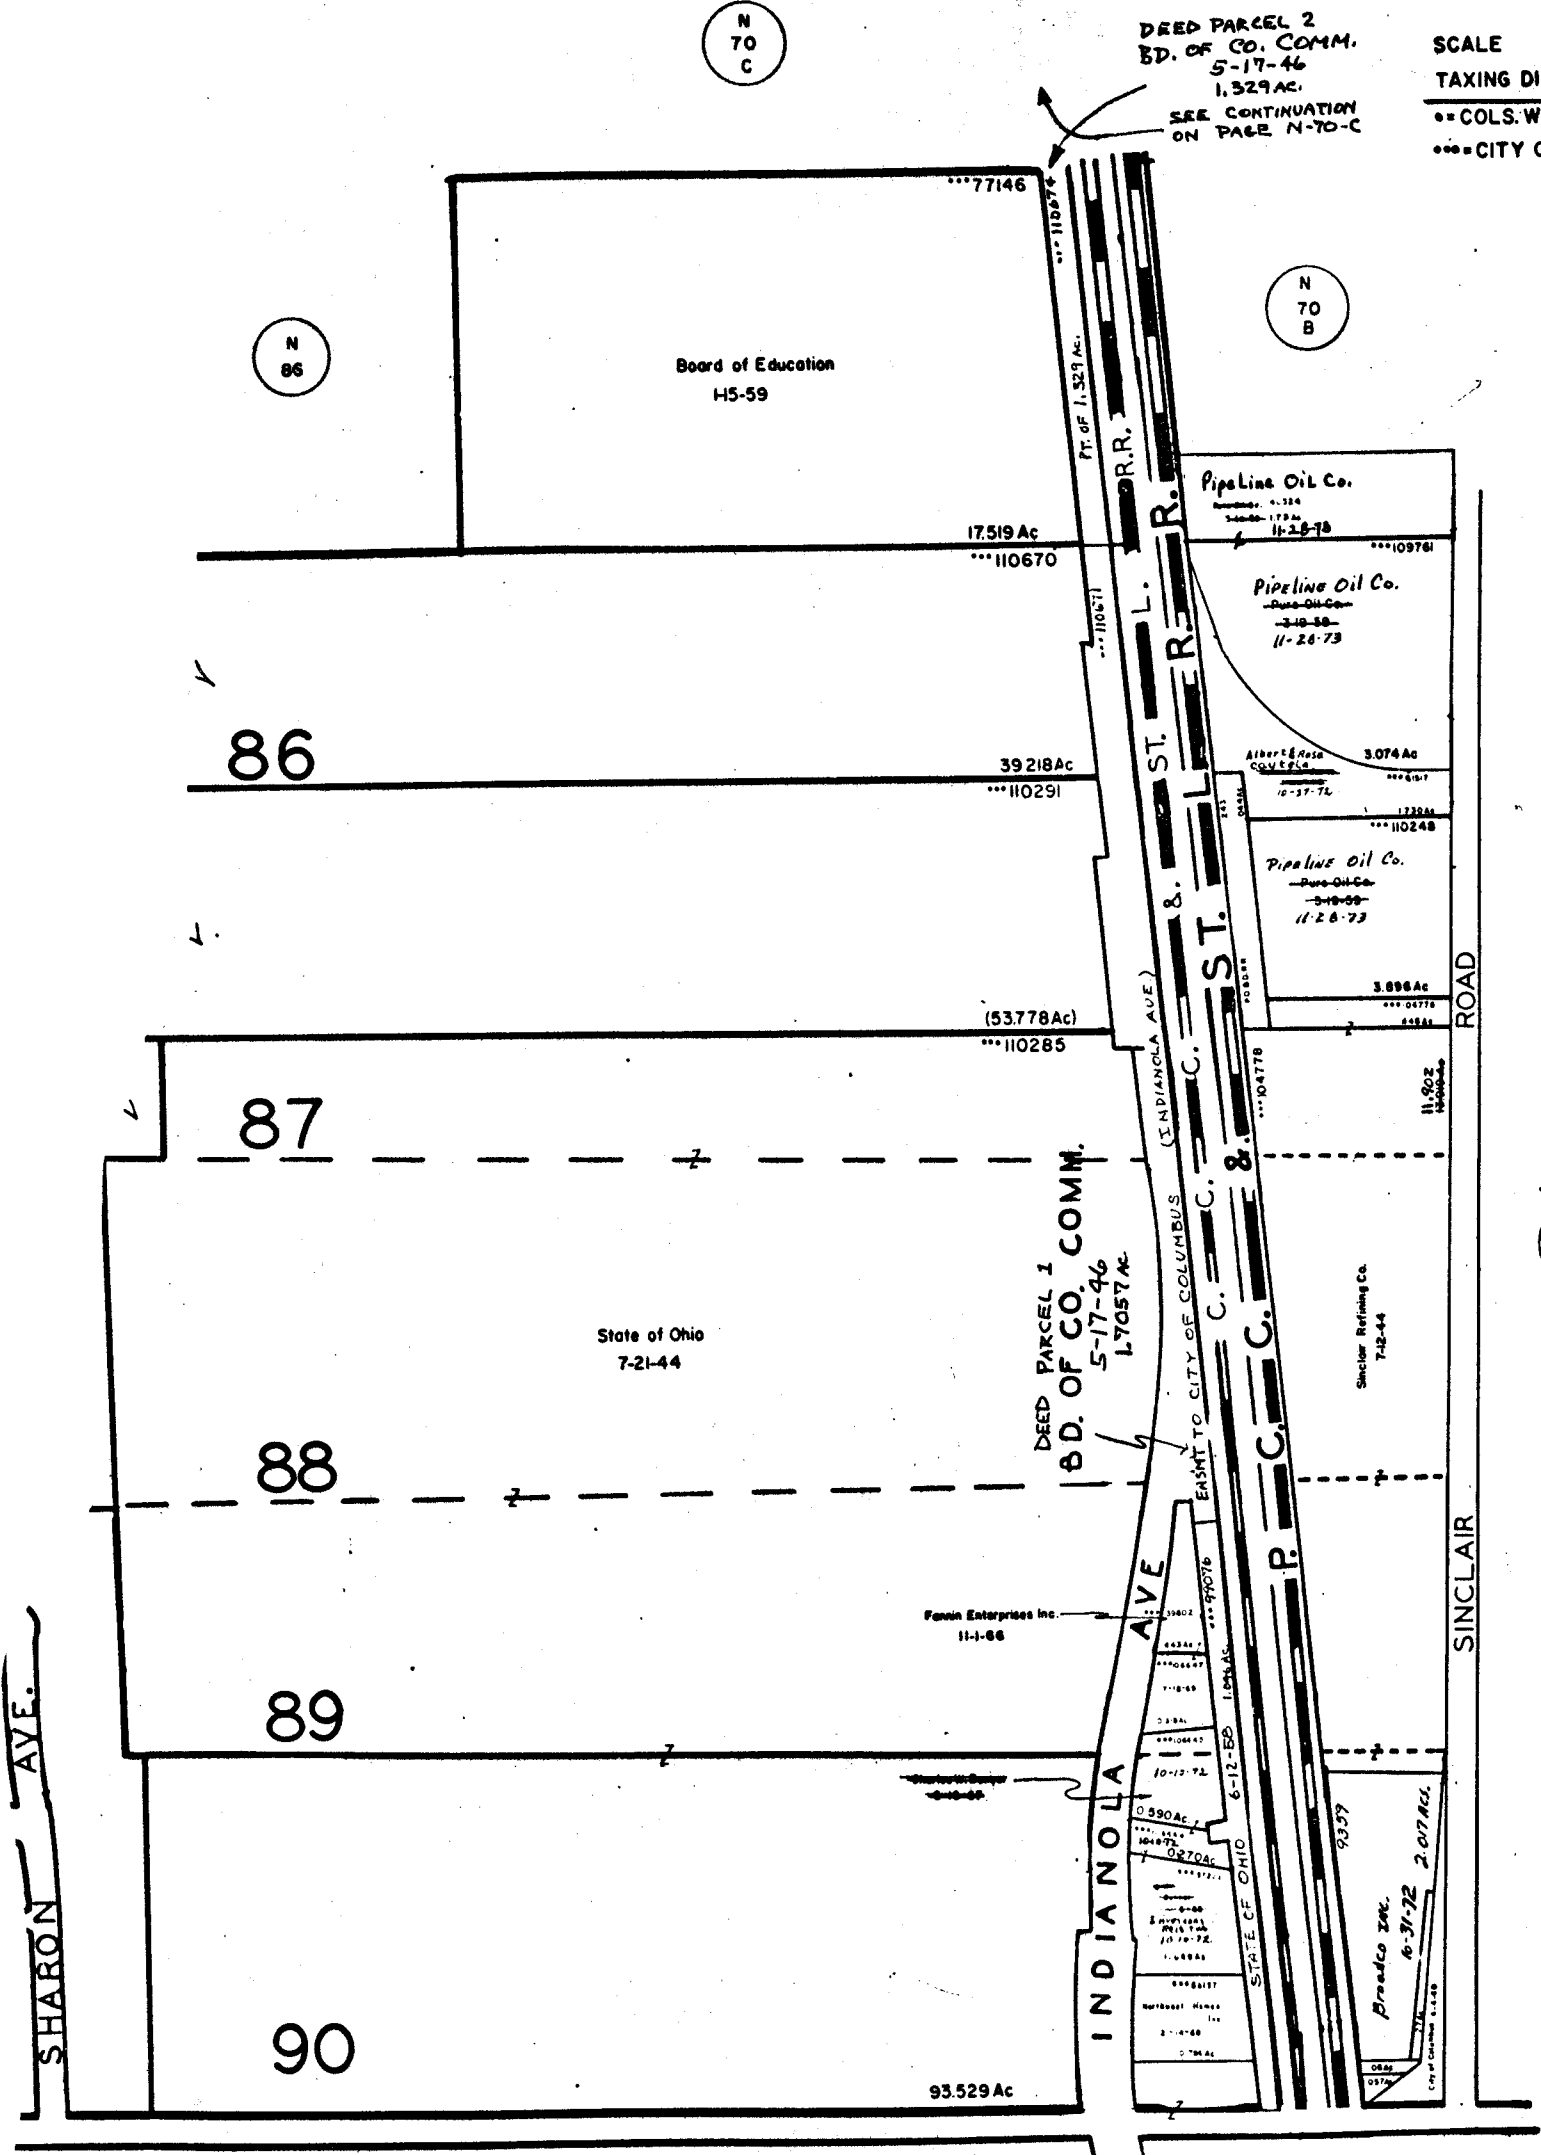

DEED PARCEL 2  
BD. OF CO. COMM.  
5-17-46  
1.329 AC.  
SEE CONTINUATION  
ON PAGE N-70-C

DEED PARCEL 1  
BD. OF CO. COMM.  
5-17-46  
1.7057 AC.