




O-100-C

SHARON R. 18 TWP TWP 2



SCALE 1" = 200'  
TAXING DISTRICTS  
\*\*\*\*\* SHARON-WESTERVILLE S.D.  
\*\*\*\*\* COL.-WESTERVILLE S.D.


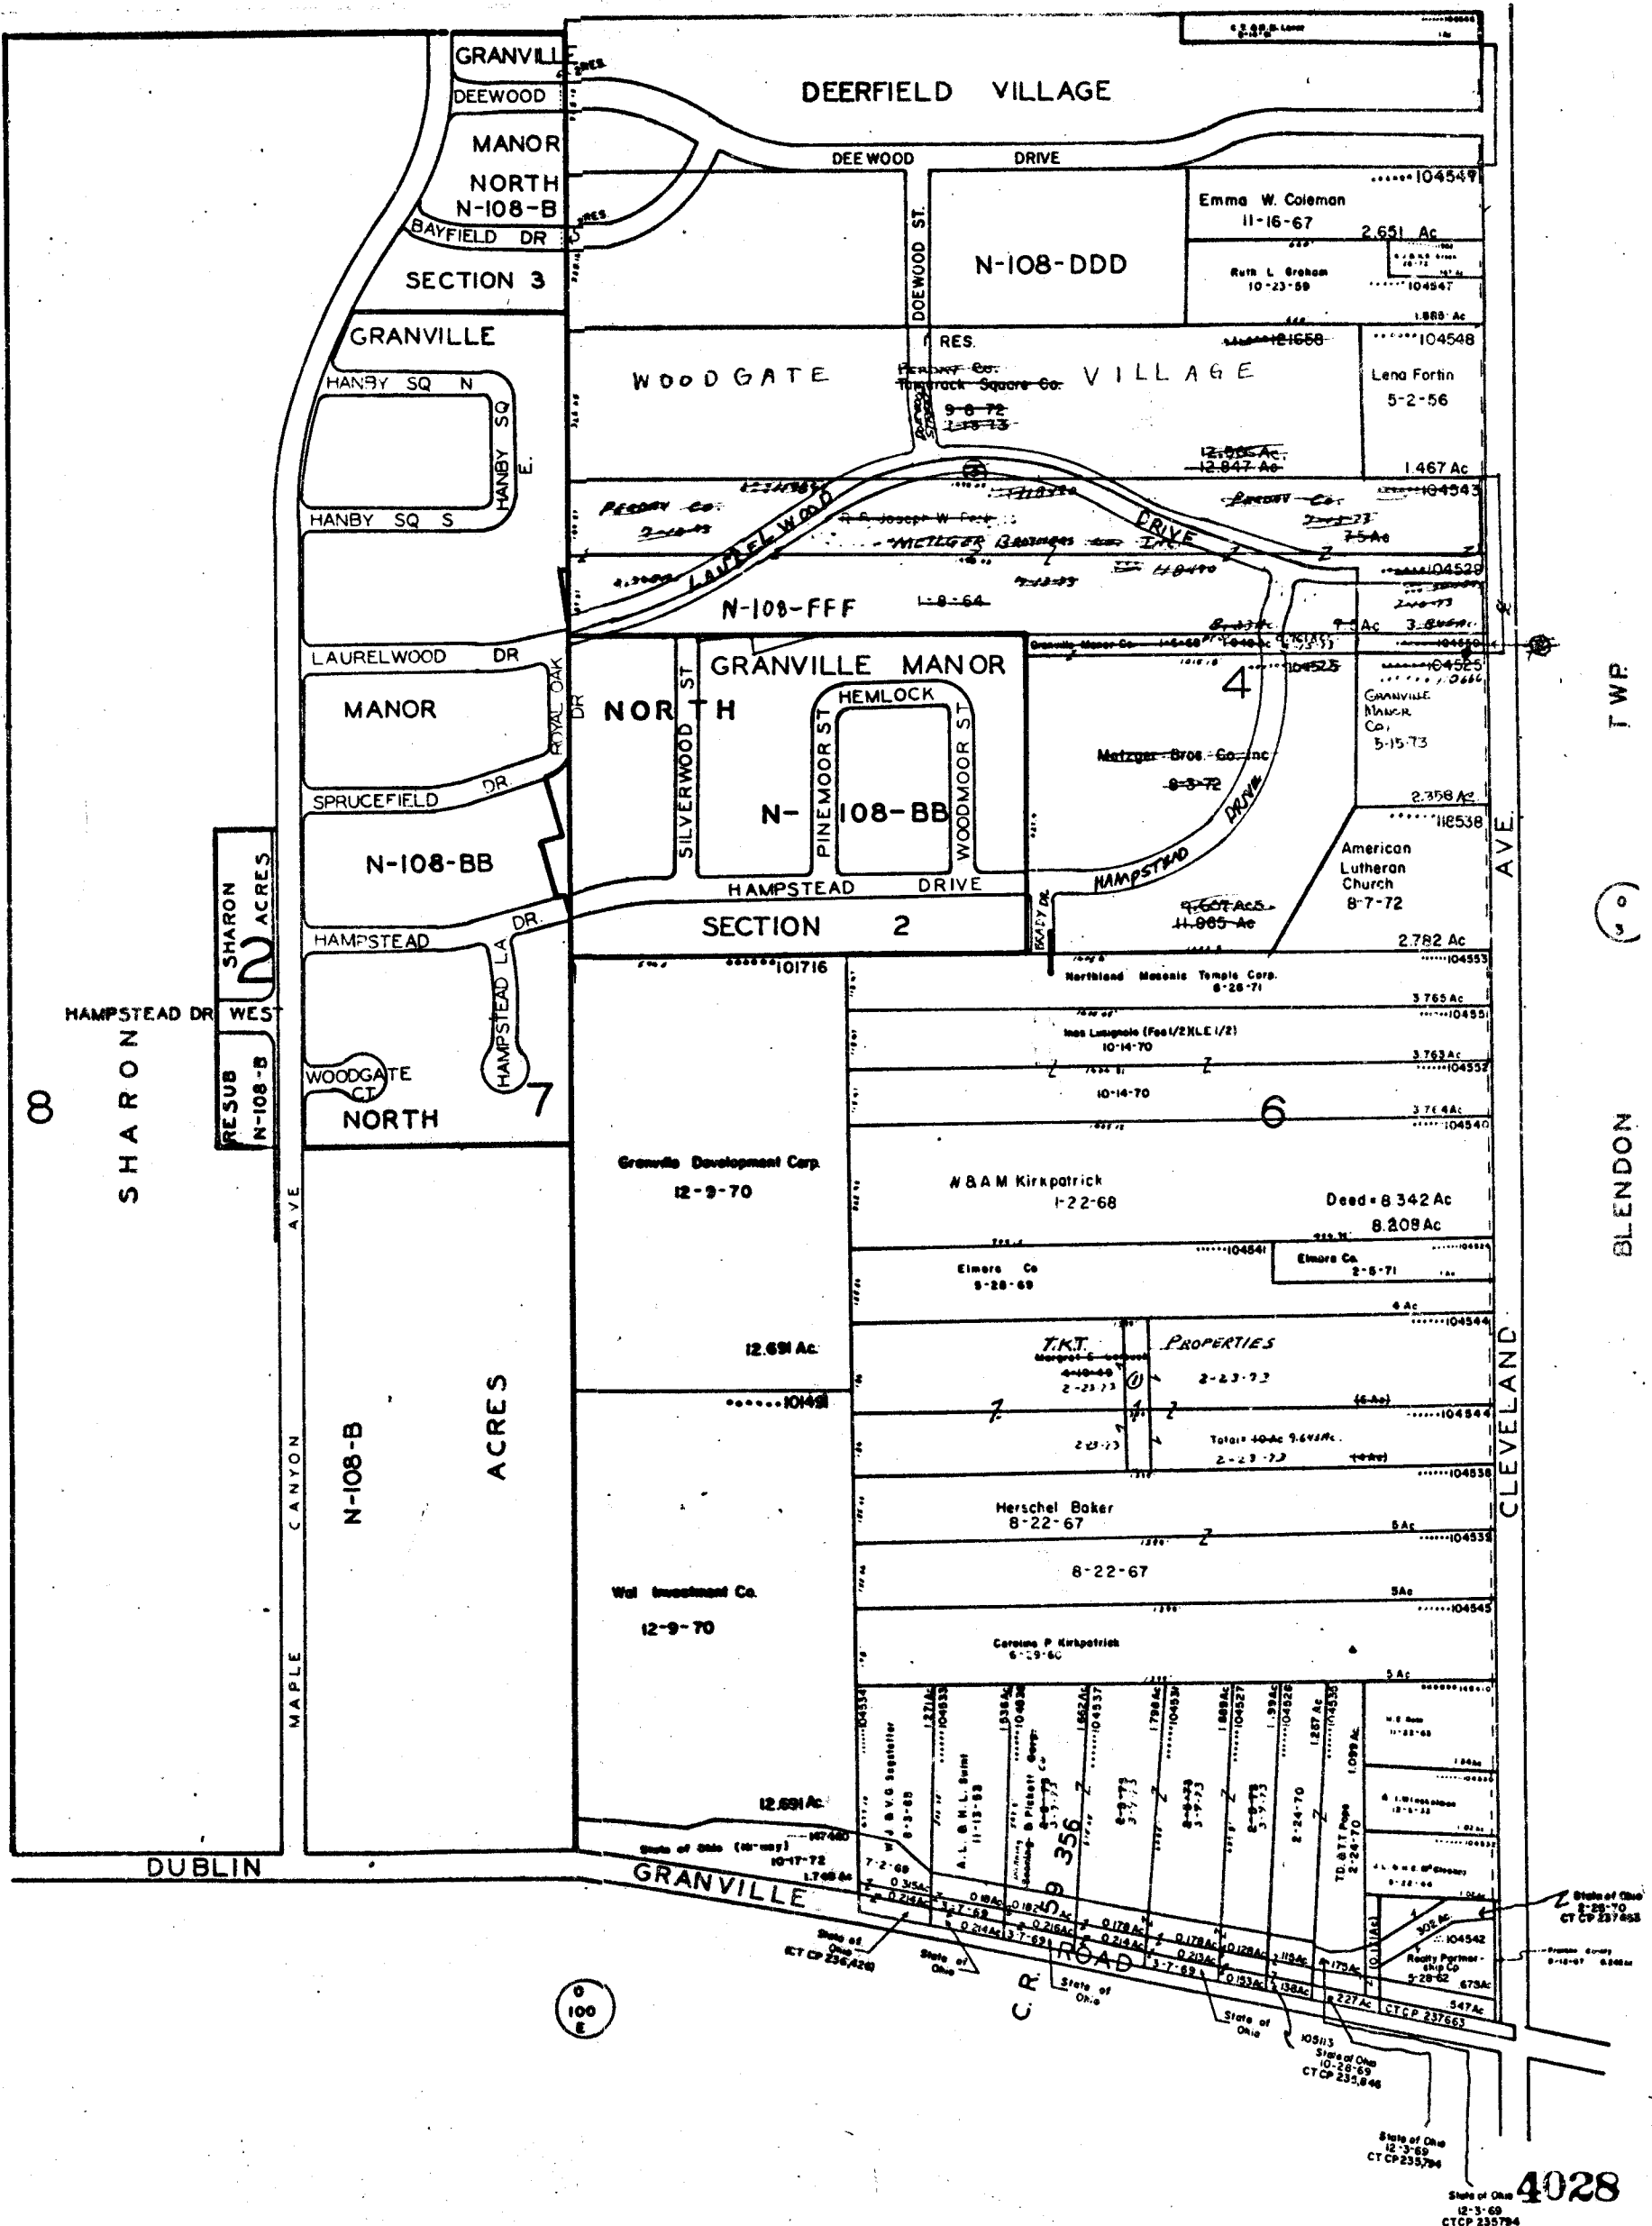

TWP

BLENDON

CLEVELAND

4028