

O-104-C

TRURO TWP.


R.21 TWP.12

SCALE 1"=200'

TAXING DISTRICTS

CITY OF COLUMBUS

** COLUMBUS-REYNOLDSBURG

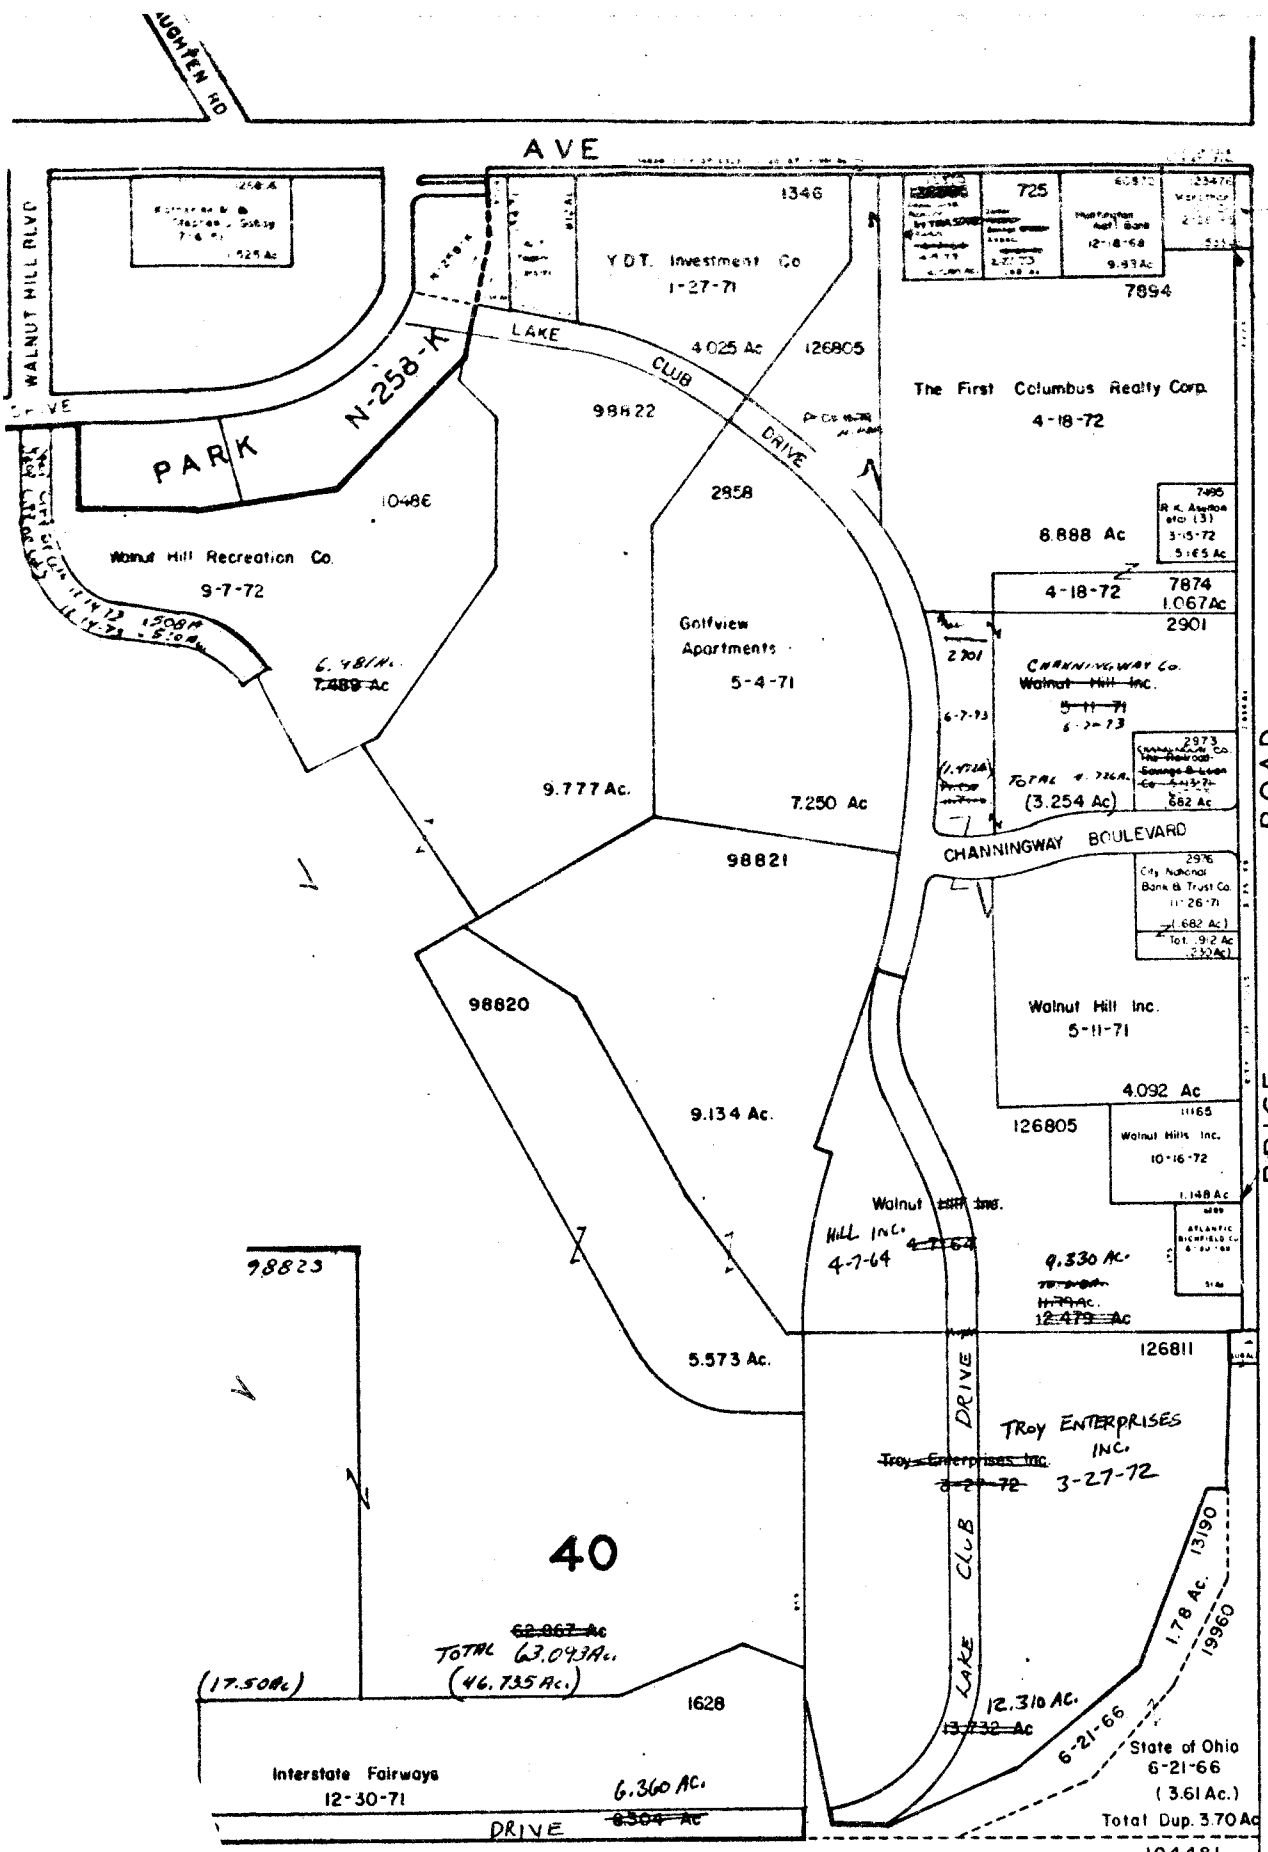


5359 City of Reynoldsburg 1-31-72 155 Ac

Controlled Access Plat For West Side of Brice Road P.B. 41 Pg. 100

0 105

5 STATE OF OHIO 6-21-66

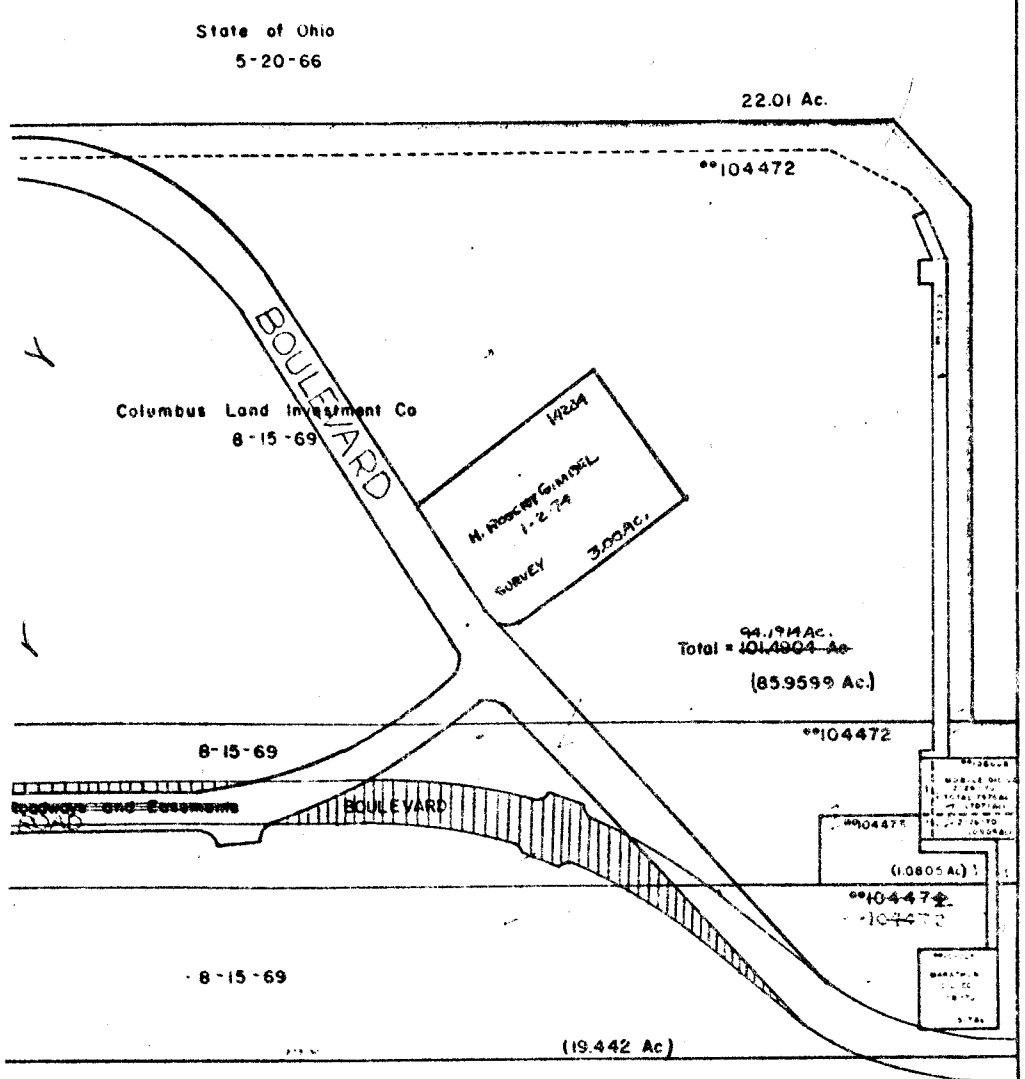

1016809 COLUMBIAN INVESTMENT CO BY AC 101 8-15-70 730 Ac

0 105

TUSSING RD

O-104-C

4071