


0
100
C

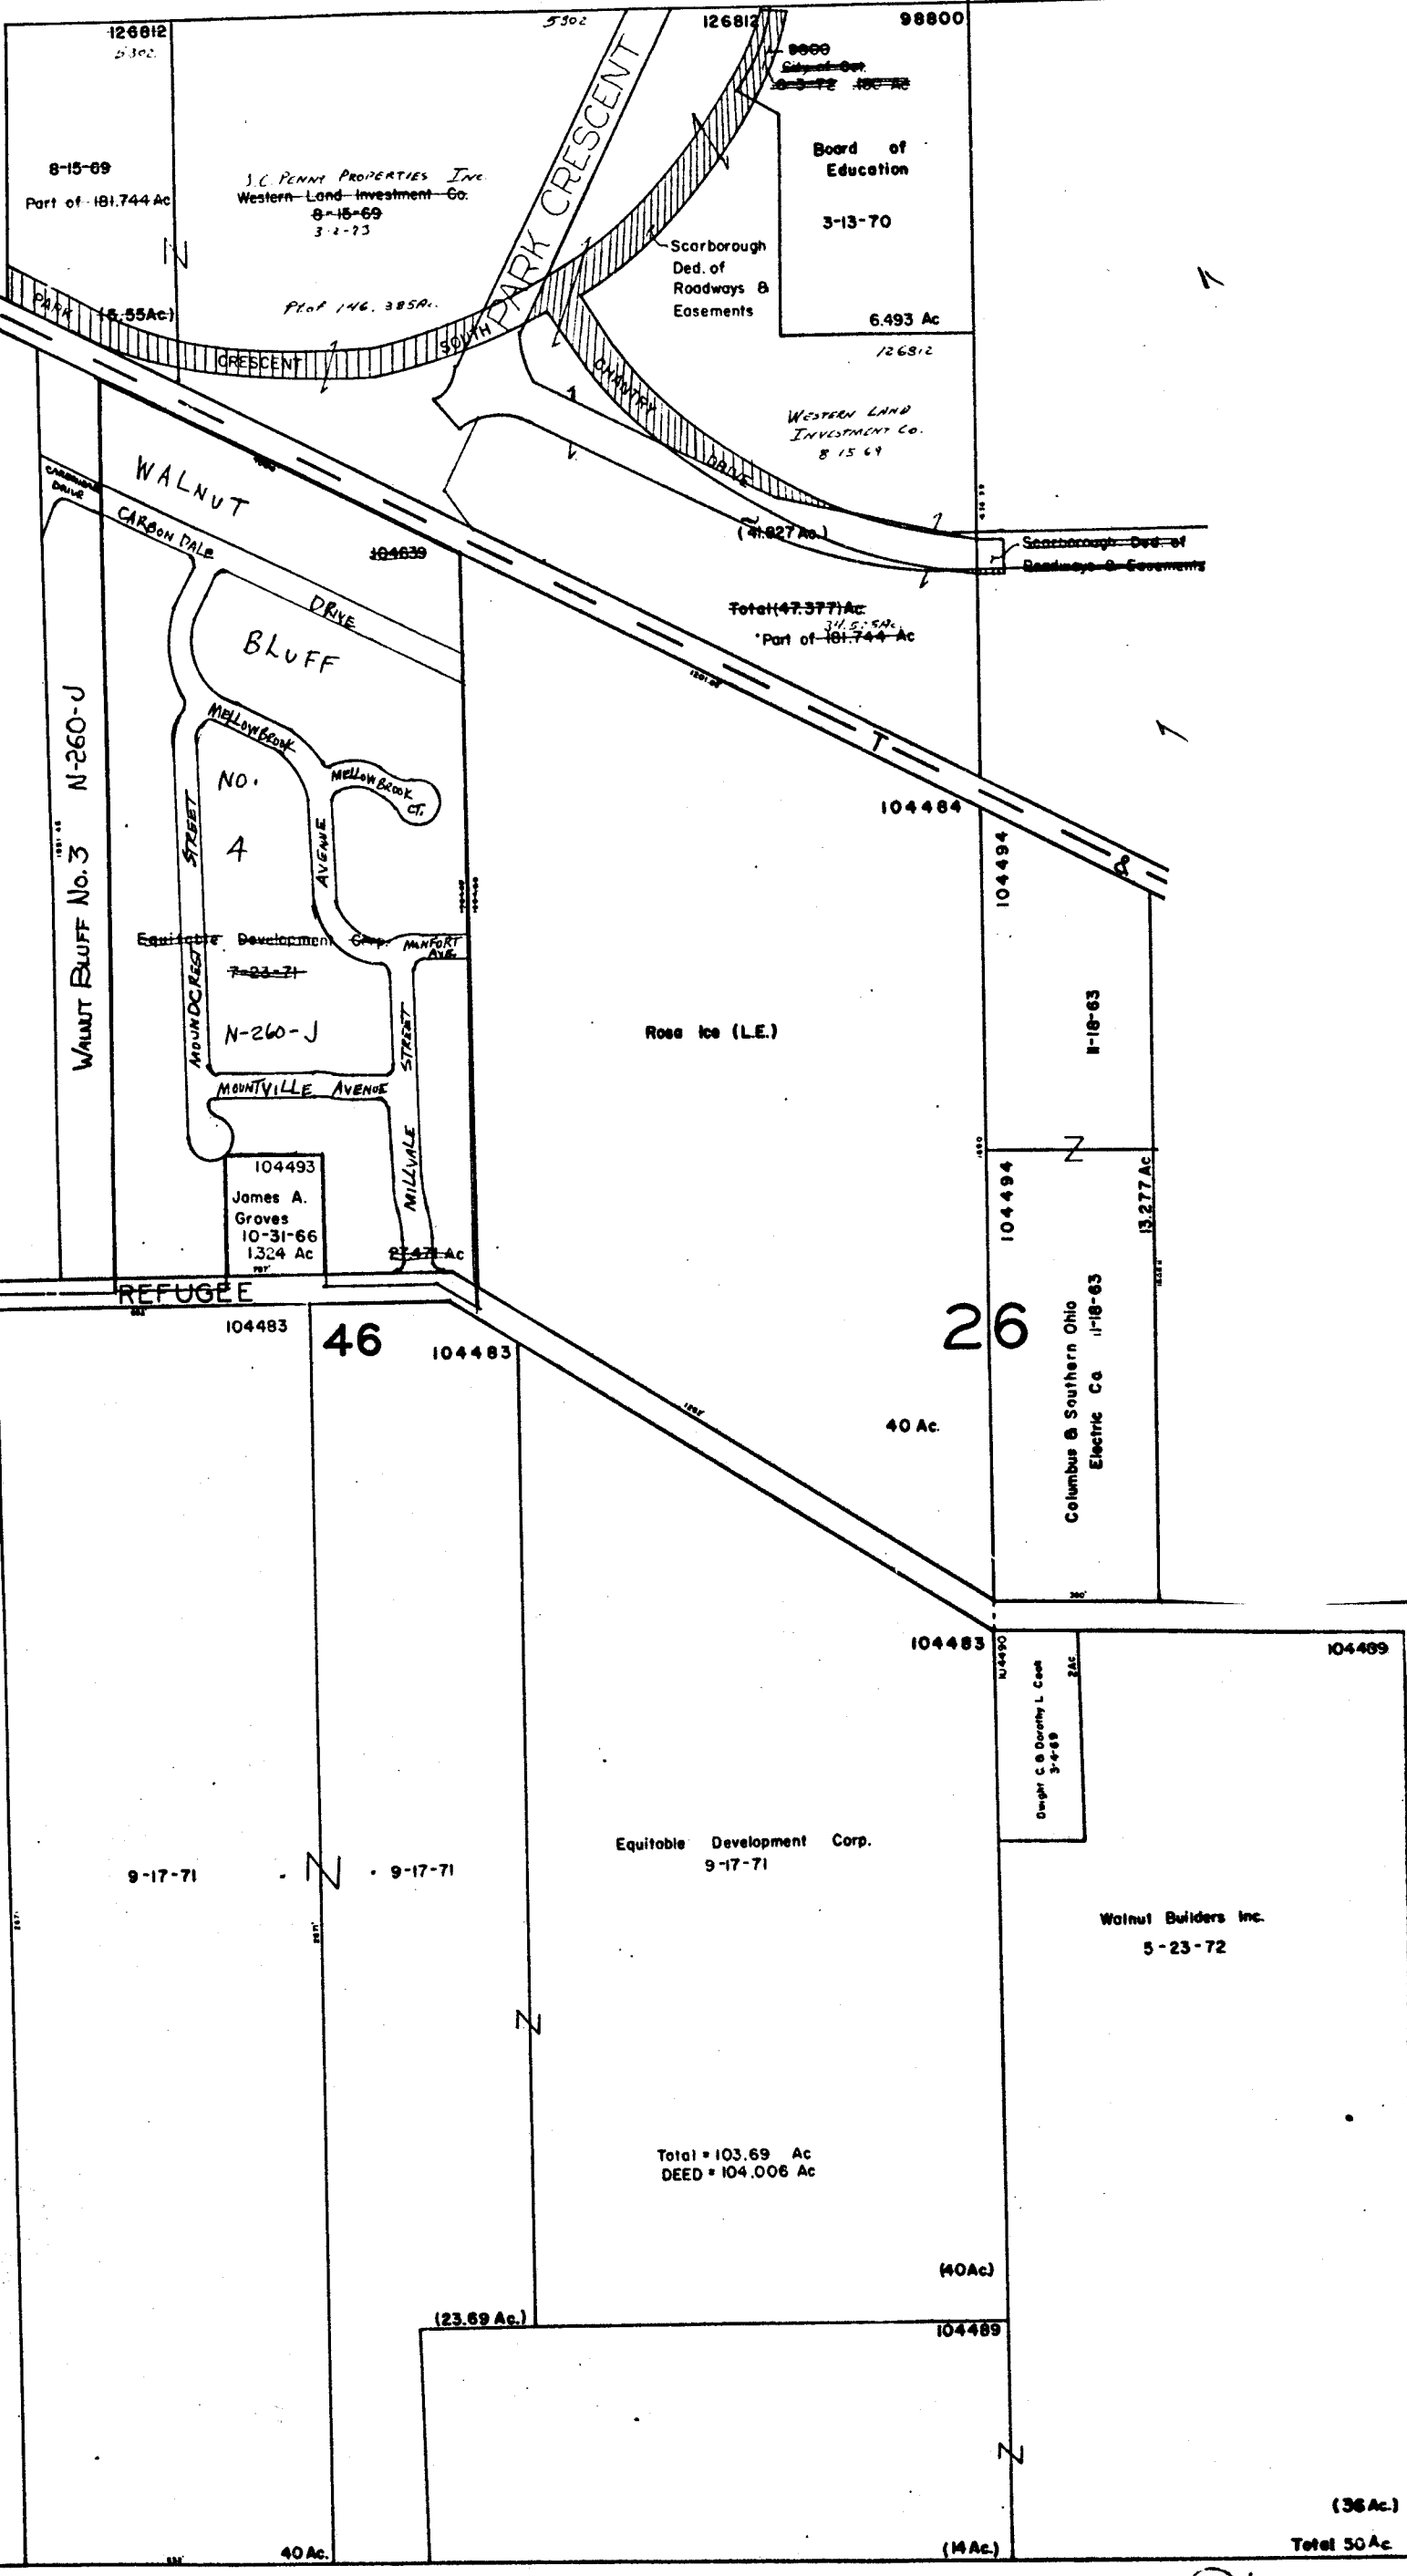

0
100
E

0
42

O-104-F

TRURO TWP


R. 21 TWP. 12



SCALE: 1"=200'
TAXING DISTRICTS
CITY OF COLUMBUS
TRURO-MADISON S.D.
BRICE CORP.

- ① 8823 City of Col. 5-26-72 .115 Ac Ord. No. 841-72
- ② 8839 City of Col. 5-26-72 1.059 Ac Ord. No. 841-72
- ③ 8852 City of Col. 5-26-72 .295 Ac Ord. No. 841-72

0 105

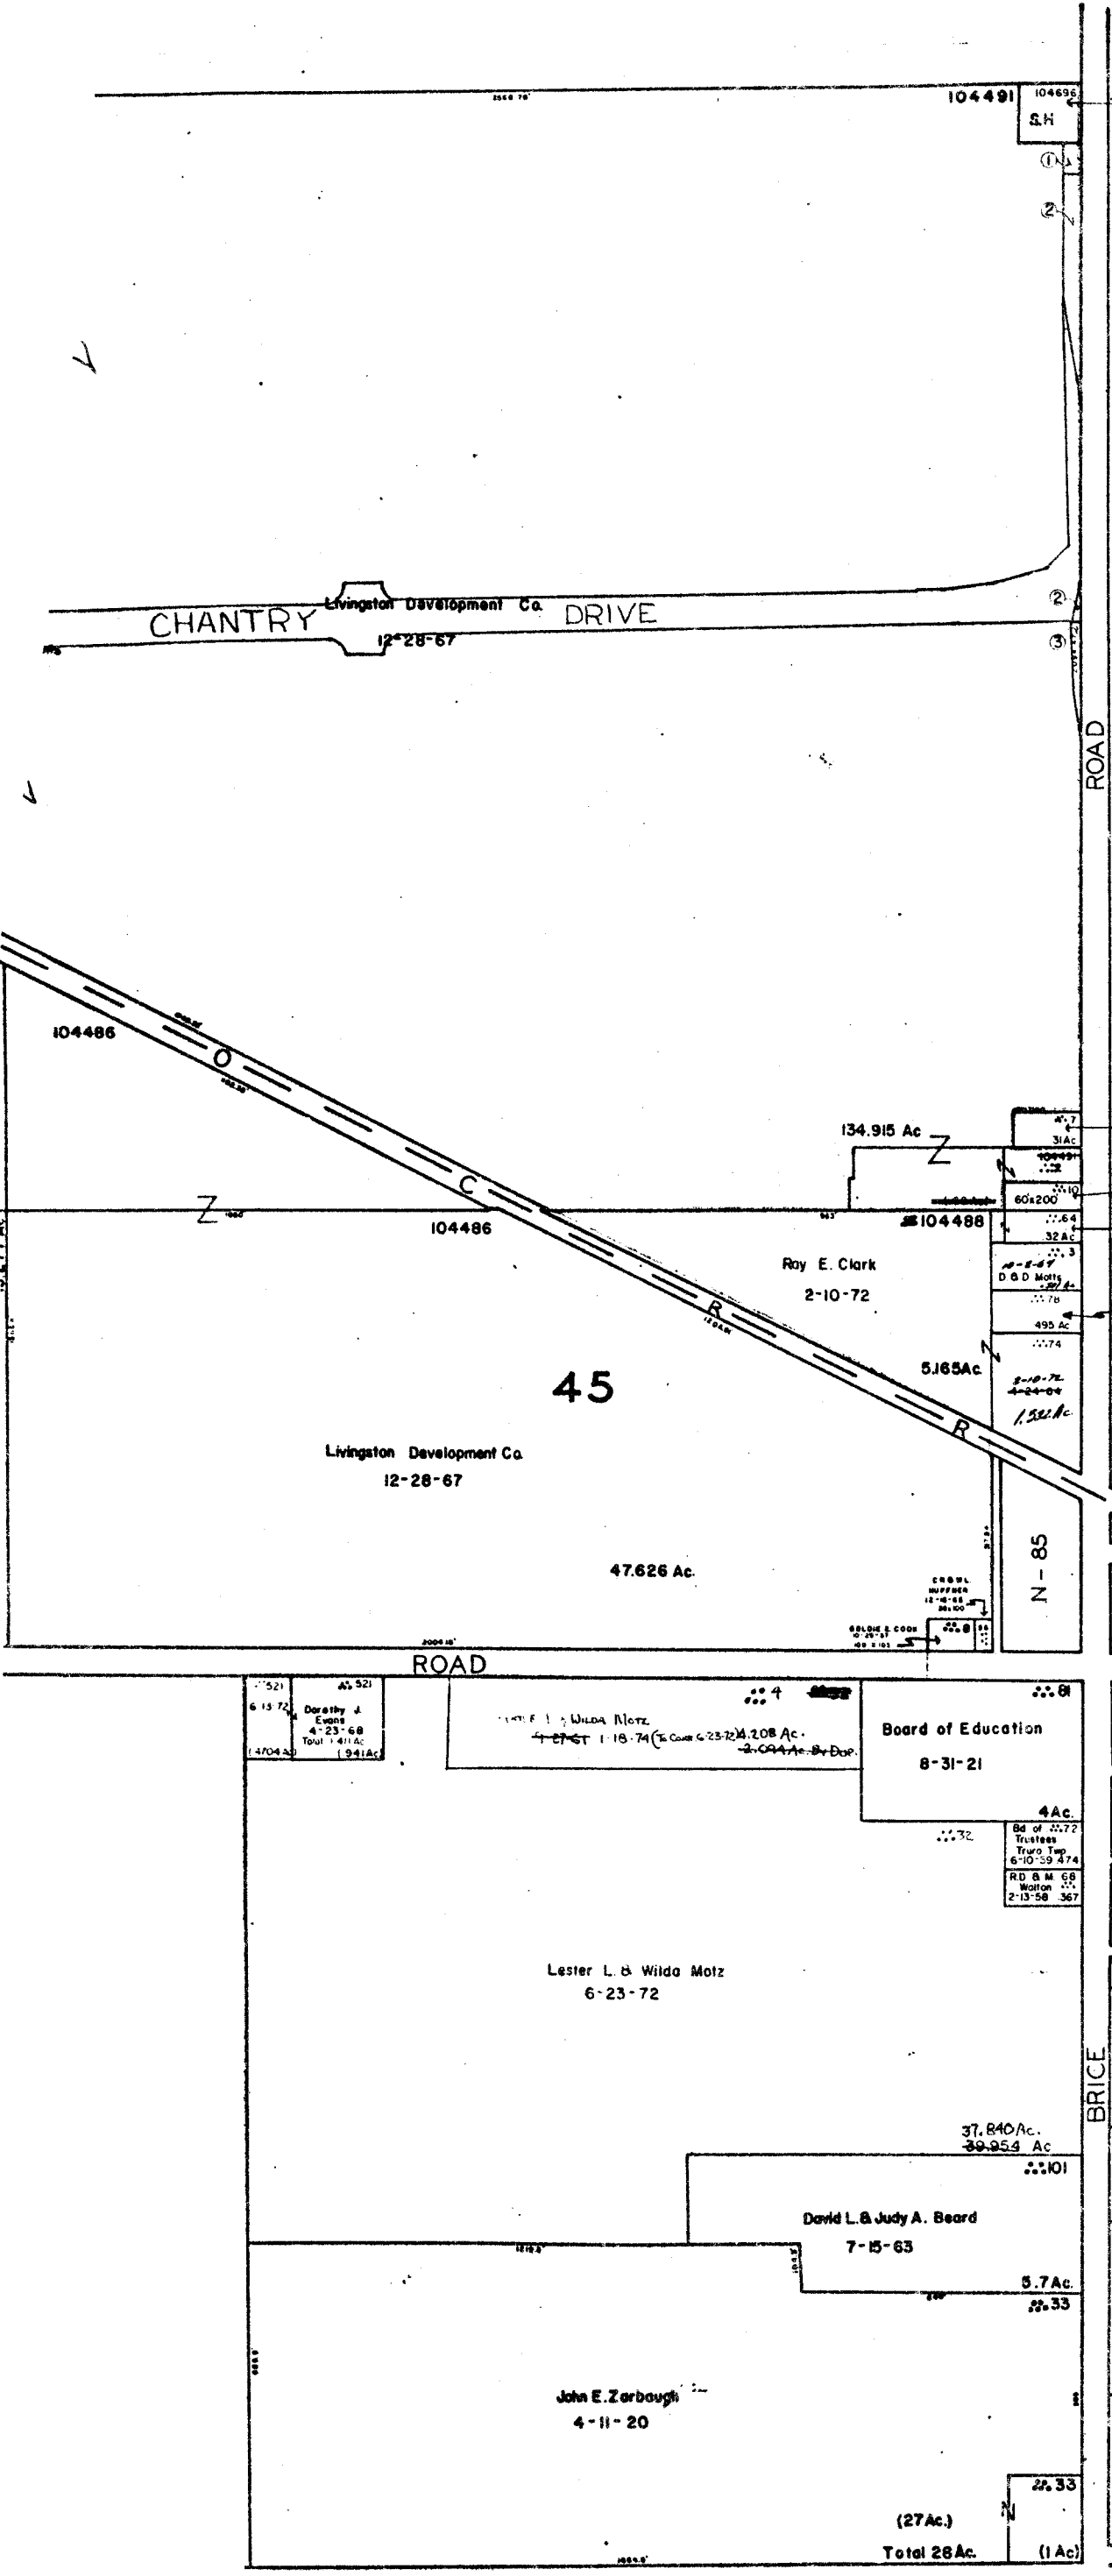

| | | | | |
|---|----|---|---|---|
| B | R | I | C | E |
| | | | | |
| | | | | |
| | N- | 8 | 5 | |

0 105

0-105

TRURO TWP

O-104-F

T W P.

4077