


0 98 D

180 T

SHARON

13

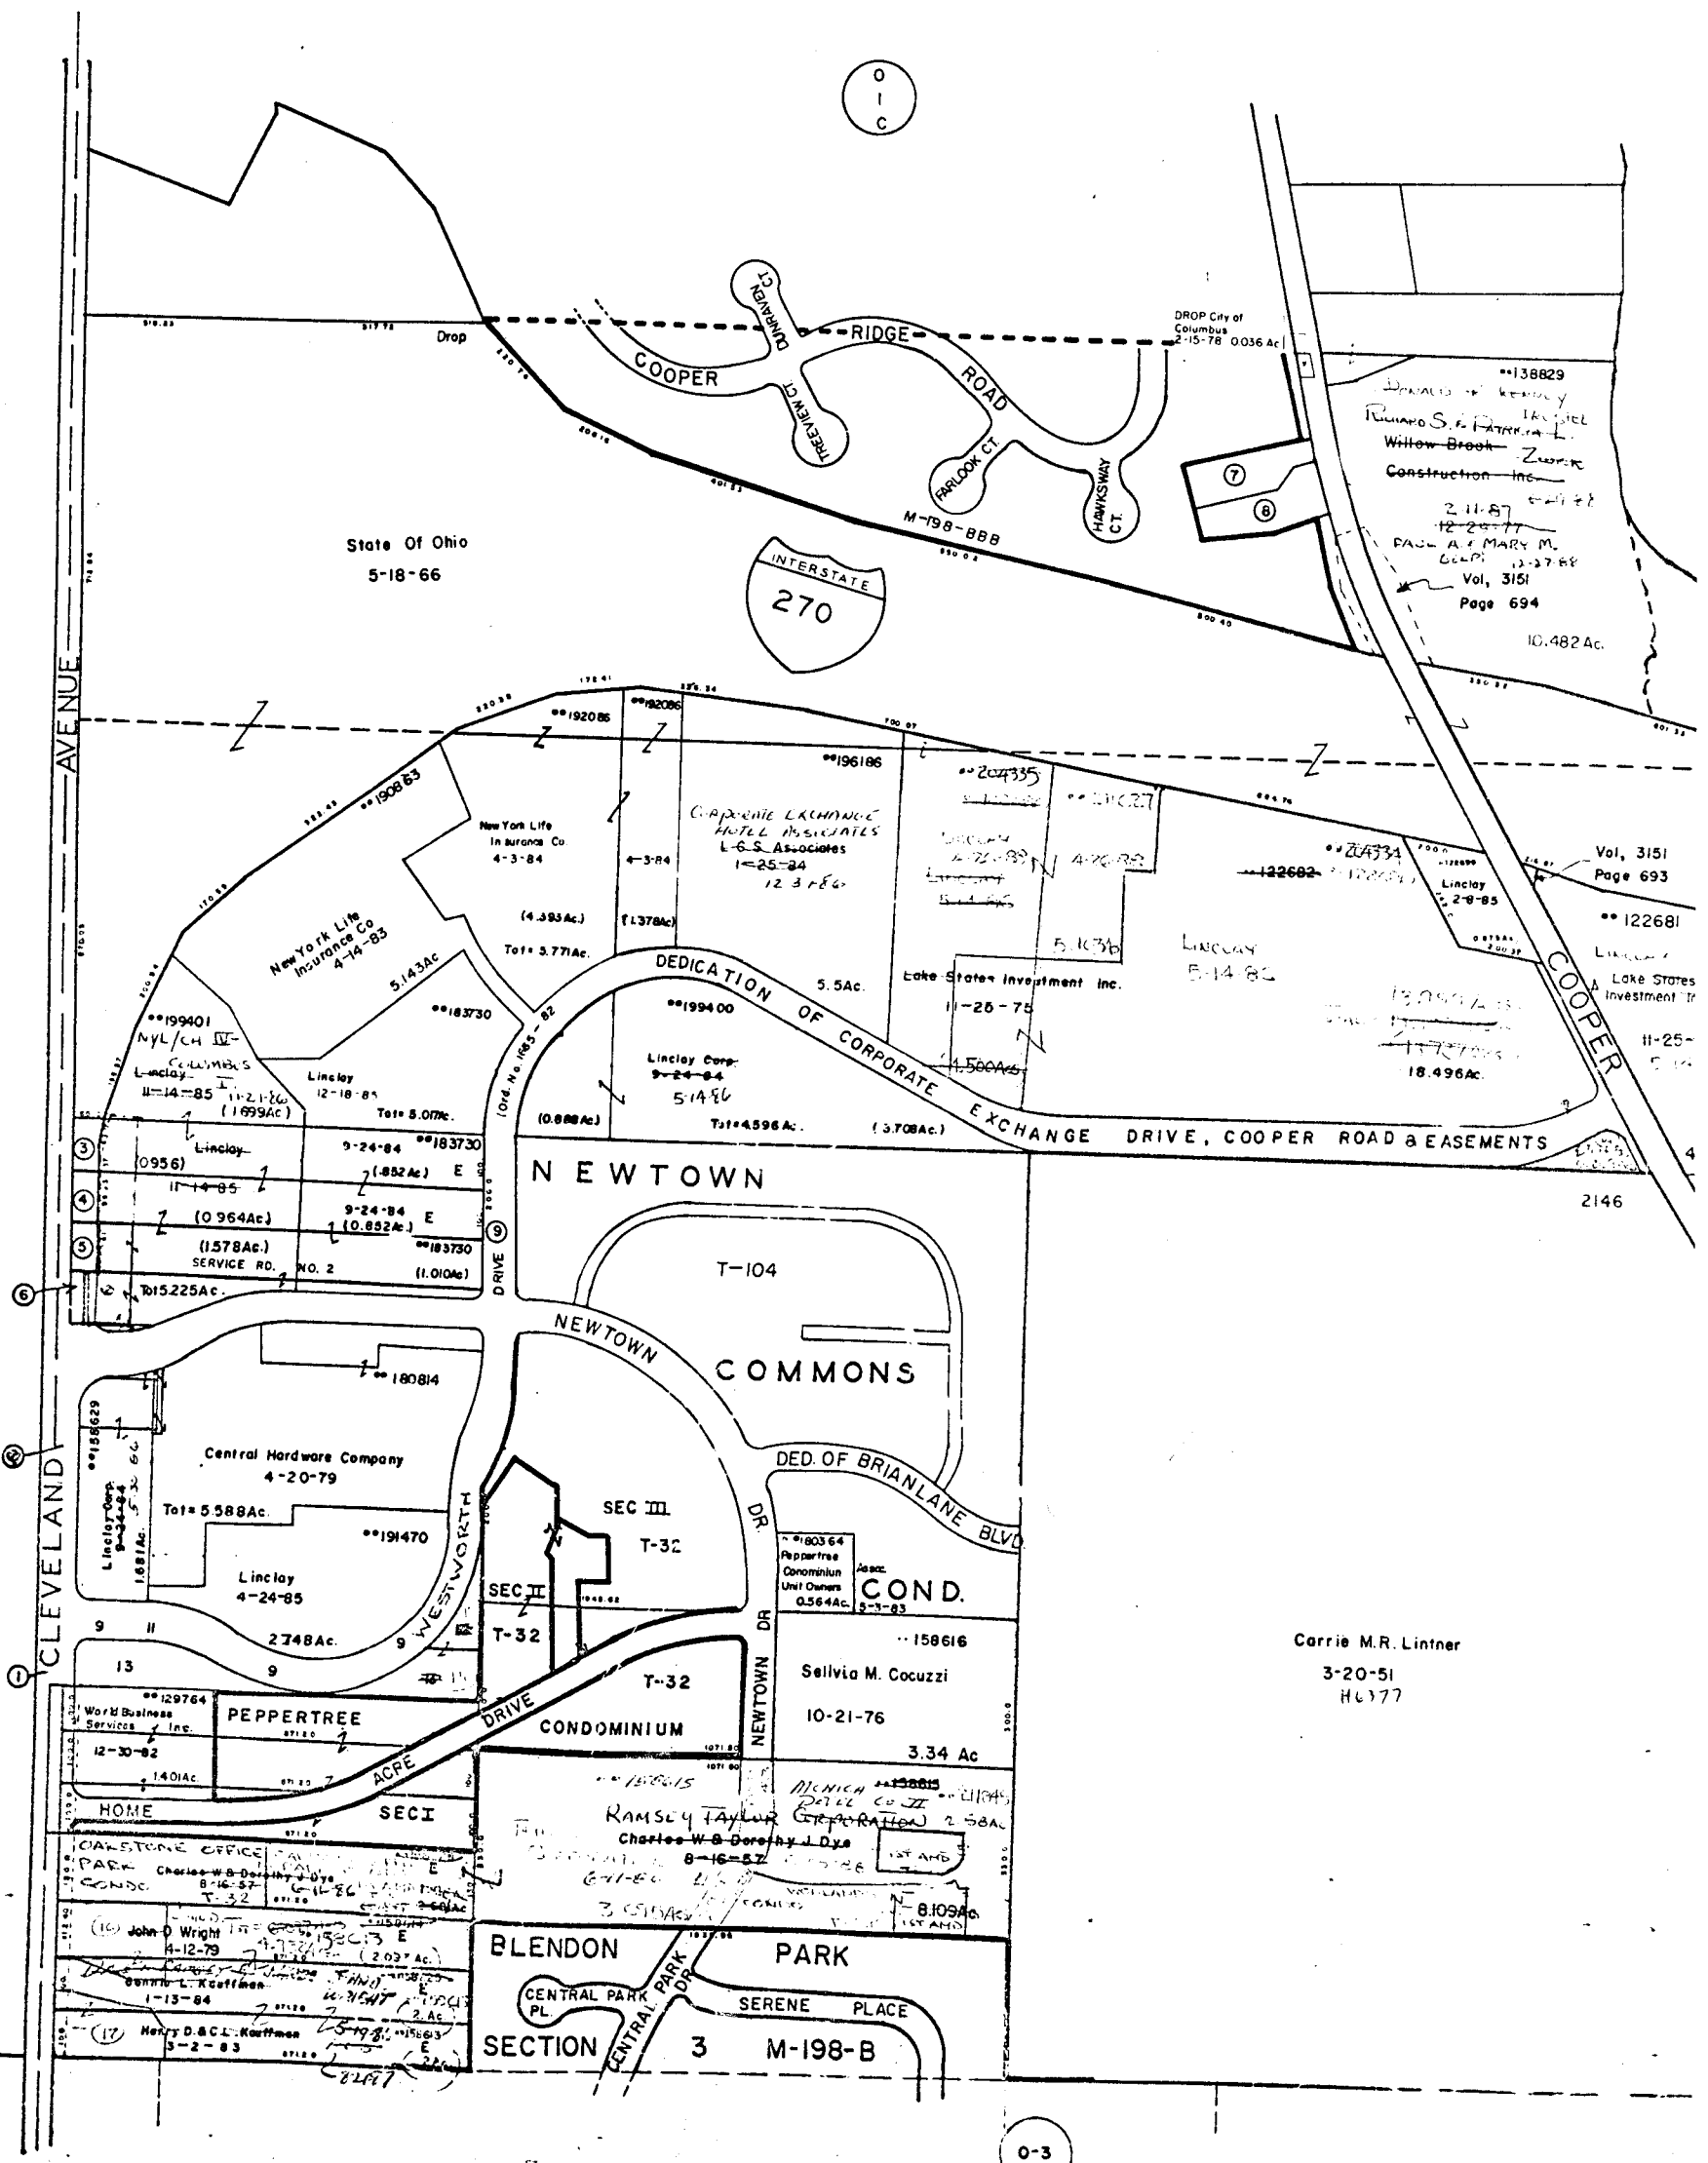


0-3 A

O-I-F
 BLENDON TWP.
 R.17 TWP. 2



SCALE 1"=200'
 E= HIGHWAY EASEMENT

TAXING DISTRICTS	DISTRICT CODE
BLENDON TWP.	110
**COLUMBUS-WESTERVILLE	600
H--- HOUSE NUMBERS	

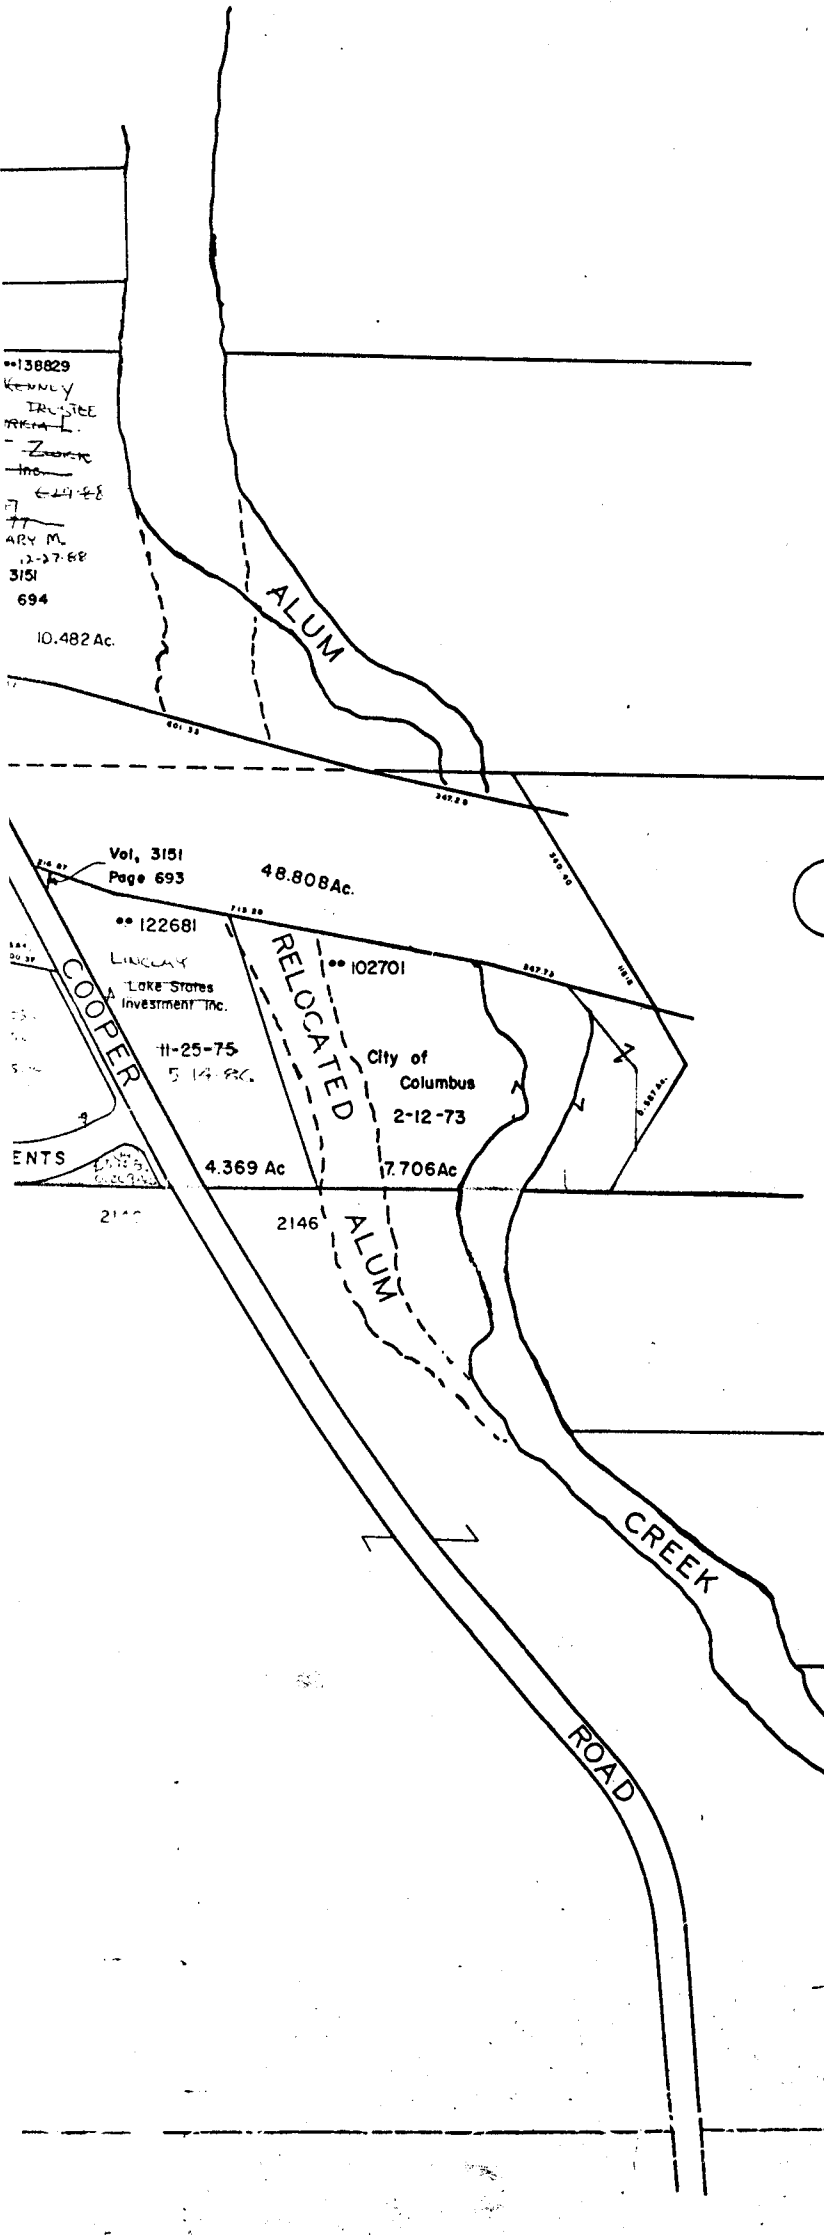

- ① Drop Franklin County Commissioner 10-22-81 0.092 Ac. (In Road) (C.C.P. 230422)
- ② 180813 LINCOLN CORP. OF CINCINNATI 10-6-74 1.046 Ac. Part of 3.971 Ac.
- ③ DROP State Of Ohio 1-18-66 0.192 Ac.
- ④ DROP State Of Ohio 4-1-66 0.184 Ac.
- ⑤ DROP State Of Ohio 6-6-66 0.185 Ac.
- ⑥ DROP State Of Ohio 6-6-66 0.152 Ac.
- ⑦ 175617 WFR. Properties 9-1-81 0.465 Ac.
- ⑧ 182491 Rebecca J. Vaas 9-19-79 .515 Ac.
- ⑨ Dedication of Westworth Drive & Cleveland Ave. Westworth Drive Changed To Corporate Exchange Drive (Ord. 1665-82)
- 10 Newtown Commons Condominium T-104
- 11 Ded. Of Community Park Dr. And Portions Of Cleveland Ave. And Westworth Dr.
- 12 180813 LINCOLN CORP. OF CINCINNATI 11-2-82 1.355 Ac.
- 13 180812 LINCOLN CORP. OF CINCINNATI 4-20-79 0.985 Ac. 0.424 Ac.
- ⑭ 122682 LINCOLN 5-14-86 0.269 Ac.
- ⑮ 21115 RESURBUS CONDOMINIUM ASSOCIATION 3-1-88 0.559 Ac.
- ⑯ 21270 JOHN D. WRIGHT 9-13-88 0.701 Ac.
- ⑰ 21274 JOHN D. WRIGHT 9-13-88 0.664 Ac.

O
I
G