

H-7352	
H-7316	M. J. Long & Weaver
H-7339	Mary Roger
H-7278	Steven E. & Diane S. Galters
M-203-C	HO
H-7250	LEWIS & R. J. WETZLER
H-7230	Leonard F. & Diane Kirby
M-203-C	M-
M-203-C	M-203-C
H-4387	Keith F. Brudbury
H-4403	2054
H-4415	3982
H-4415	Ralph L. & JoAnne L. Markless
M-203-C	MR. B. L. HOOR


0-2-F
BLENDON TWP.
R17 TWP.2



SCALE 1" = 200'
E = HIGHWAY EASEMENT

TAXING DISTRICTS	DISTRICT CODE
BLENDON	110
H---HOUSE NUMBERS	

200

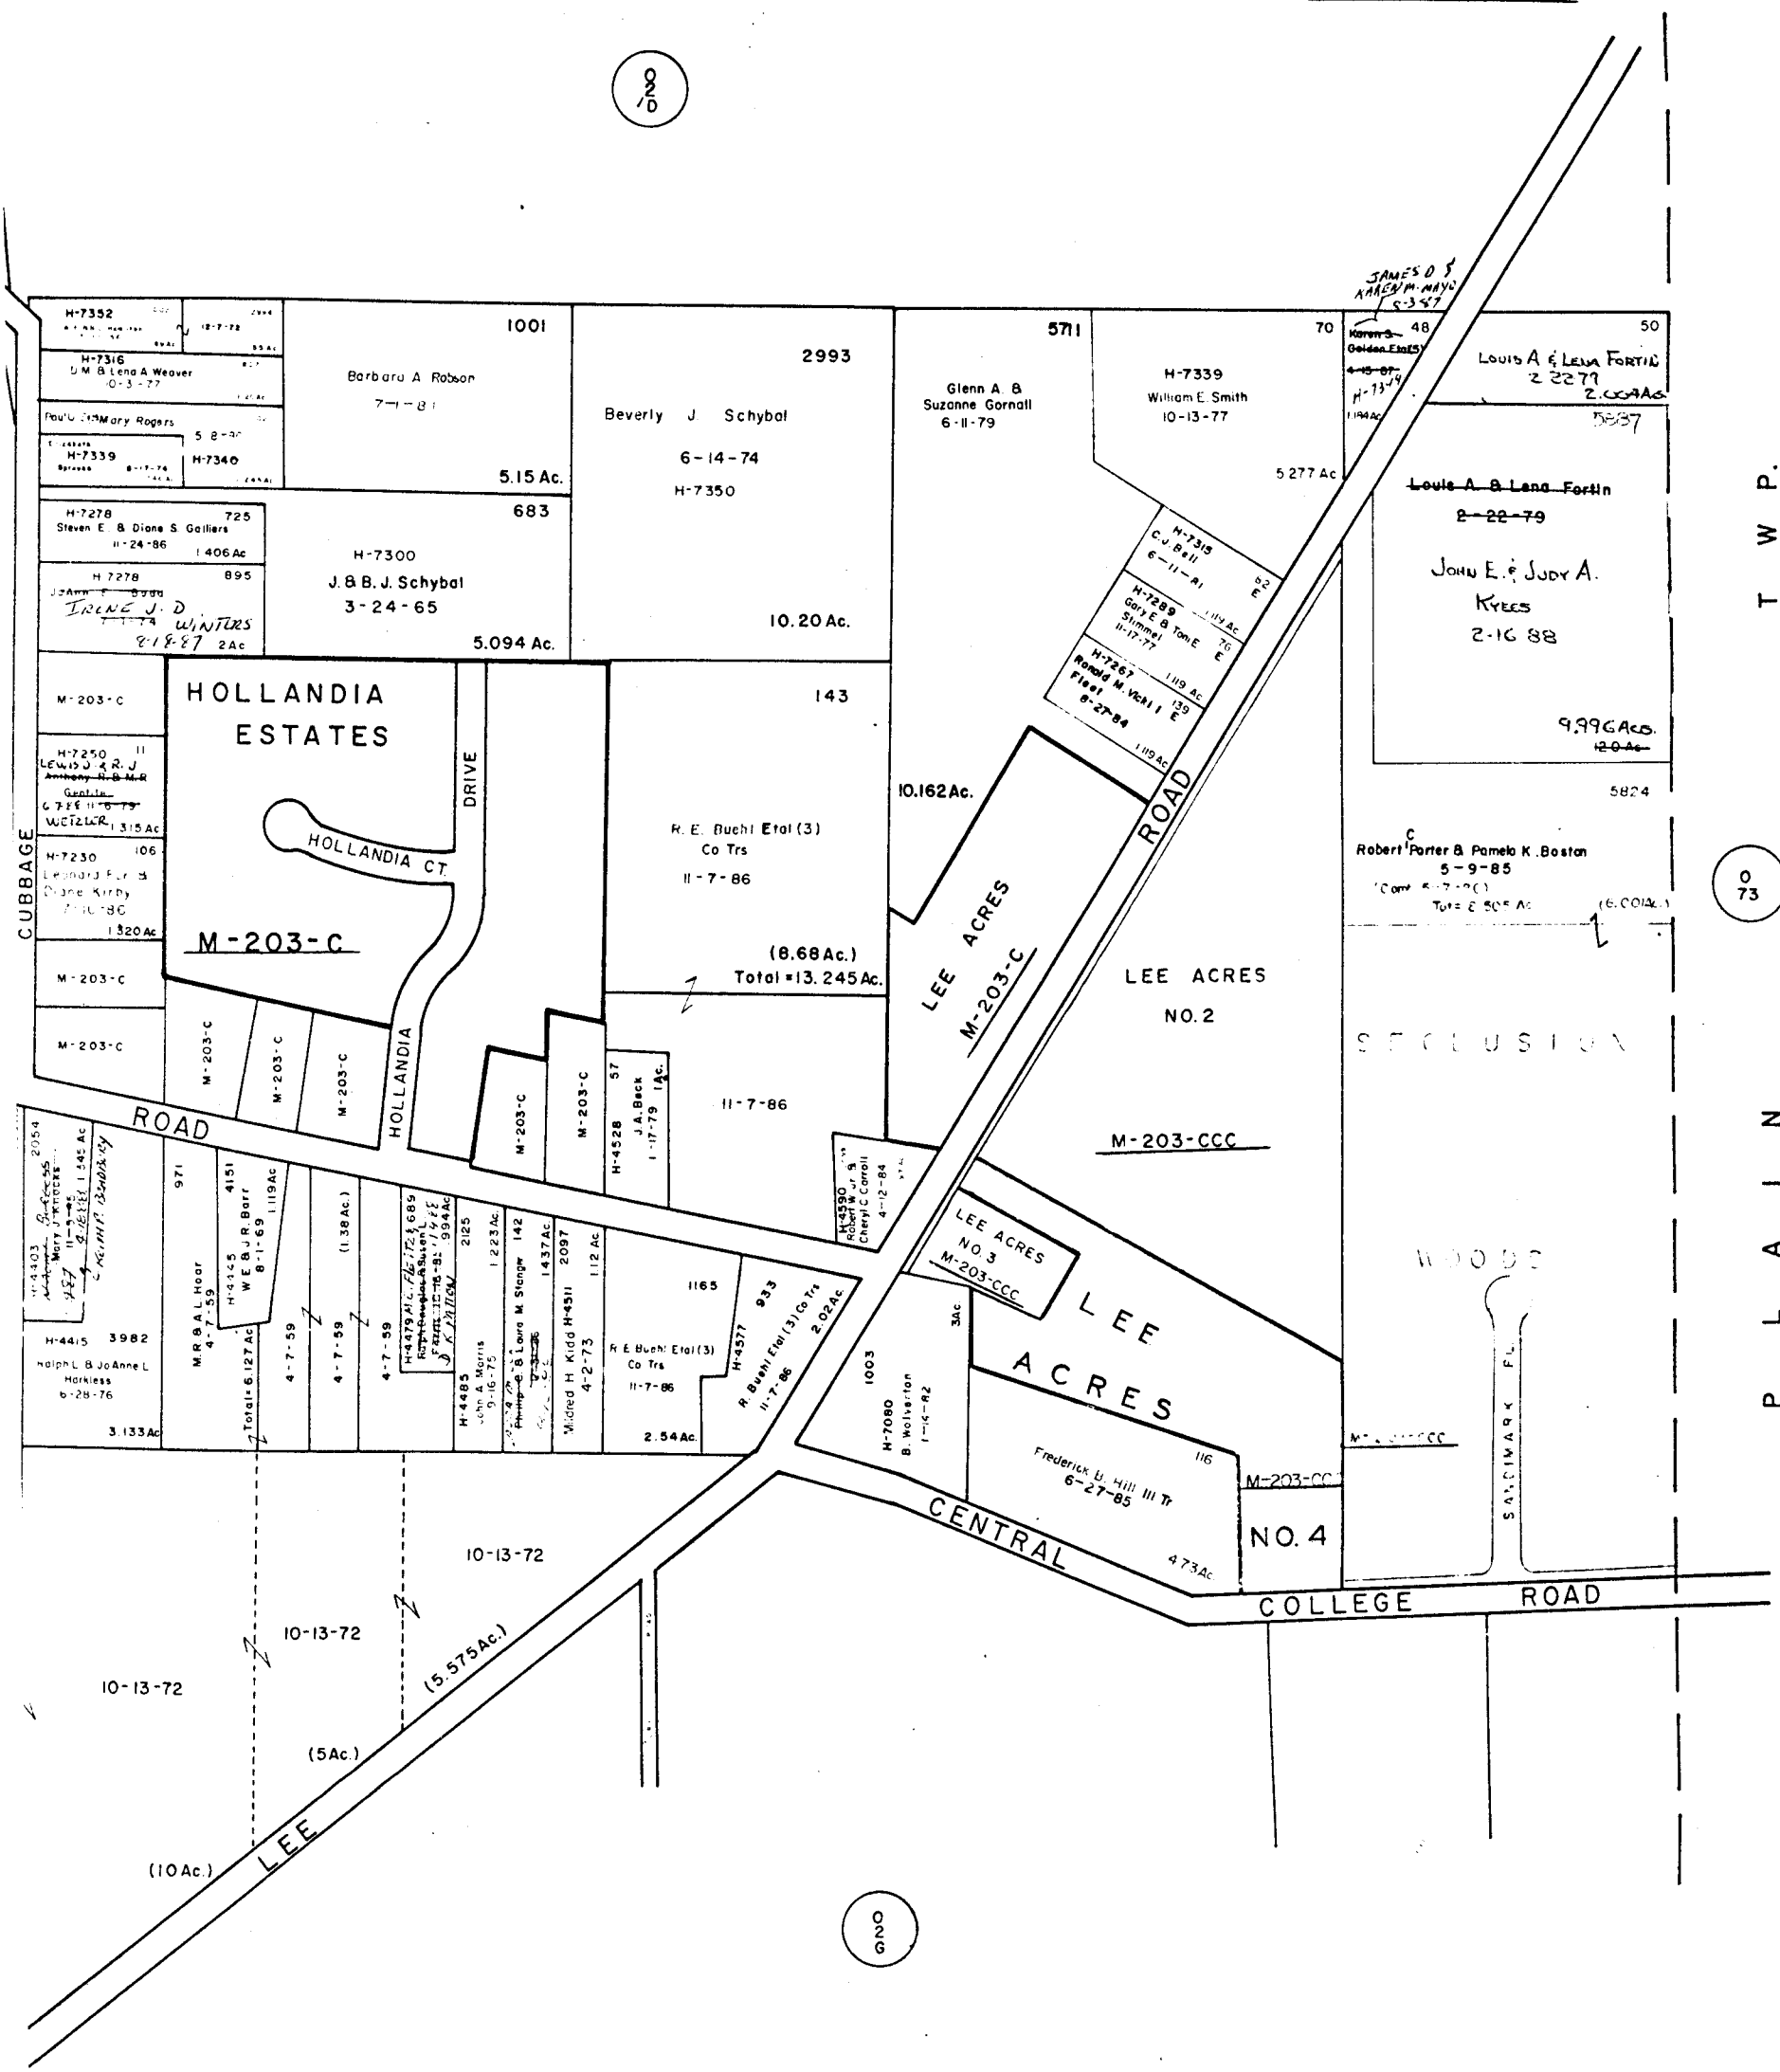

073

T W P .
P L A I N

200