
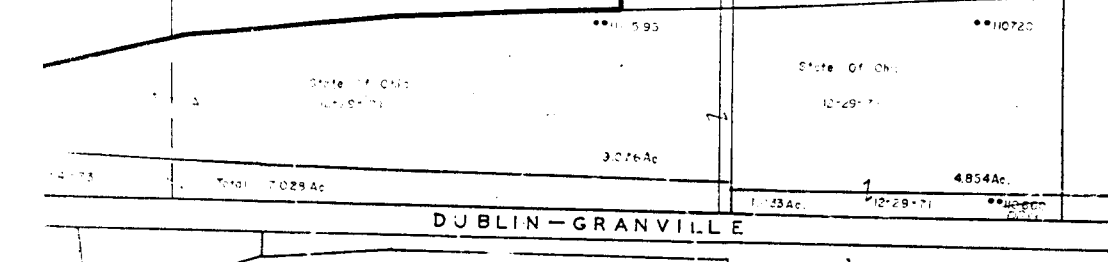
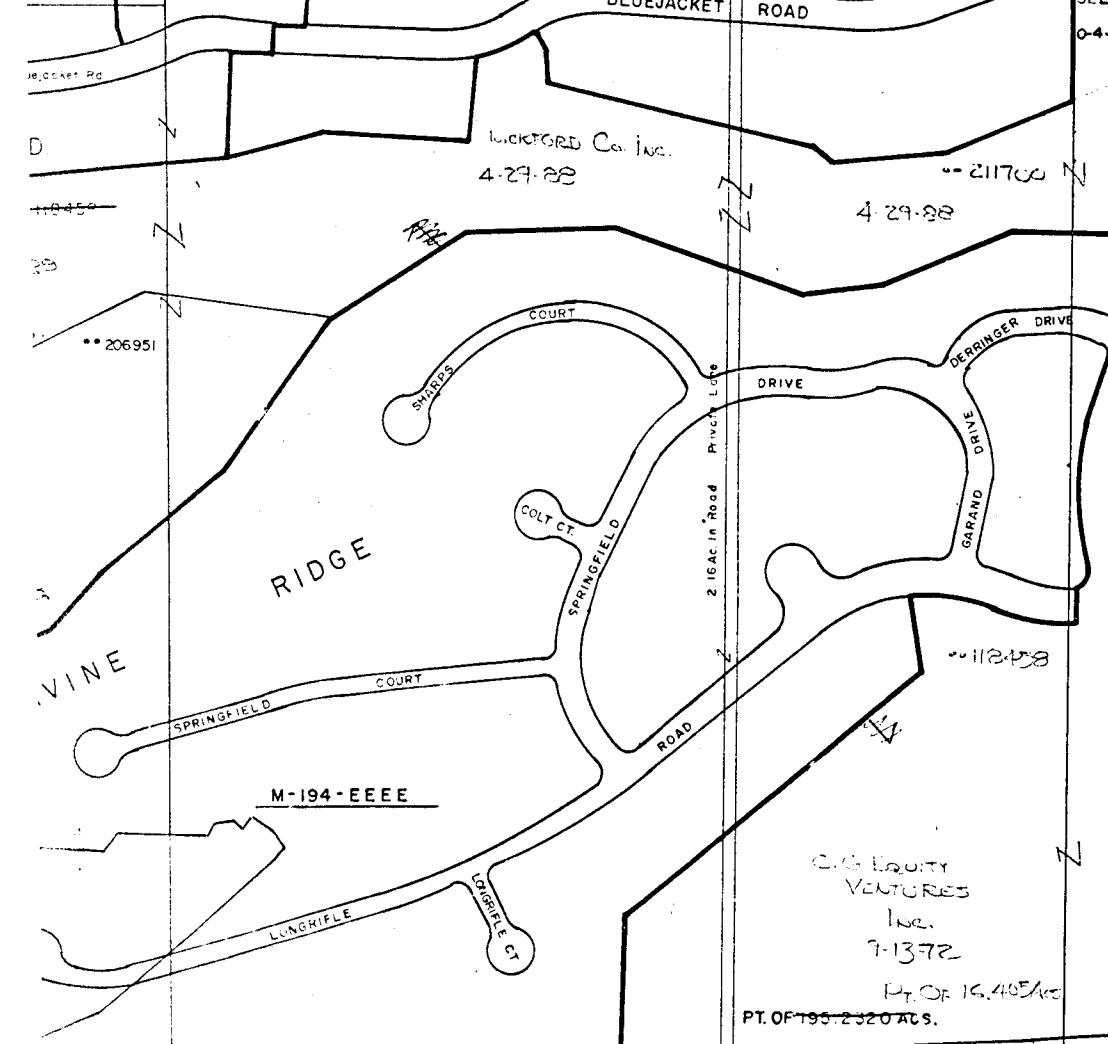
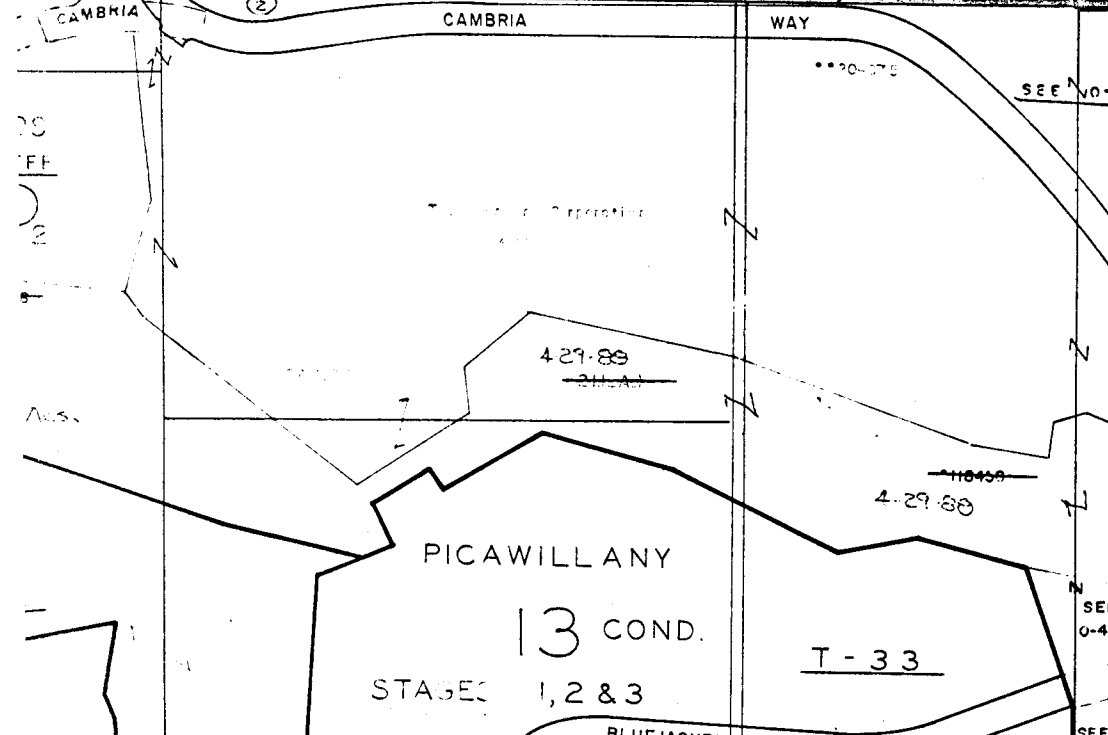


0-4-B
BLENDON TWP
R.17 T WP2

SCALE 1" = 200'

TAXING DISTRICTS	DISTRICT CODE
BLENDON TWP.	110
CITY OF WESTERVILLE	600
COLUMBUS-WESTERVILLE S.D.	600
E-HIGHWAY EASEMENT	
COLUMBUS	010
H-HOUSE NUMBERS	

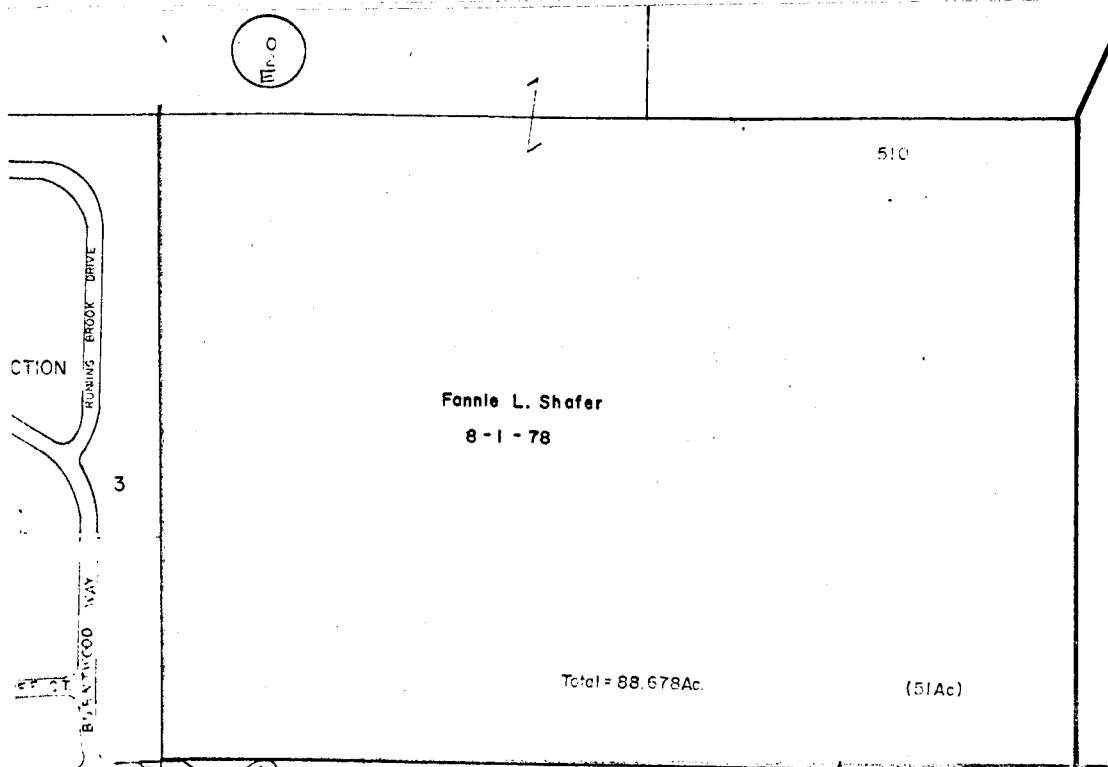

ROLLING RIDGE

14

0
4
C

- ① -- 21125 C.G. EQUITY VENTURES INC. 3-10-88 0.217 ACs
- ② -- 21127 WICKFORD Co. Inc. 4-29-88 0.524 ACs

0-4-B

