

4

Board of Park Commissioners  
5-16-73

68.753 Ac

11.037 Ac

T-85  
DARYNGTON PLACE COND. NO. 1  
T-85  
DARYNGTON PLACE COND. NO. 2

T-38 No. 2  
WALDEN VILLAGE COND. No. 1

WALNUT CREEK  
CHILICO  
BIG WALNUT  
WILDROSE  
ING DRIVE SIDE  
NEW ORD. NO. 1137-85  
AWARDED ORD. NO. 9712-85  
VACATED TO THIS PLAT ONLY

BEECHWOOD DR.  
MAPLEWOOD DR.  
ENGESIDE DR.  
MARCELLA DR.

Fred L. Lynch Etal(4)  
11-13-80  
H-5545

Alex. & Mildred Russo  
4-12-72

Diana E. Gebaugh  
11-12-68

Robert F. Malone  
11-7-71

Floyd P. Jones  
8-4-76

City of Col. 3-27-73  
1178 Ac

Walden Village Assoc.  
12-6-78  
0.381 Ac

Dreyfus Interstate Development Corp.  
12-22-72

Board of Park Commissioners  
1-21-66

O-4-E

BLENDON TWP  
R.17 TWP2




SCALE 1"=200'

E=HIGHWAY EASEMENT  
TAXING DISTRICTS DISTRICT CODE  
BLENDON TWP. 110  
\*\*COLUMBUS-WESTERVILLE SD. 600

① \*\*11266 BO OF PARK COMMISSIONERS 1-23-63 1238A

H--- HOUSE NUMBERS

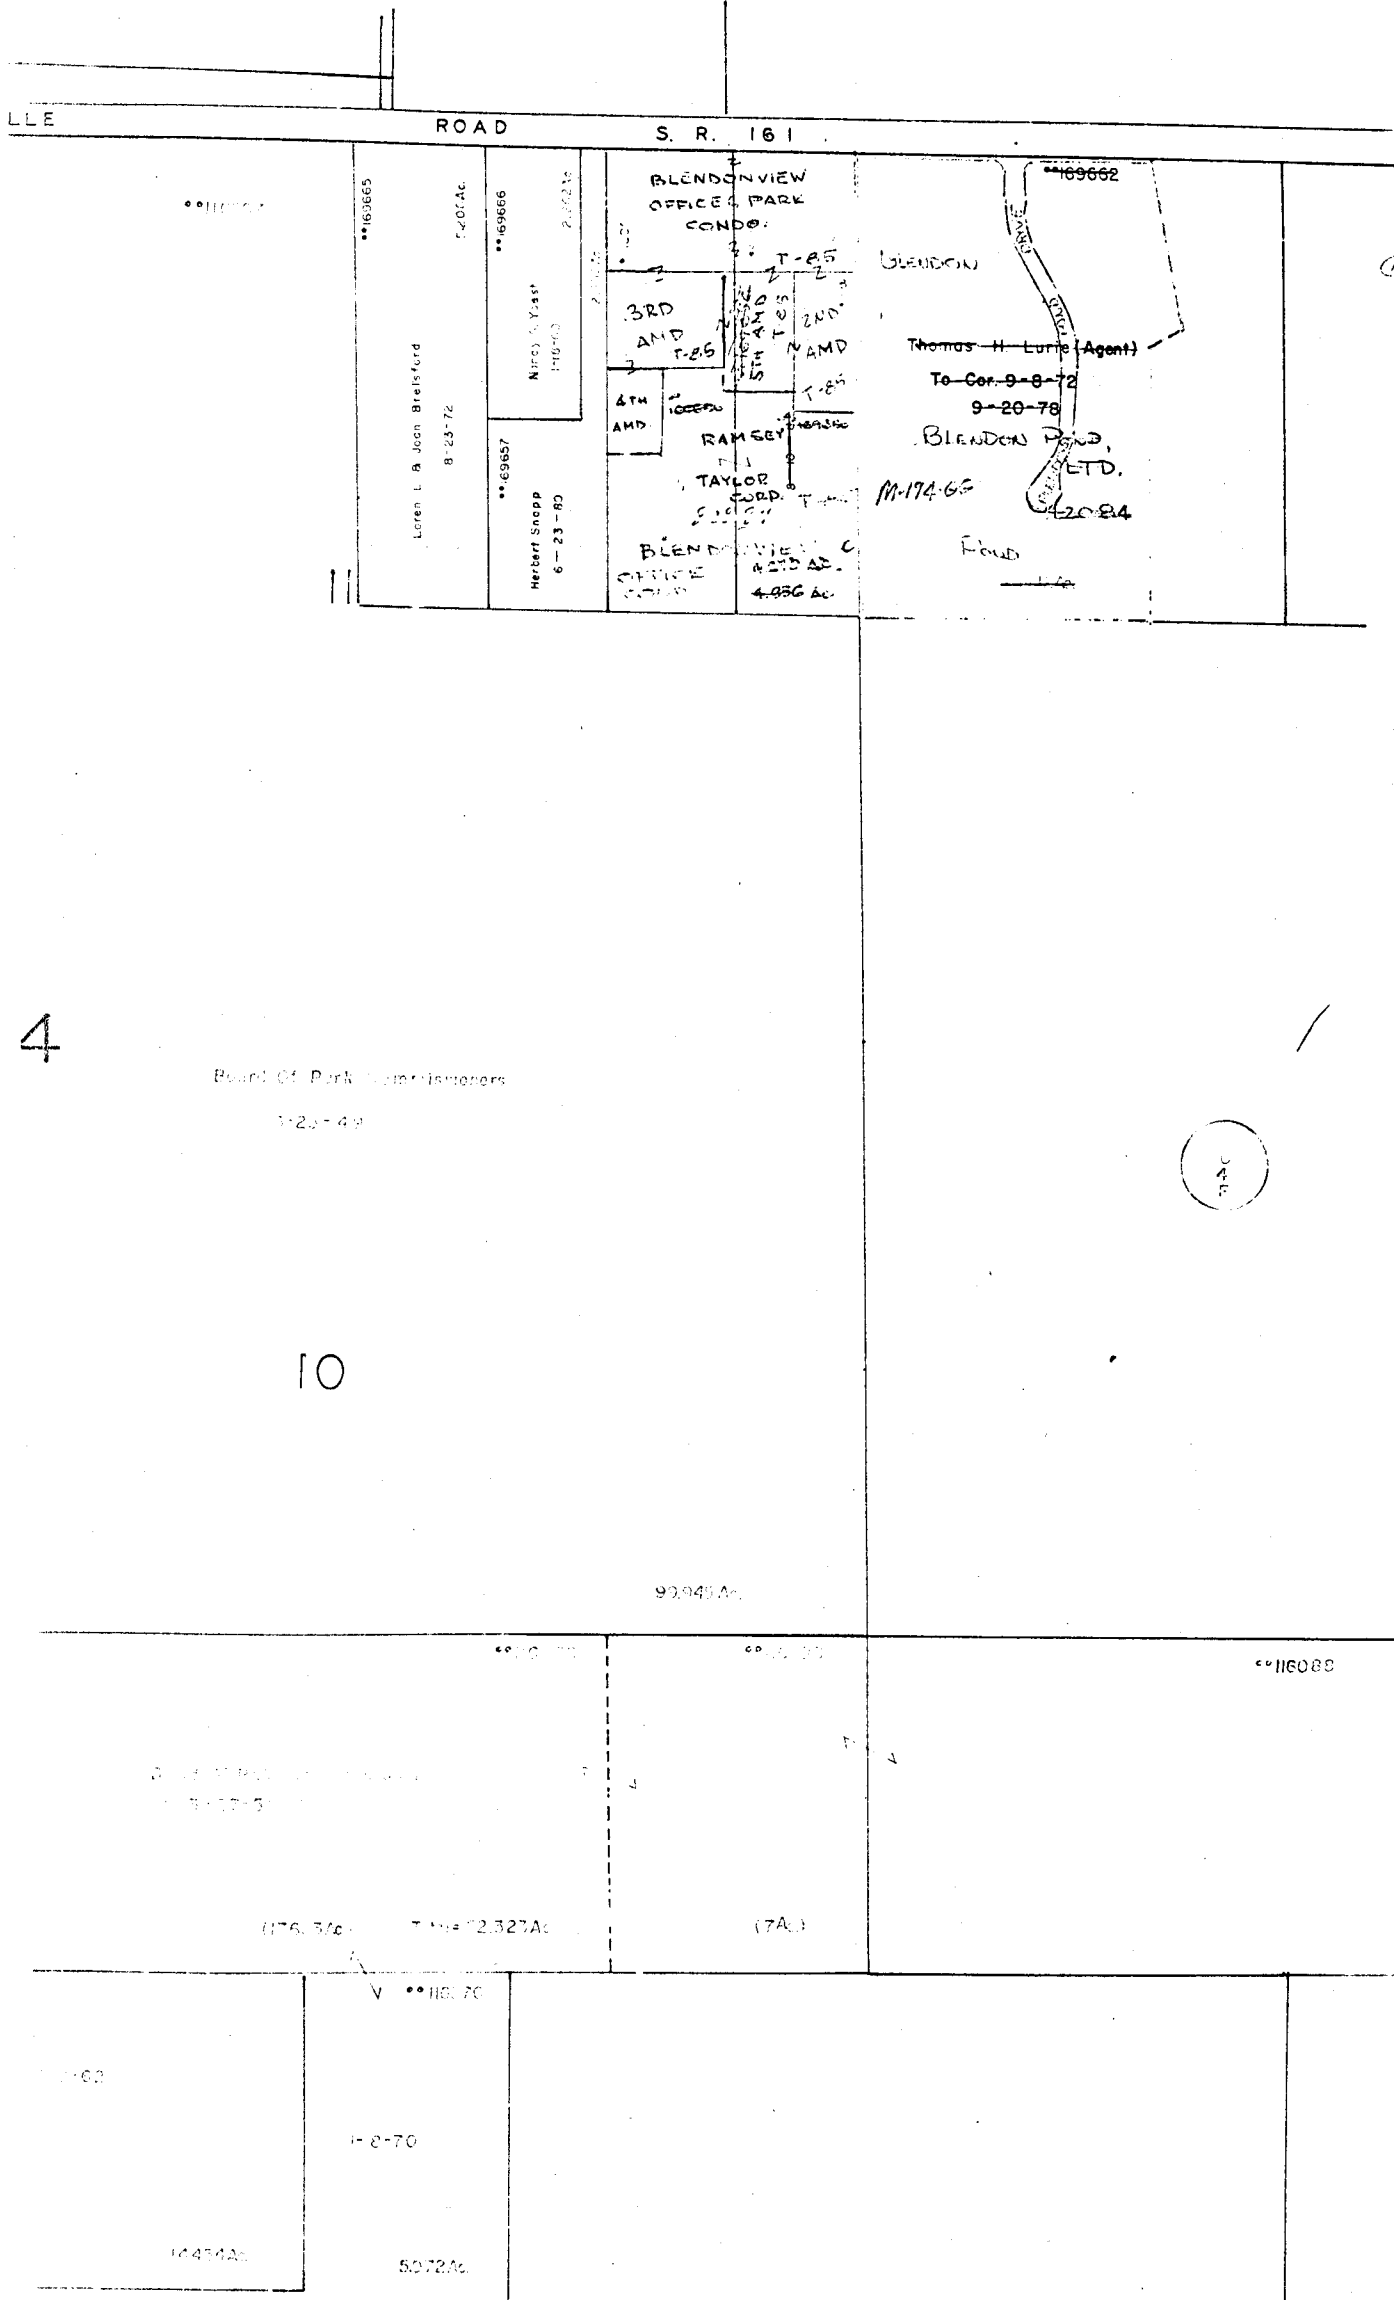

O-4-E