


O  
S  
B

O  
S  
C

O  
S  
A

14788

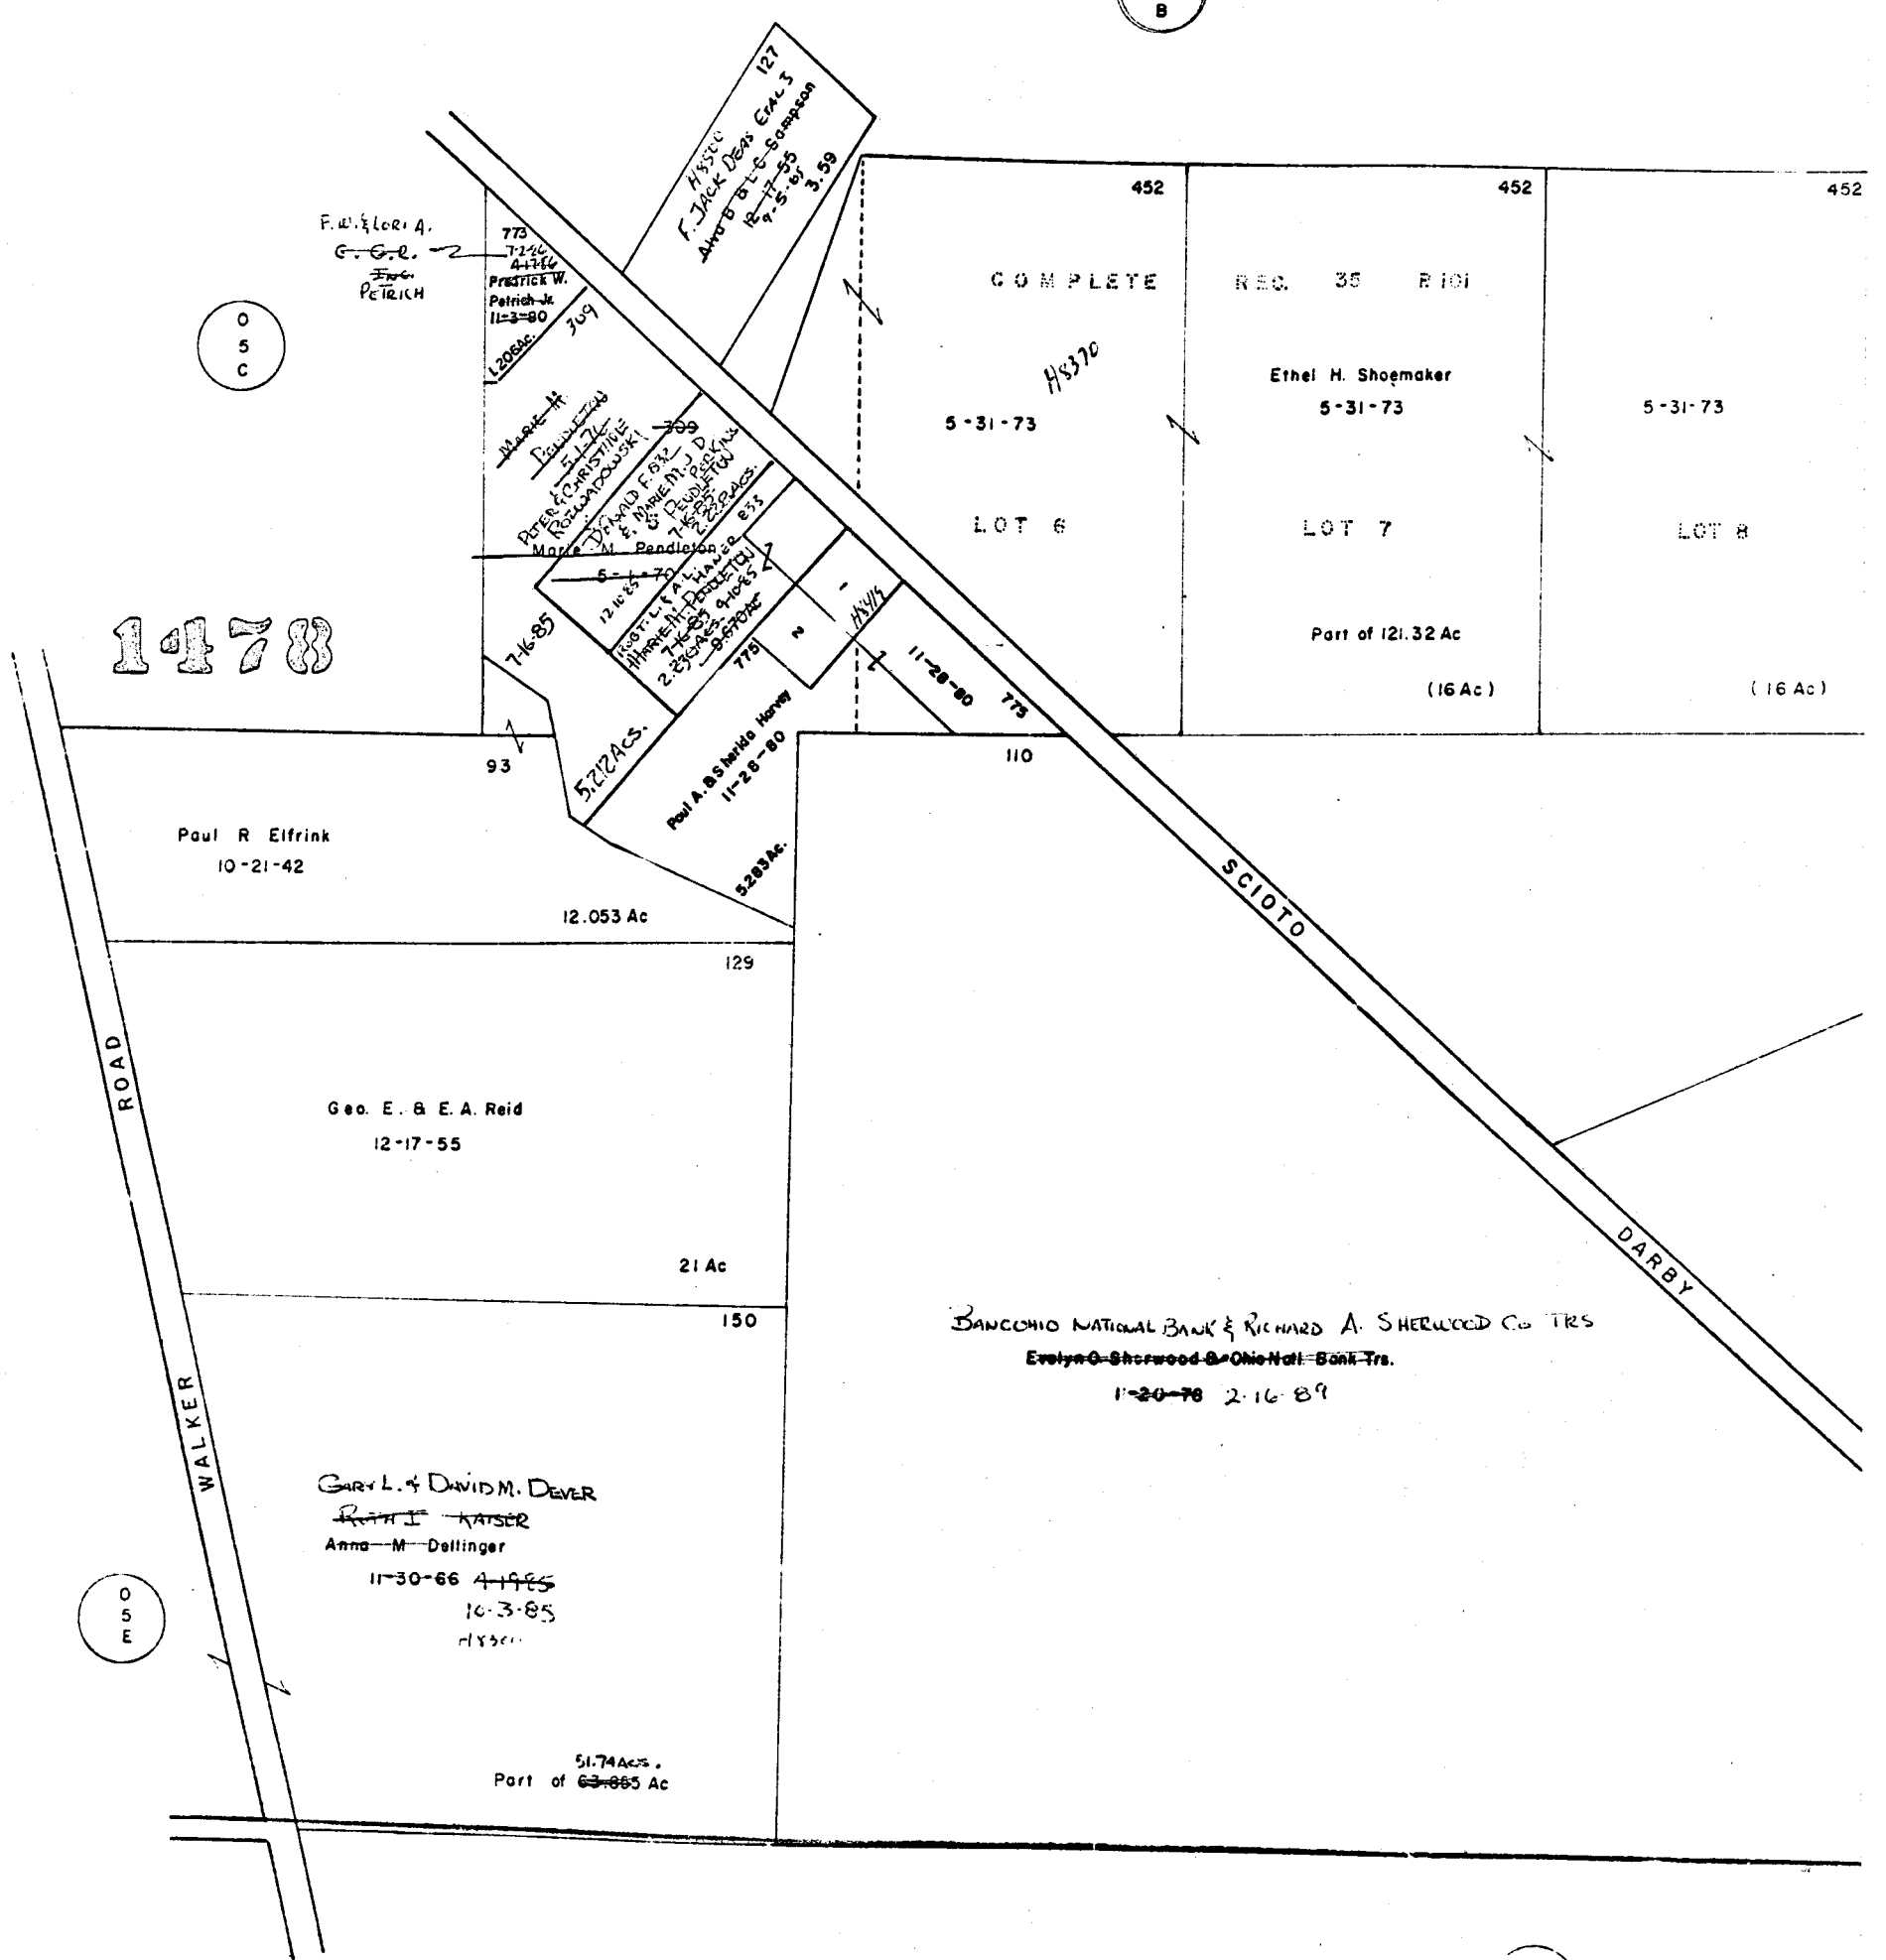

|       |                             |         |           |
|-------|-----------------------------|---------|-----------|
| 1-768 | Paul A. & Sherida M. Harvey | 11-2-81 | 0.603 Ac. |
| 2-769 | George L. Shaffer           | 6-24-80 | 0.465 Ac. |
| 3-597 | Ellen Long                  | 6-27-80 | 0.546 Ac. |

