

54

152
Notes
Bridges
11-14-53
0.75%

3-18-63

COUNTY

CREEK

James E. & Barbara A. Muscott
6-30-74 4.15 Ac.

5.01 Ac.

Total = ~~15.01 Ac.~~
15.01 Ac.

Theodore H. & Jean M.
2-15-74

DARBY

City of Co

2606

MADISON
BIG

2606

0-9-A
BROWN TWP




SCALE 1"=200'
V.M.S.
E=HIGHWAY EASEMENT
TAXING DISTRICT BROWN DISTRICT CODE 120

H... HOUSE NUMBERS

07F

09B

09D

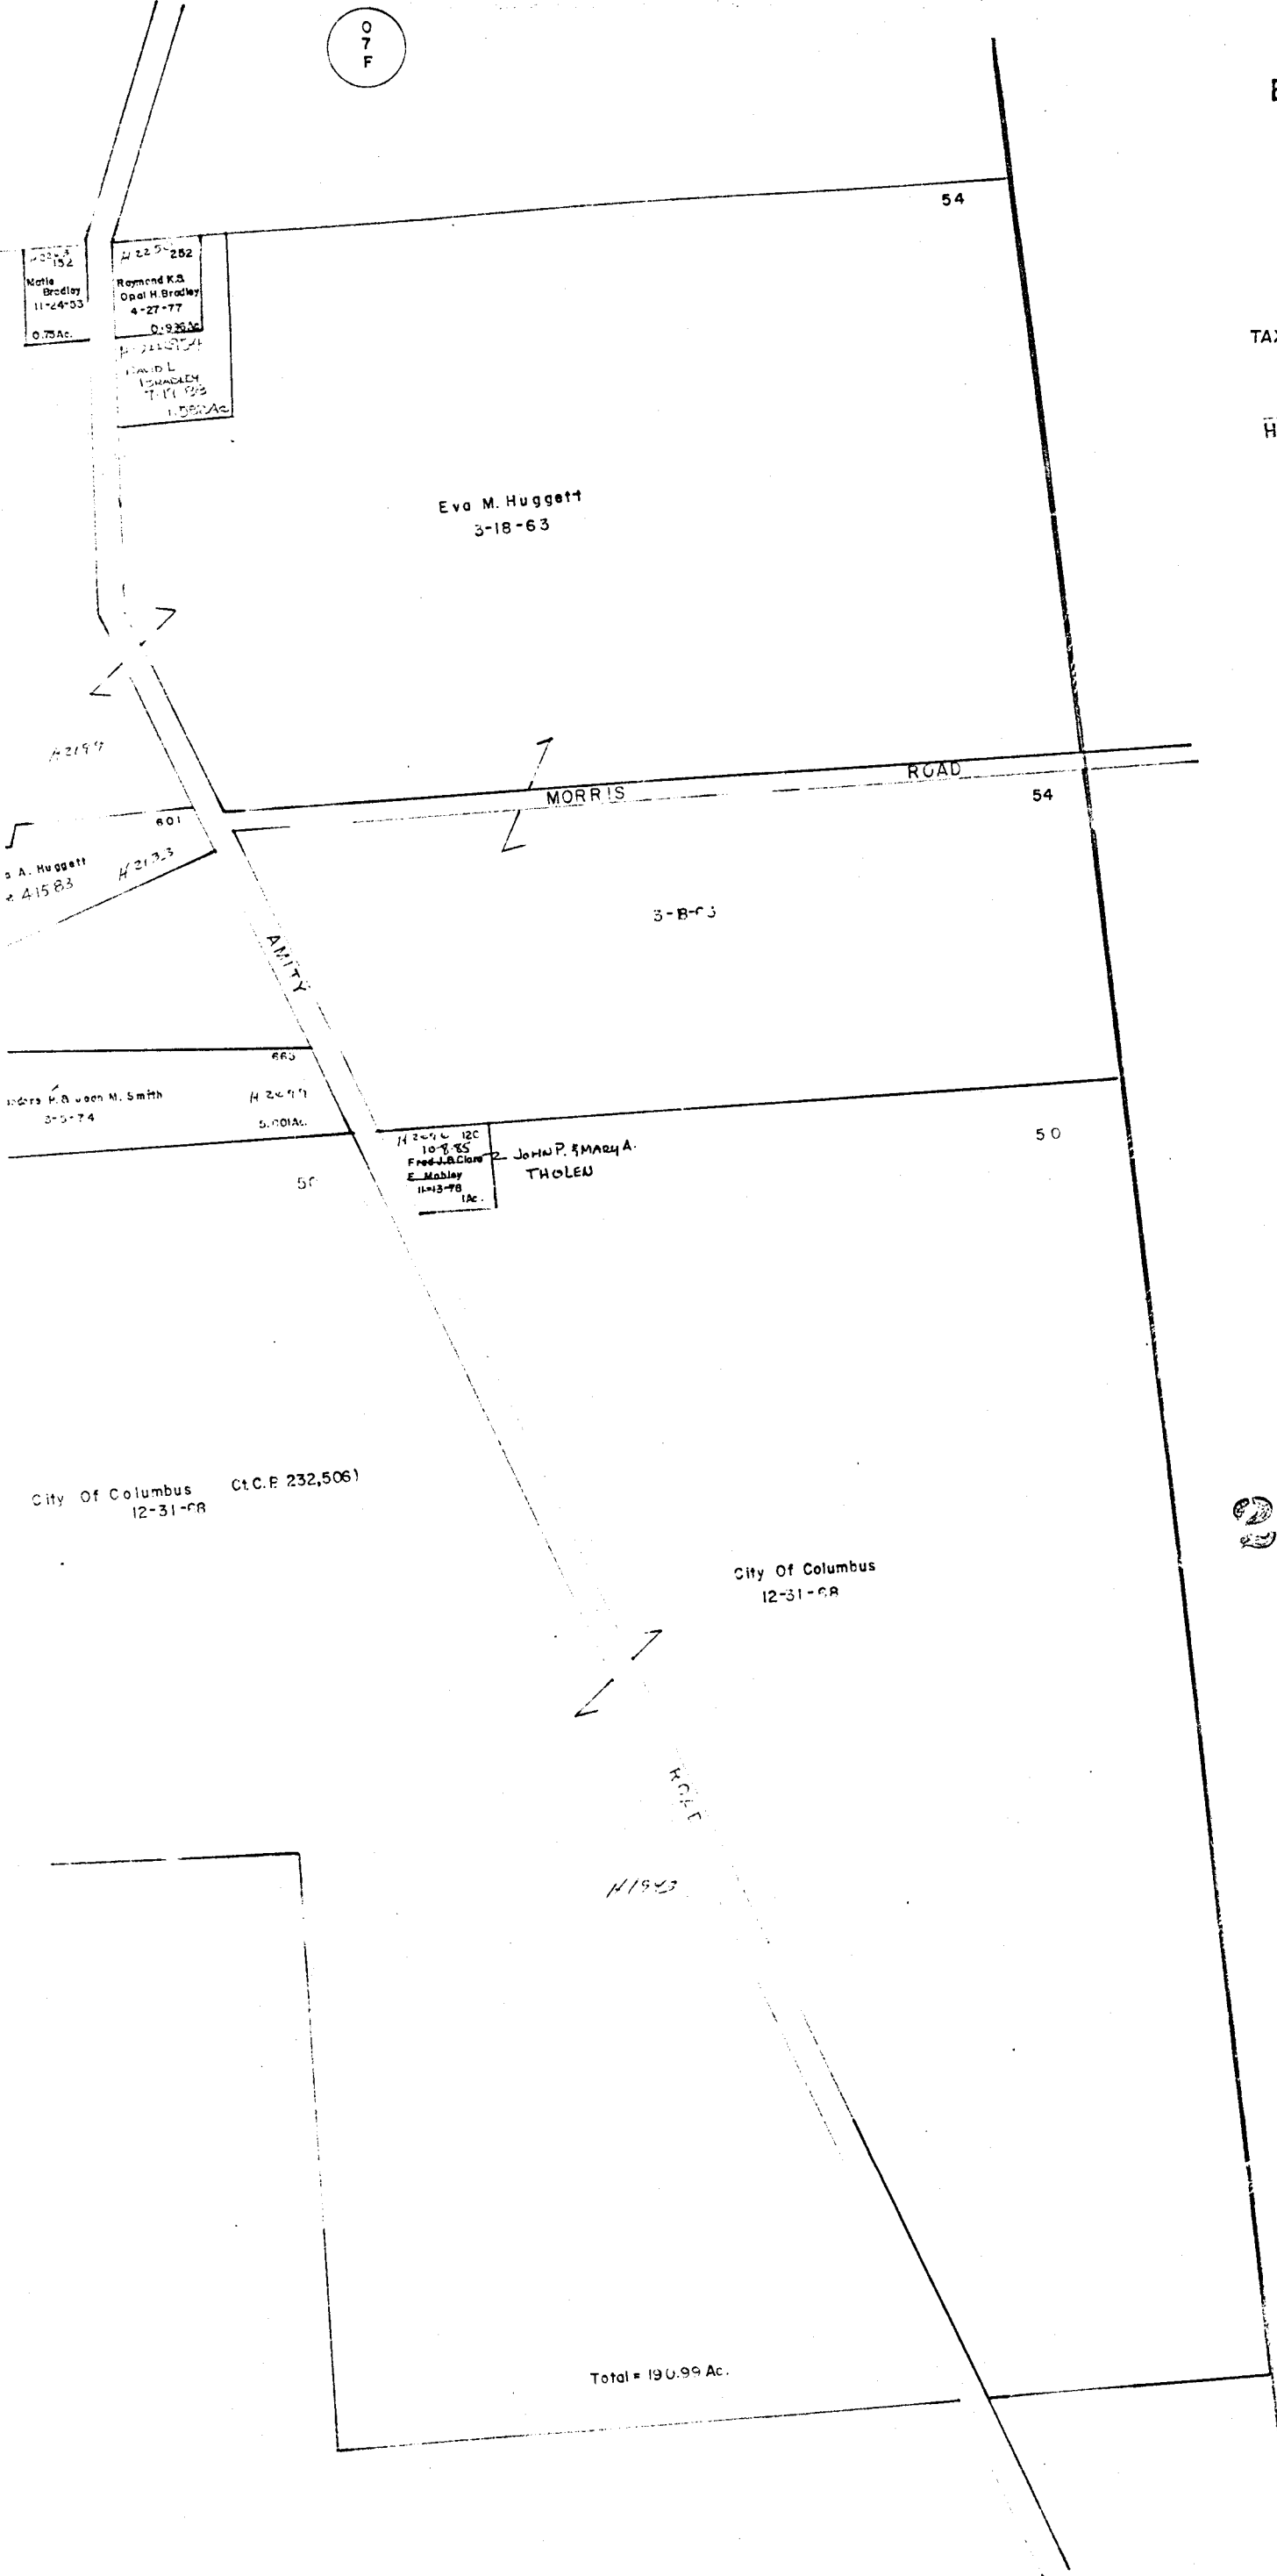

2670

0-9-A

