

5985

100

COMPLETE RECORD 19-152 PROBATE COURT

DAVID C. FERESA-L. SAYRE  
Harold C. Schultz  
5-11-81 12-4-86  
HAROLD C. & MILDRED E.  
SCHULTZ  
1-29-87

H 7819  
Helen F. Holland  
1-30-78

JERRY A. &  
R. K.  
OLSHESKI  
Charles F. & Beverly A. Schmitt  
9-28-79 9-21-74  
10-23-80 H 7791

DAVID G. & L. C. VUCCI TAKIS  
Frank & D. L. Babick  
11-17-82 7-31-80  
11-17-77

Thelma L. Harrow (AFDT)  
H 7711  
11-12-81

Warden K. Miller  
H 7681  
8-21-81

Richard B. & Phyllis B. Richard Words  
H 7677  
1-21-76 12-26-80

James W. & I. P. Humphrey  
H 7625  
8-6-73

William E. & Maella H. Smith  
5-9-77

Ronald L. & Sherry K. Harmon  
7-19-73

Thomas G. & H. J. Readd  
5-8-73

Joseph W. & Sue R. Thompson  
10-29-75

Joe & Rose McKenzie  
1-24-73

Charles F. & Carol M. Gaul  
8-18-82

LOT 2

LOT 1

Melvin L. & Dorris R. Distelhorst  
H 7812  
1-31-79

Richard L. & Jutta E. Zwyer  
5-23-69  
H 7740

Robert M. & Deanna J. Zwyer  
5-23-69

Fred G. Barrett  
10-12-83

41.501 Ac.  
951  
LAWRENCE J.  
VITTA  
7-8-83 2-18-86  
947  
LAWRENCE J. VITTA  
DIVORCE  
7-8-83 2-18-86

22.840 Ac.

H 7710  
E 549  
L. & Rosemary Smith  
4-2-76 1-18-80

16.836 Ac.

727  
5.0 AC.  
H 7600  
Francis & Margery A. A. O'n  
8-25-77

MORRIS ROAD

ROAD

ROAD

WALKER

ROBERT S. &  
ESTHER C. GATES  
H-7815 5-9-88

5,005 ACS  
8515  
JENNIFER & ESTHER A. D.  
CARRIG  
1-8-87 1-8-87

5,001 ACS  
947  
R. & V. VITTA  
GATES  
6-22-88

H 7711  
PATRICIA J.  
Joseph Harper  
5-4-73 3-25-87

10. AC.

H 7603  
Clara & Myrtle Bynner  
1-9-47

10.635 Ac.

64.36 Ac.

2670

100

66


0-10-A  
BROWN TWP.



SCALE 1"=200'

V.M.S.  
TAXING DISTRICT BROWN DISTRICT CODE 120

H... HOUSE NUMBERS

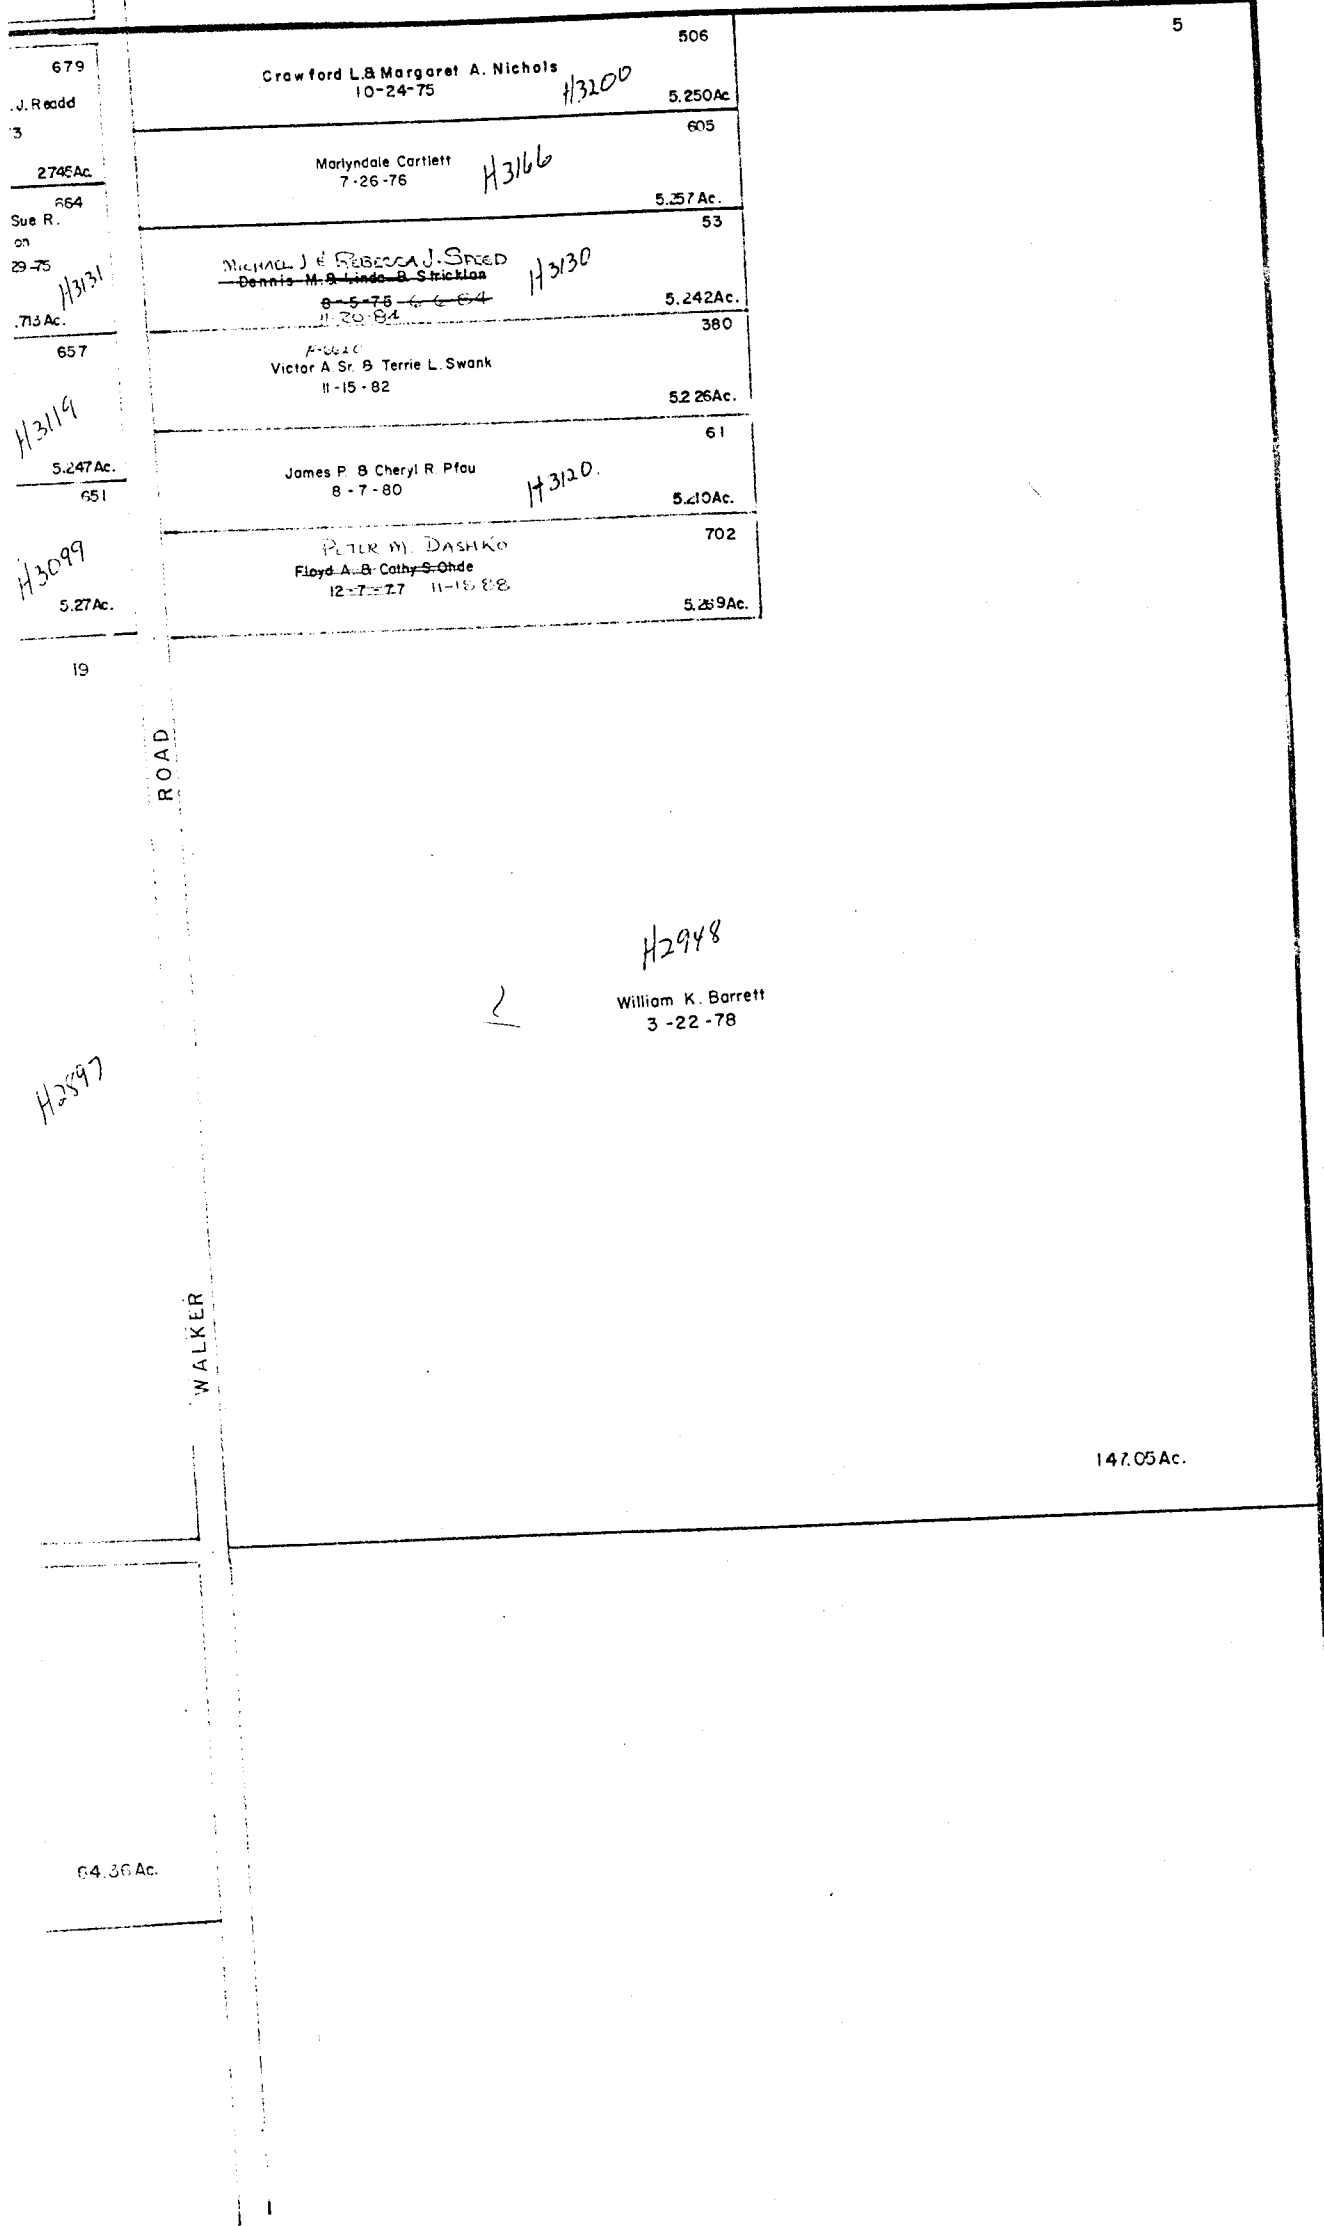

6957



6637

0-10-A

