


2670

C
11
C

C
11
C

O
11
B

C
12
D

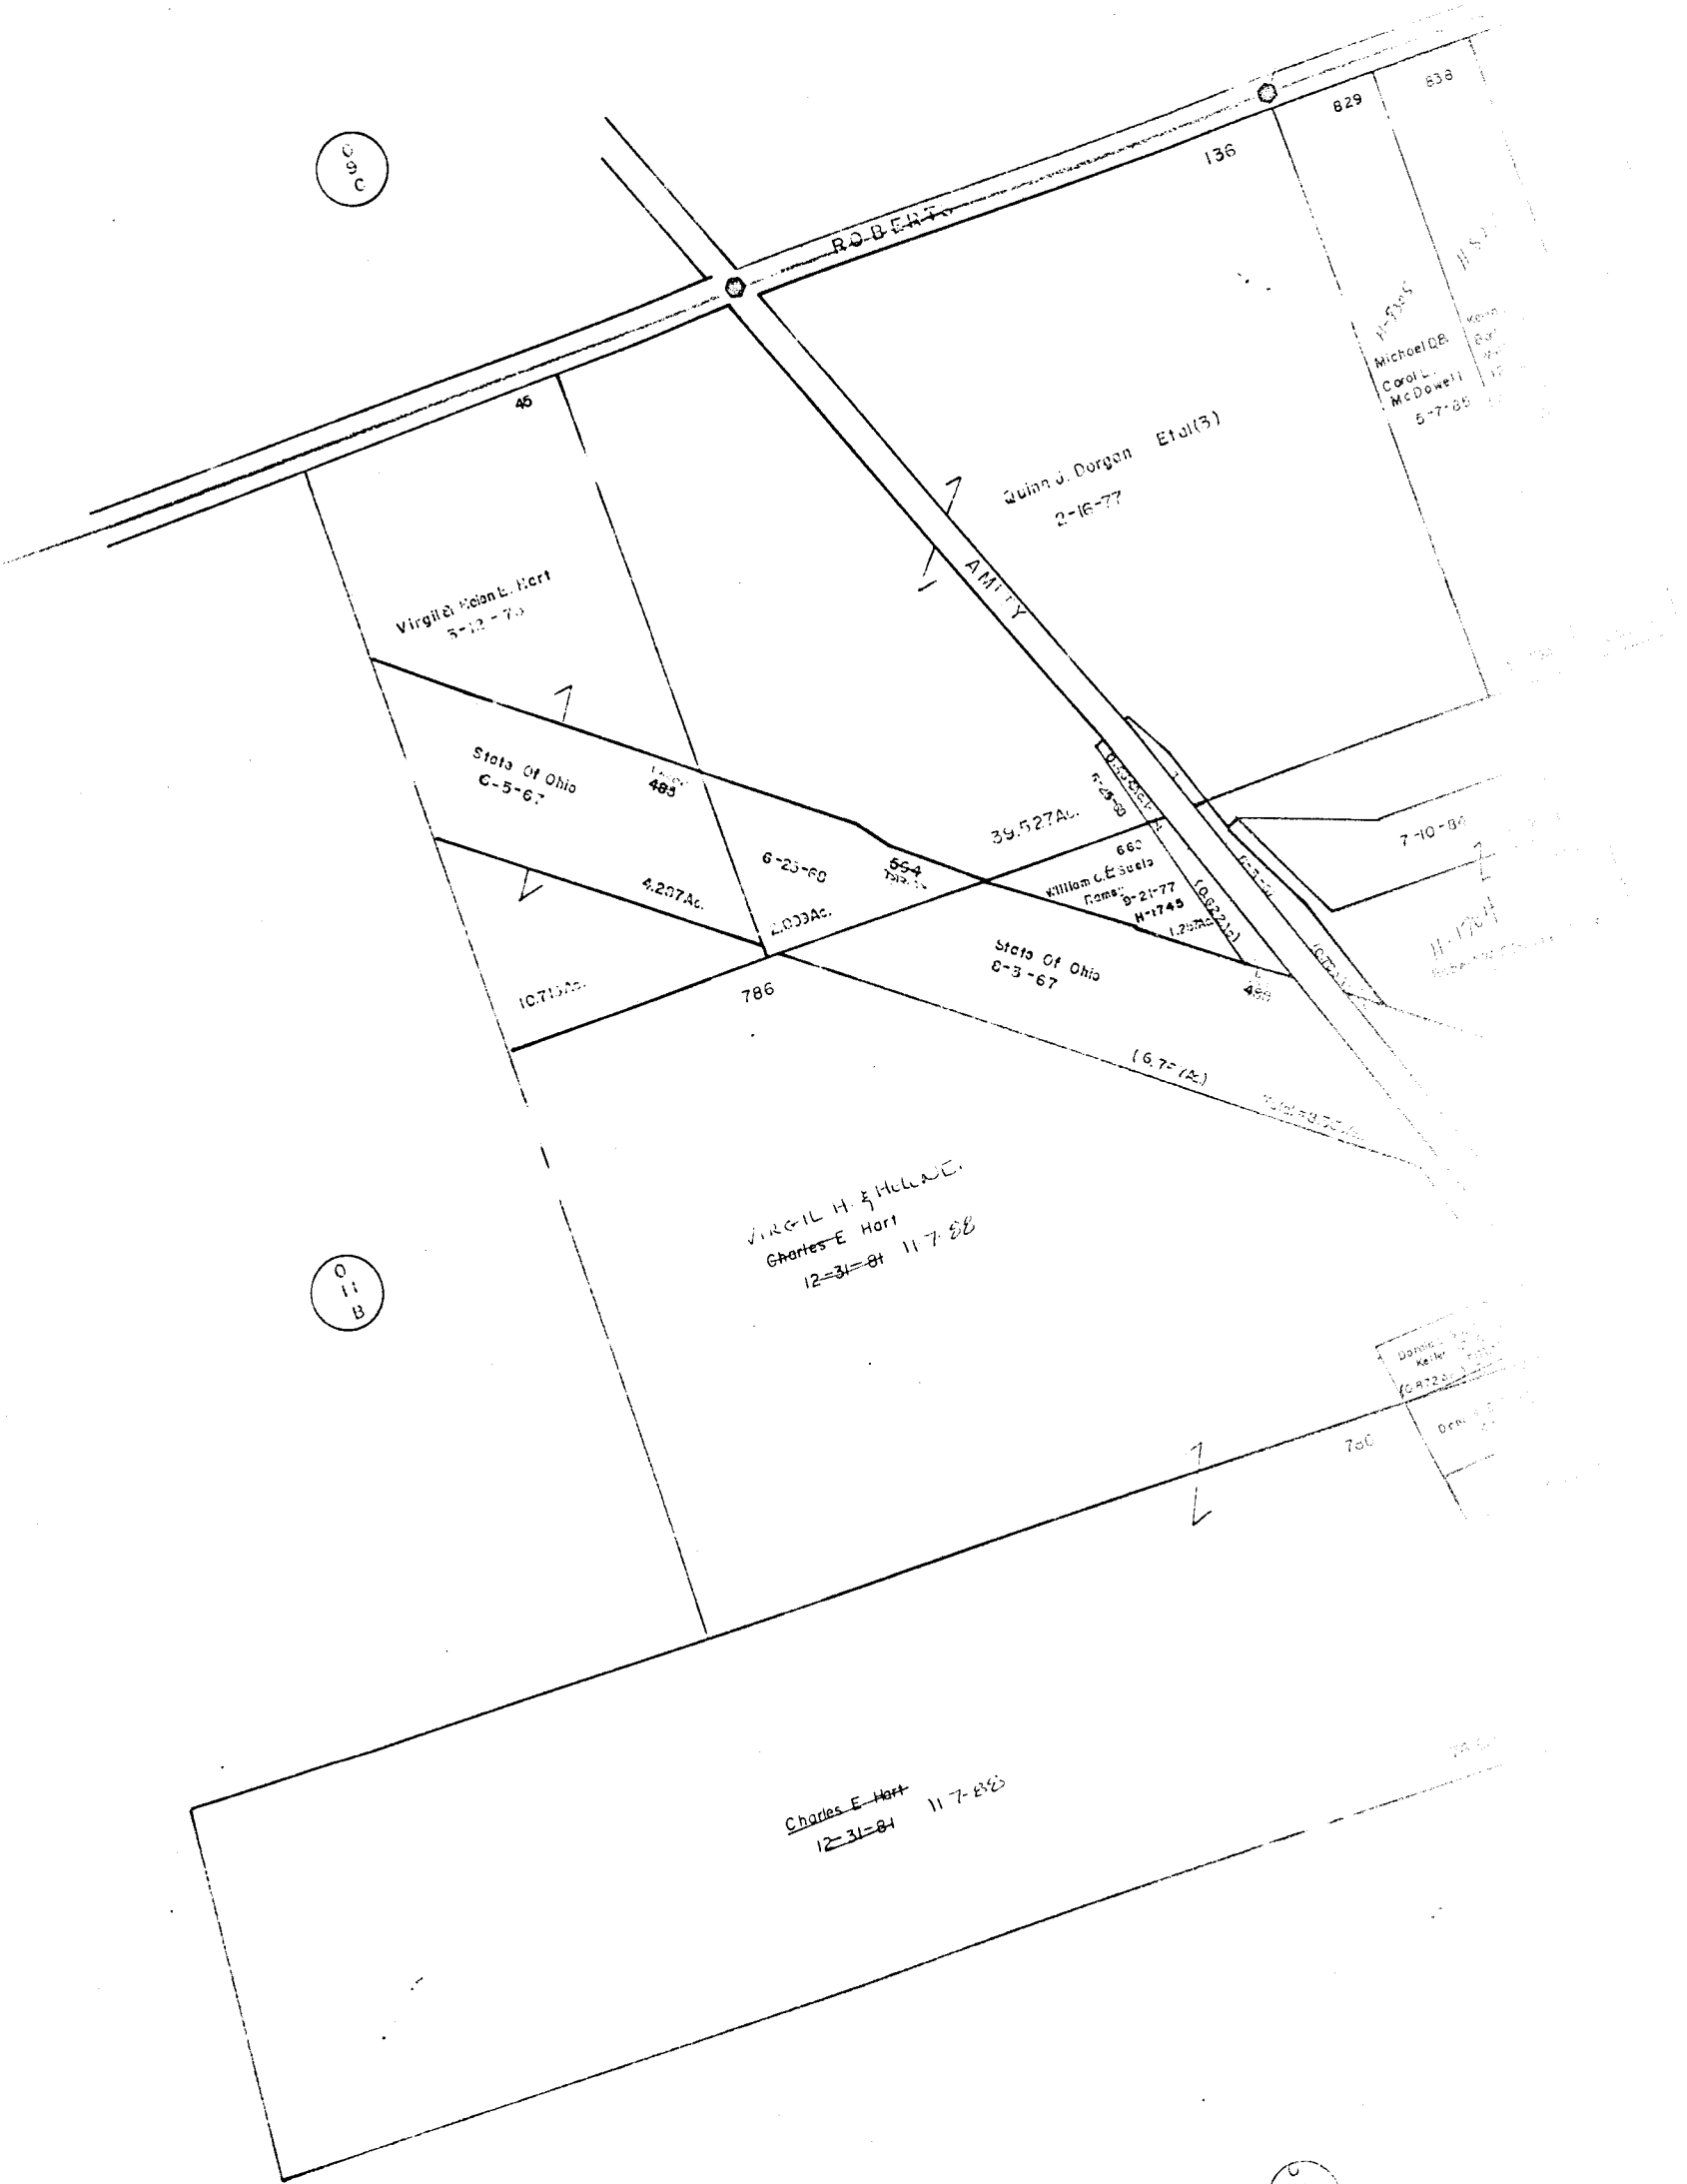

0-12-A
BROWN TWP.



SCALE: 1" = 200'

E = HIGHWAY EASEMENT
TAXING DISTRICT CODE
BROWN 120

H--HOUSE NUMBERS

FRANKLIN COUNTY SURVEY MONUMENT

