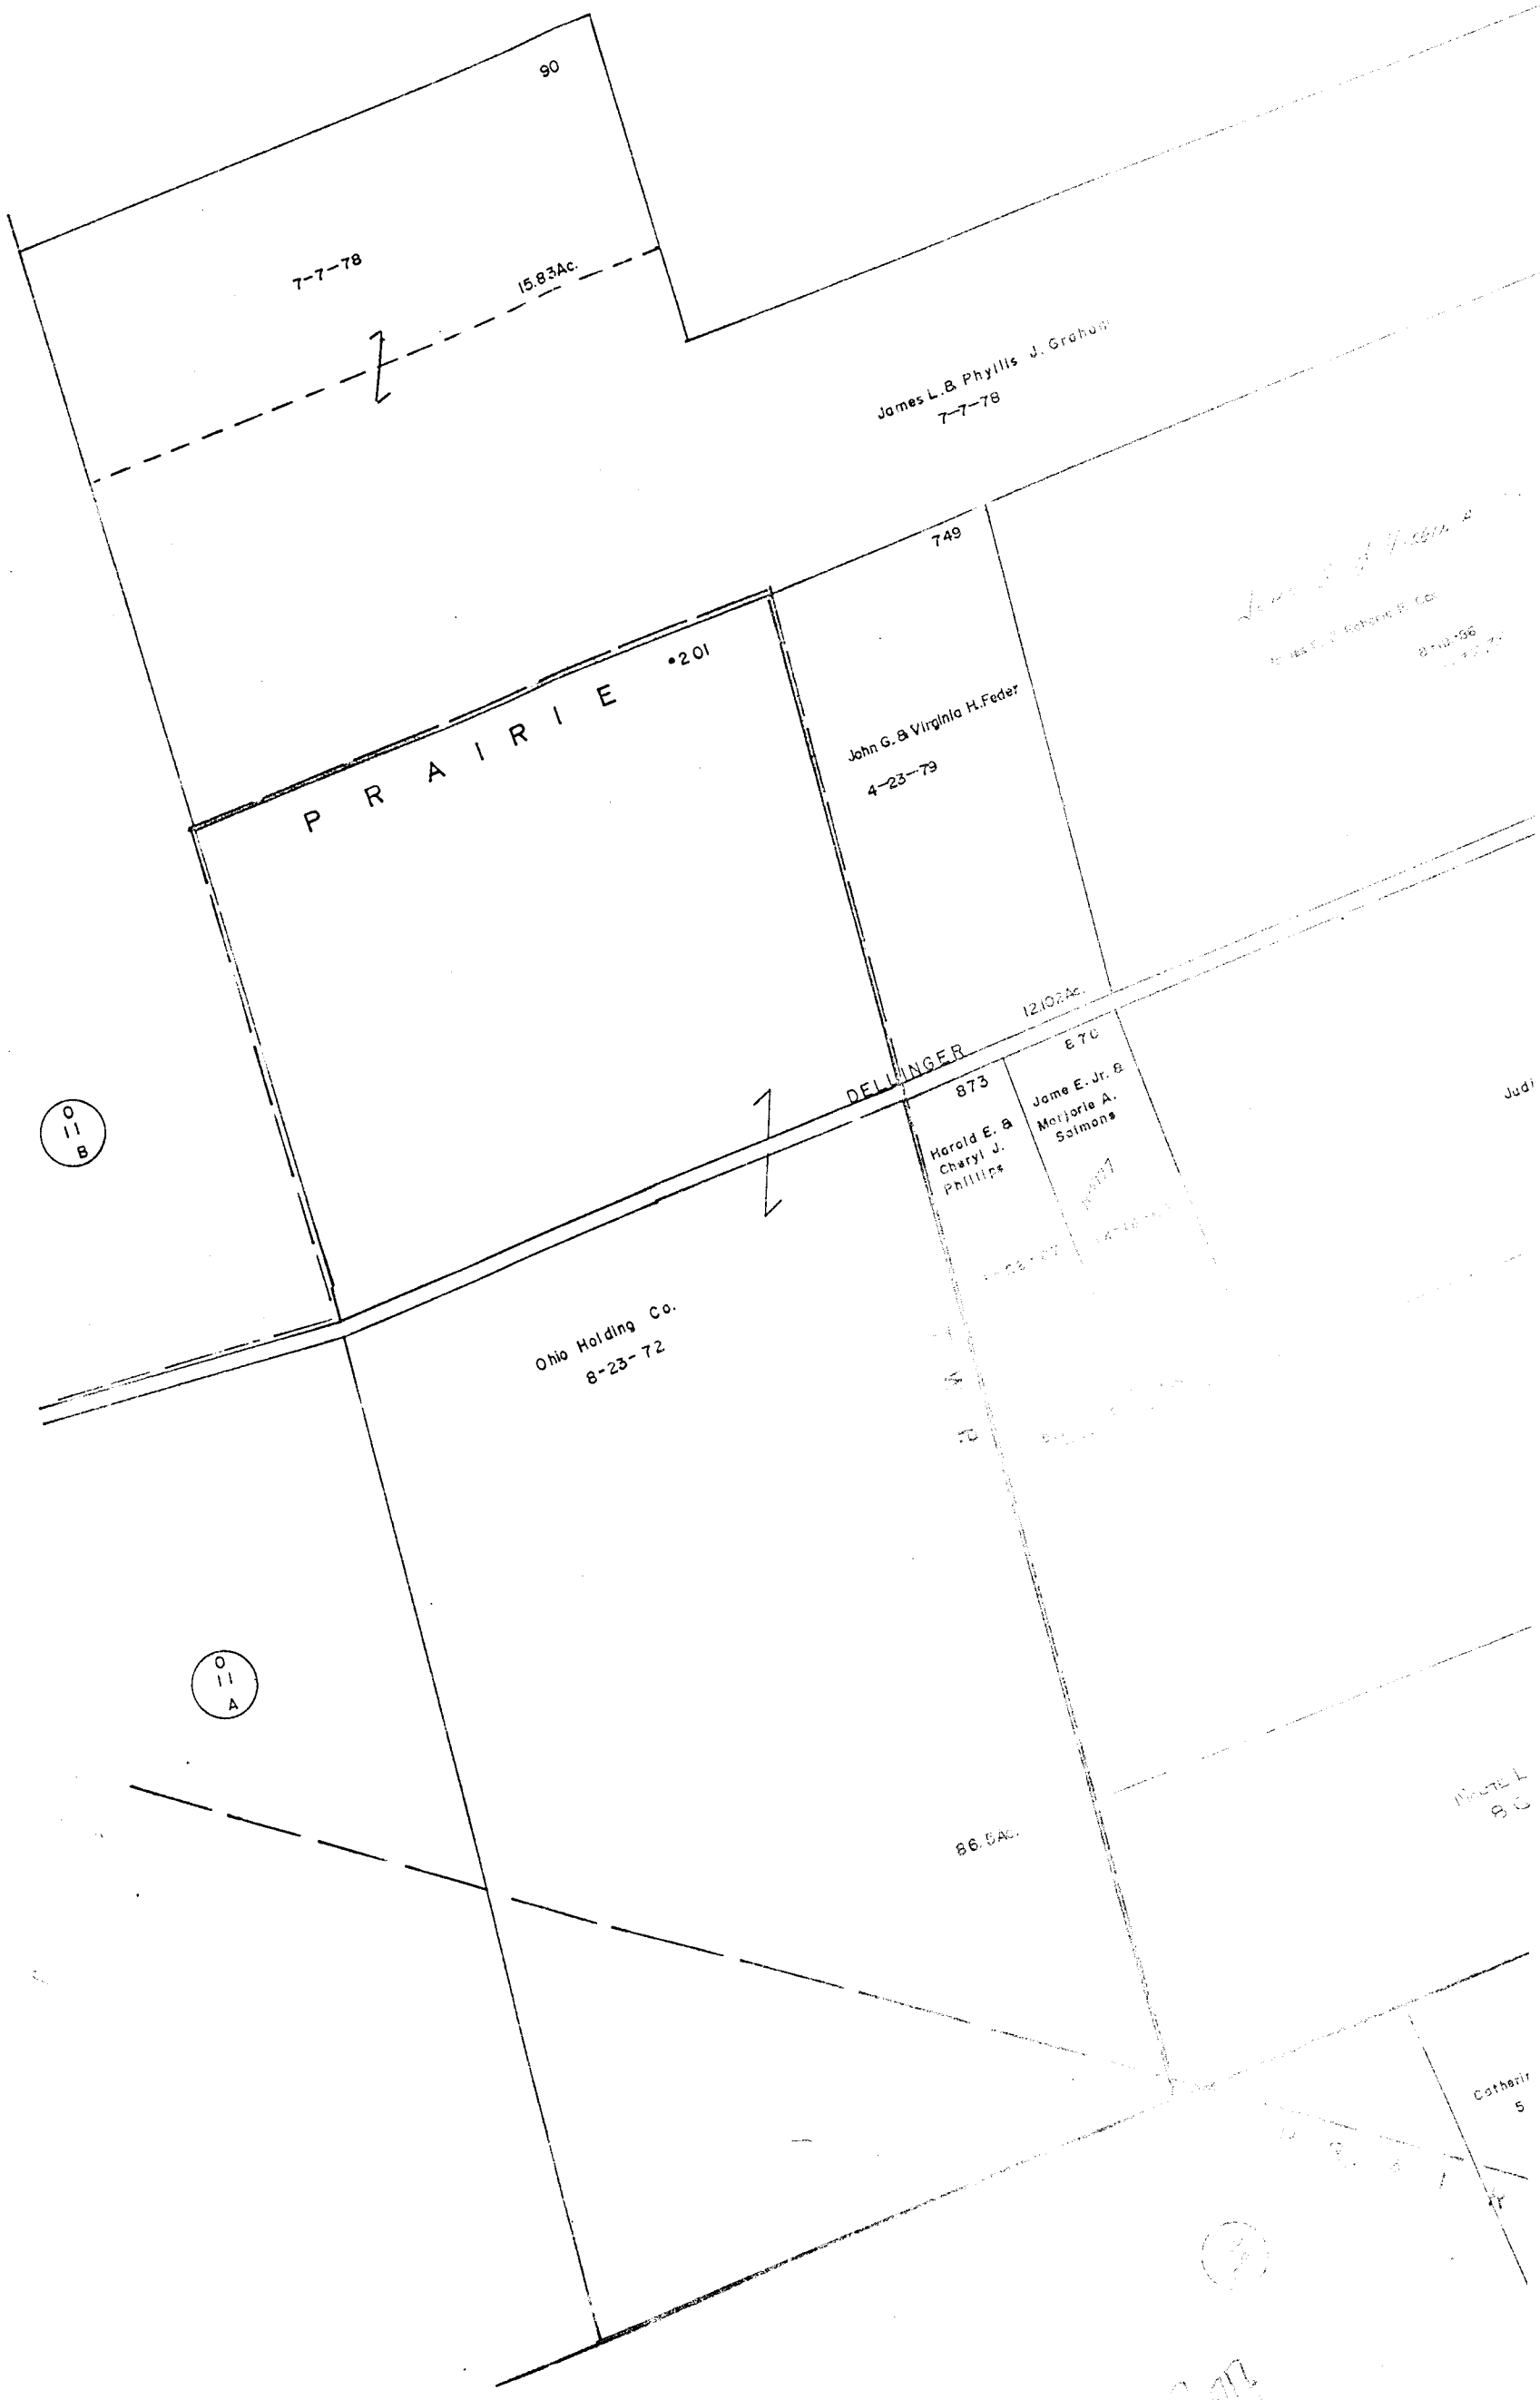
90
7-7-78
15.83Ac.
James L. & Phyllis J. Graham
7-7-78
749
201
PRAIRIE
John G. & Virginia H. Feder
4-23-79
12.102Ac.
DELLINGER
873
Harold E. & Cheryl J. Phillips
870
Jame E. Jr. & Marjorie A. Salmons
Ohio Holding Co.
8-23-72
86.5AC.

0-12-D
BROWN TWP.

SCALE 1"=200'
V.M.S.

E=HIGHWAY EASEMENT

TAXING DISTRICT	DISTRICT CODE
BROWN	120
•PRAIRIE SCIOTO DARBY S.D.	241
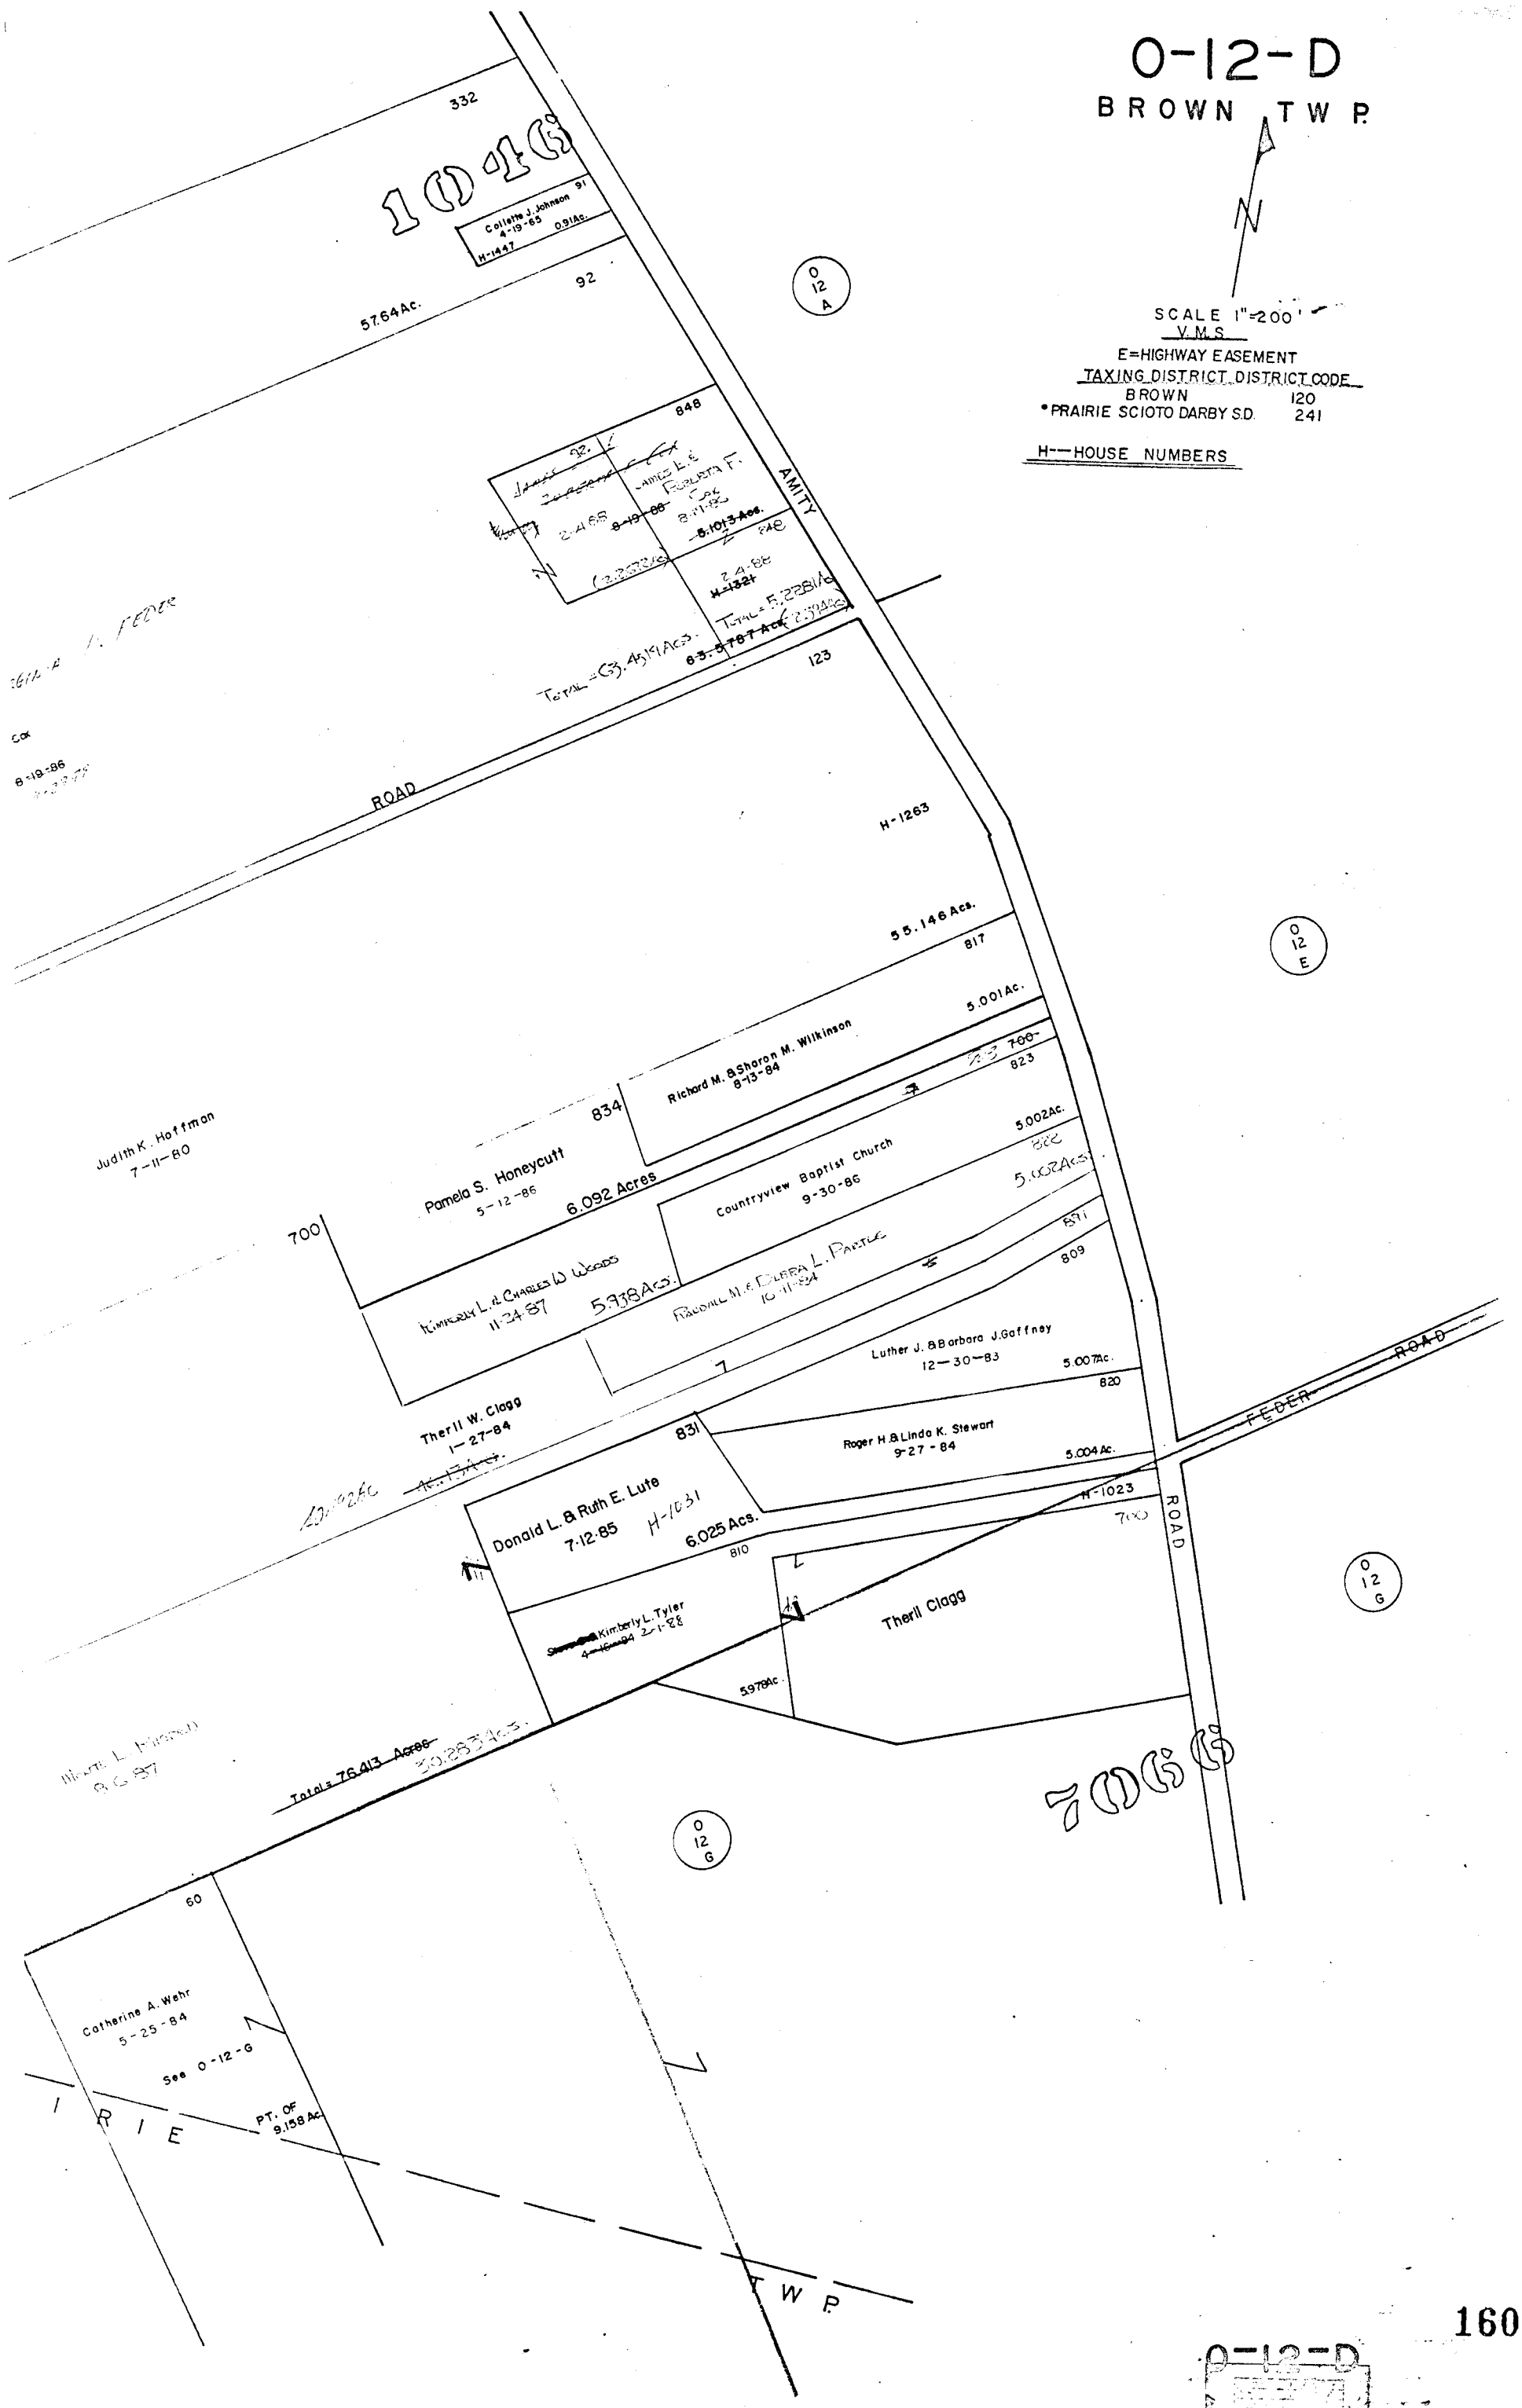
H--HOUSE NUMBERS