



1-136795	Mary M. Blume	5-20-63	0.46Ac.
2-98905	"	4-17-80	0.42Ac.
3-	SFF M-144-1		
4-99104	Roy E. Alexander & B.J. Williams	7-22-81	0.436Ac.
5-98476	Cary Bolden	1-3-83	0.43Ac.
6-27489	Clark-Owen, AT Corp	2-11-69	0.23Ac.
7-87490	"	"	0.30Ac.
8-99455	Jeanette V. Vitale (AFT)	10-23-57	0.200Ac.
9-98490	"	"	0.149Ac.
10-98457	William T & Johnis J.L. Foster	5-2-75	0.279Ac.
11-93796	James E. Wright	6-28-68	0.351Ac.
12-95438	Walter P. Meade	12-23-70	0.593Ac.
13-15060	Donald B. Mable Hope	4-20-78	0.6079Ac.
14-4209	John Jordan	3-21-80	0.5949Ac.
15-98458	Country Acres Mobile Home Park Inc.	4-10-79	56.74X135
16-98895	"	4-0-79	0.442Ac.
17-98521	"	4-10-79	50.X135
18-98906	"	4-10-79	0.209Ac.
19-98540	Ronald D. Young	6-12-79	0.4274Ac.
20-98903	Plaskolite Inc	11-10-81	0.16Ac.
21-17021	"	6-11-76	0.346Ac.
22-98853	"	7-26-82	0.216Ac.
23-98904	"	7-26-82	0.431Ac.

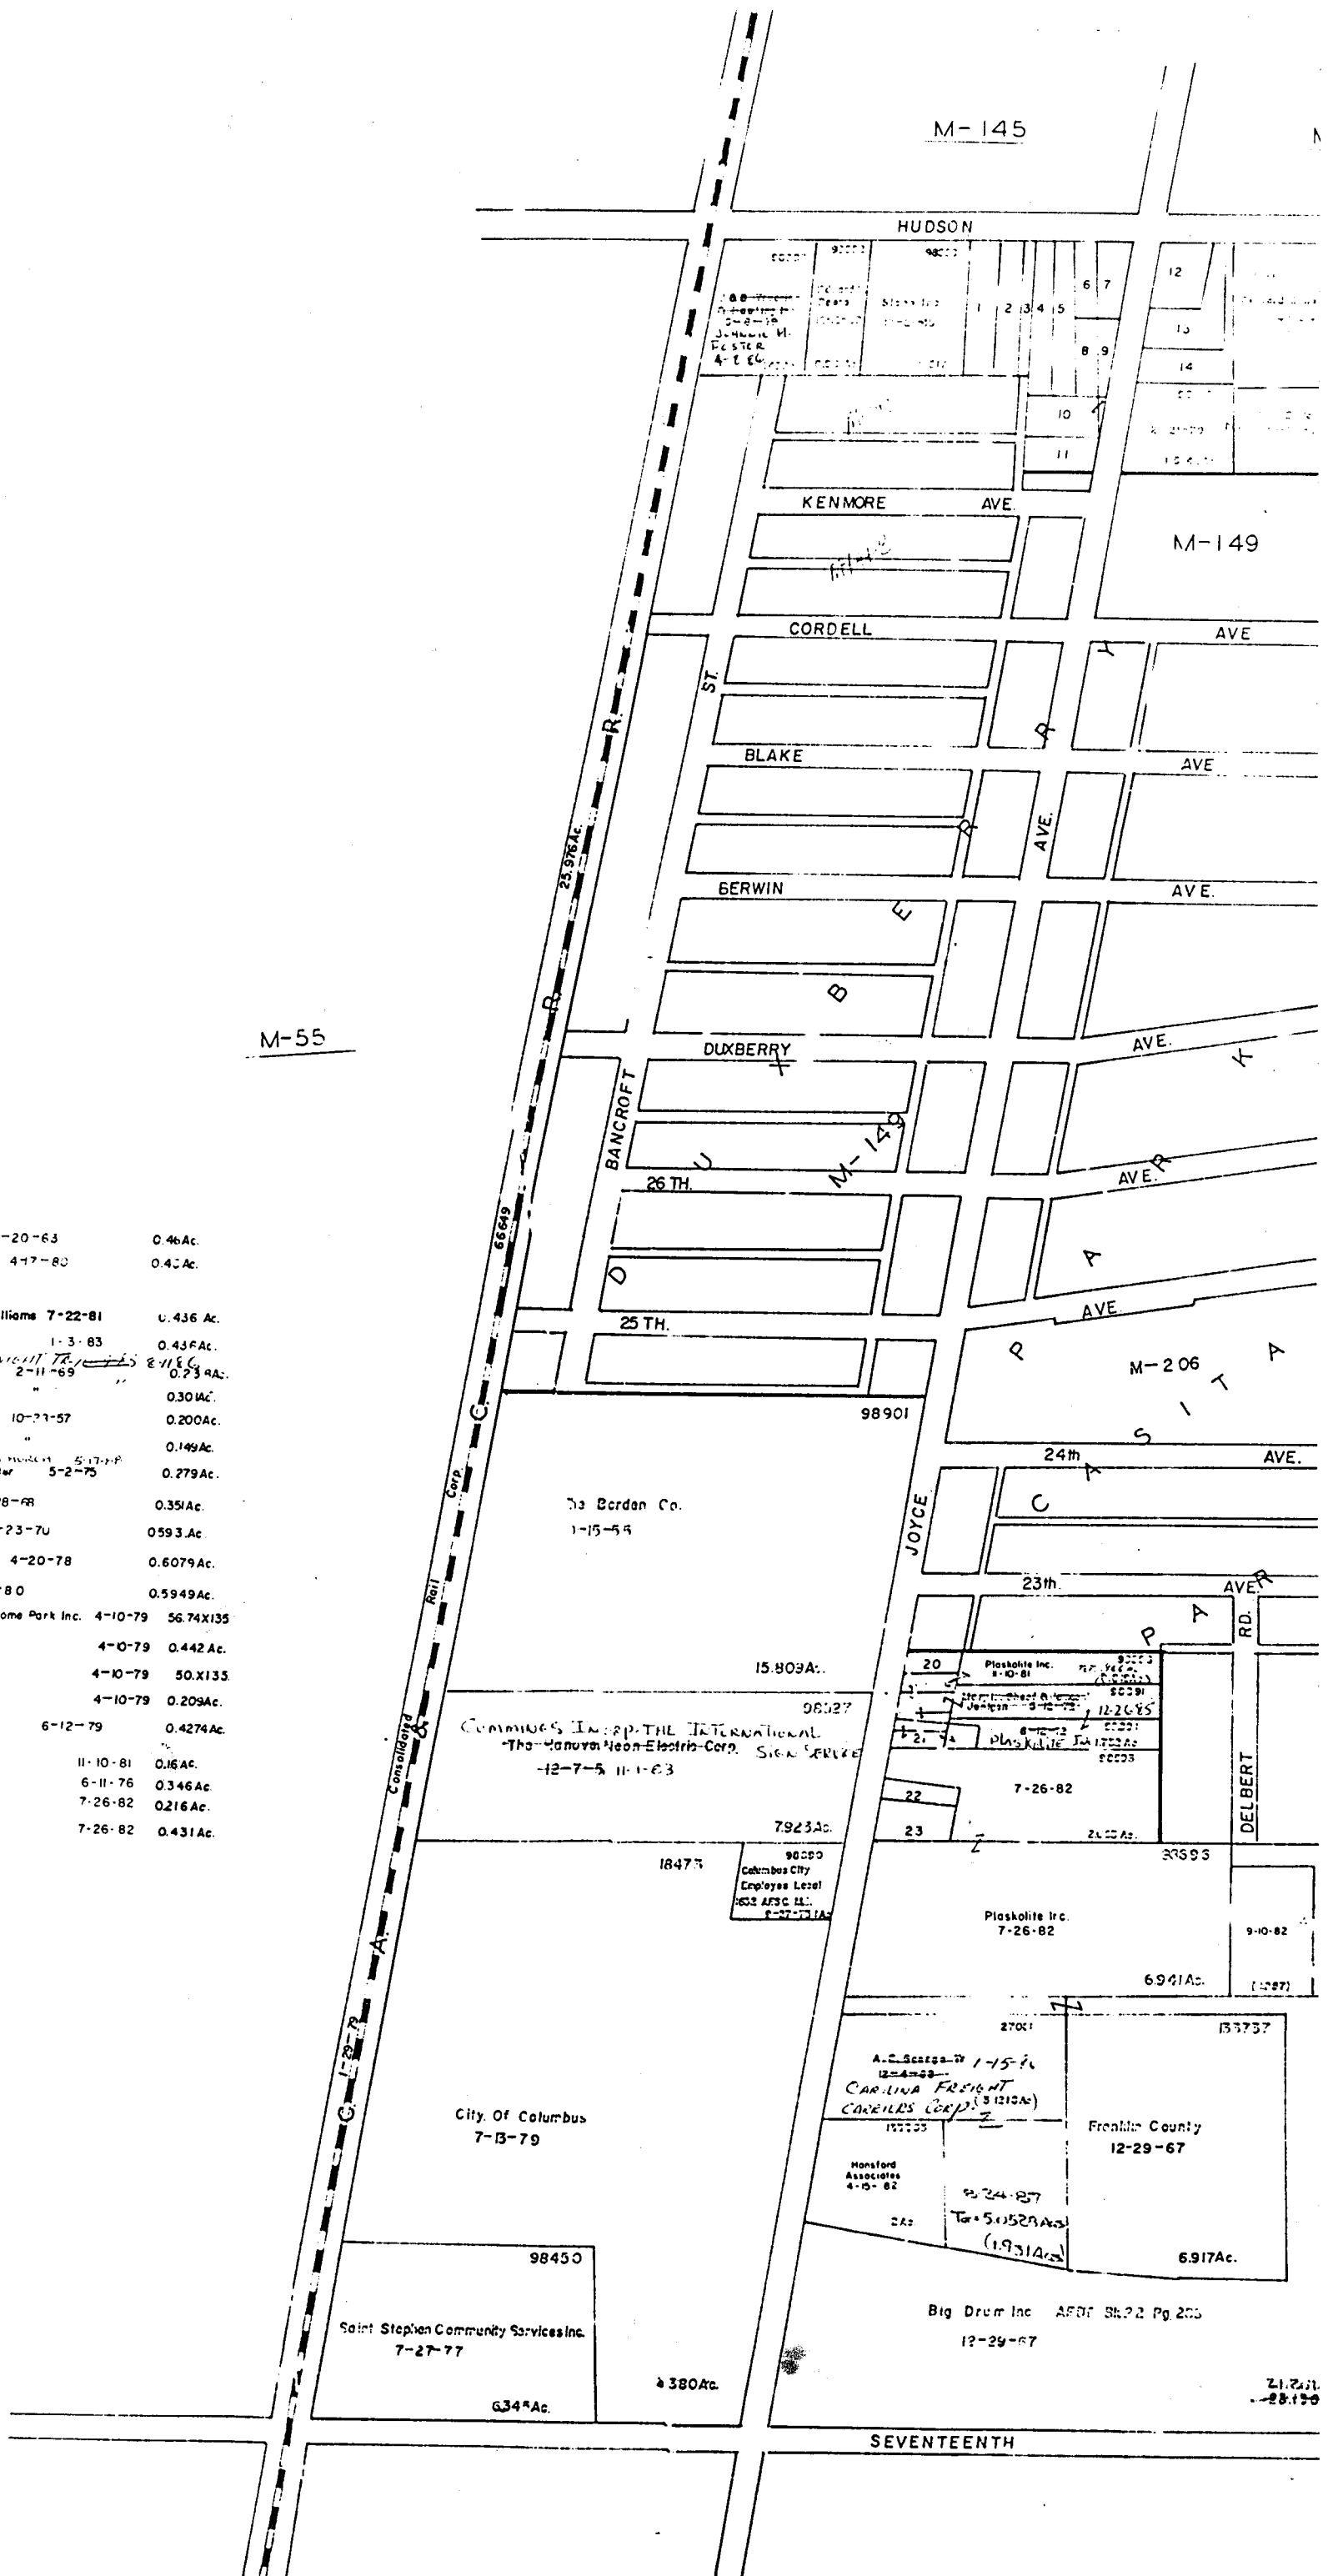


M-146

0-16-D  
CLINTON TWP  
R.18 TWPI

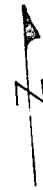

SCALE 1" = 200'  
E = HI-WAY EASEMENT  
TAXING DISTRICT DISTRICT CODE  
COLUMBUS 010

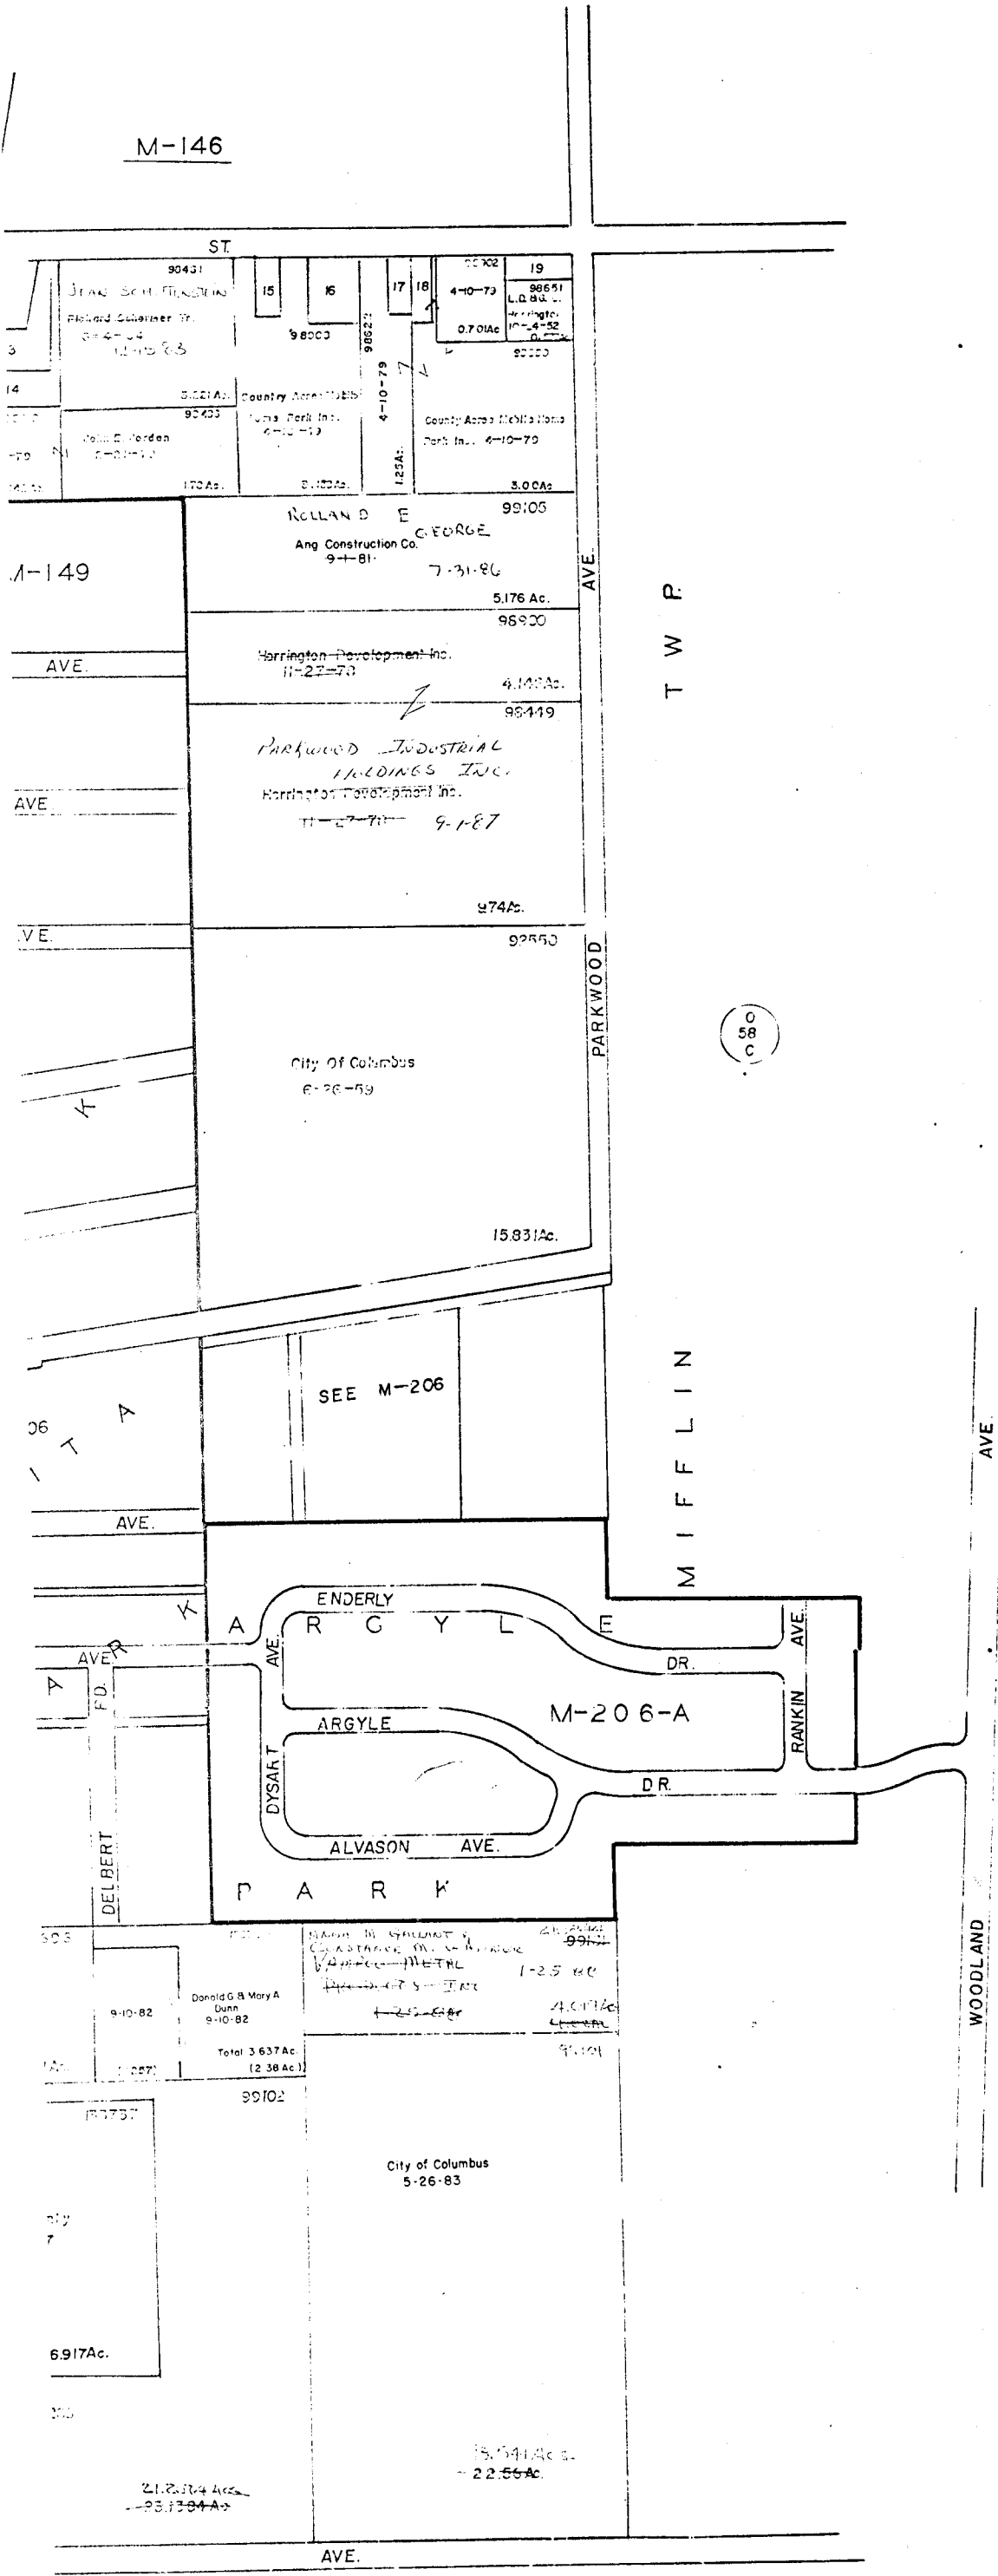

0-16-D