

- ① ***146264 State of Ohio 10-3-72 .22 Ac.
- ② ***146276 State of Ohio 10-3-72 .194 Ac.
- ③ ***146266 State of Ohio 10-3-72 .571 Ac.
- ④ ***146273 State of Ohio 3-18-70 .31 Ac.
- ⑤ ***146269 State of Ohio 8-12-69 .333 Ac.
- ⑥ ***150018 State of Ohio 5-20-69 .416 Ac.
- ⑦ ***146286 State of Ohio 5-20-69 .250 Ac.
- ⑧ ***146227 State of Ohio 11-6-69 .250 Ac.
- ⑨ ***146272 State of Ohio 7-22-69 .165 Ac.
- ⑩ ***146269 State of Ohio 5-7-70 .29 Ac.

- ⑪ ***126236 State of Ohio 7-24-73 .5183 Ac.
- ⑫ ***126626 State of Ohio 1-28-75 .3707 Ac.
- ⑬ ***108703 George A. Anderson Jr. 6-10-80. 4.44 Ac.
- ⑭ ***126638 PDS FINANCIAL CORP. 10-10-88. 3.68 Ac. 2.588
- ⑮ ***126637 Tolliver B. Curt Paving Cont. Inc. 8-16-62 1.359 Ac.
- ⑯ DROP State of Ohio 4-21-70 .58 Ac.
- ⑰ ***12367 State of Ohio 2-10-72 .14 Ac.

- ⑱ DROP State of Ohio 10-19-70 .33 Ac.
- ⑲ ***146233 State of Ohio 12-3-71 .34 Ac.
- ⑳ ***146254 E. Pignatello 10-2-79 .16 Ac.
- ㉑ ***146232 State of Ohio 3-21-72 .47 Ac.
- ㉒ ***146234 City of Columbus 8-26-75 .44 Ac.
- ㉓ ***146249 City of Columbus 8-26-75 .224 Ac.

- ㉔ DROP State of Ohio 7-10-70 .18 Ac.
- ㉕ DROP State of Ohio 12-14-71 .16 Ac.
- ㉖ DROP State of Ohio 8-19-70 .38 Ac.
- ㉗ DROP State of Ohio 8-19-70 .03 Ac.
- ㉘ DROP State of Ohio 12-15-69 .13 Ac.
- ㉙ DROP State of Ohio 8-13-69 .083 Ac.
- ㉚ DROP State of Ohio 8-13-69 .014 Ac.


- ㉛ DROP State of Ohio 8-5-69
- ㉜ DROP State of Ohio 11-19-70
- ㉝ DROP State of Ohio 11-19-70
- ㉞ ***104117 R.T. Farley Jr. 11-4-60
- ㉟ ***118118 MARY JANE McCAWNER 7-12-62
- ㊱ 7102 R.F.M.L. Penwell 8-20-7.
- ㊲ ***184719 CRAIG A. Root 2-26-87

O 18 F

O 18 E

O 19

O 18

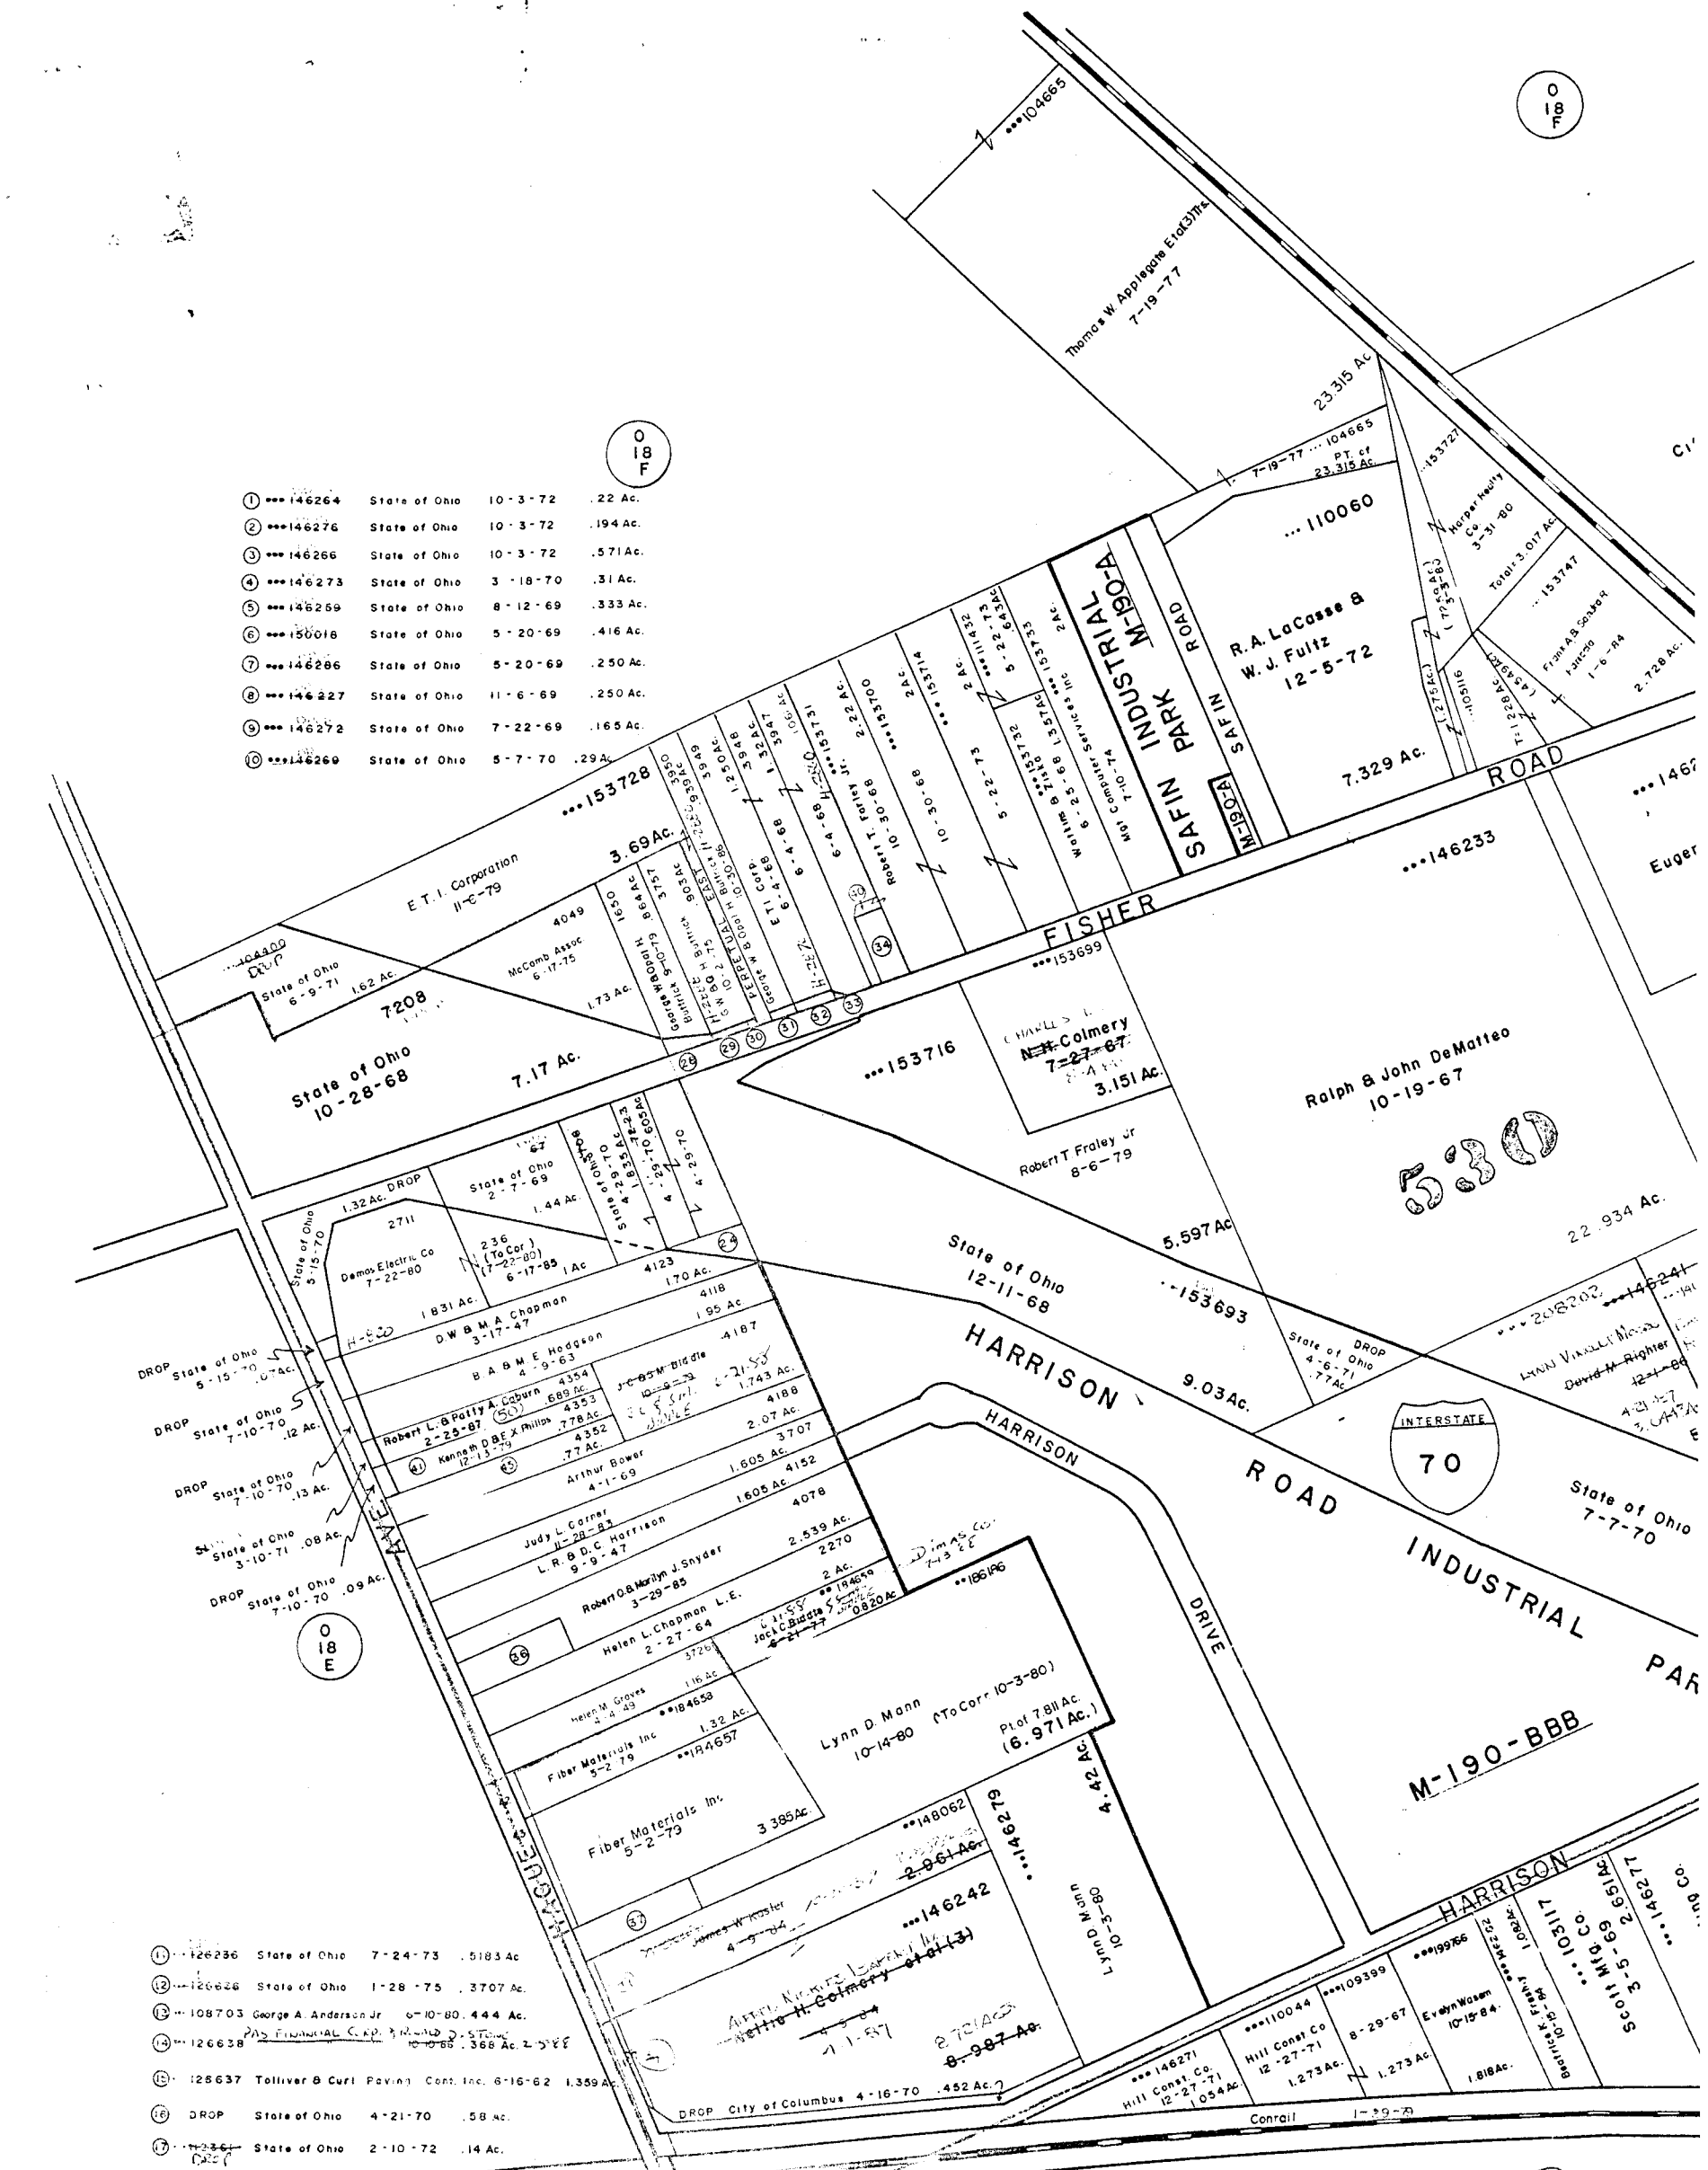

O-18-G

FRANKLIN TWP.

SCALE 1"=200'
V.M.S.


E=HIGHWAY EASEMENT

TAXING DISTRICTS	DISTRICT CODE
FRANKLIN TWP	140
COLUMBUS-SOUTHWESTERN SD.	570
FRANKLIN-COLUMBUS-IND. S.D.	141
COLUMBUS	010

H... HOUSE NUMBER

- (47) DROP CITY OF COLUMBUS (H.WAY) 4-1-87 0.2611 Ac.
- (48) 146232 JOSEPHINE Y. MARK FERDINO 11-8-87
- (49) DROP CITY OF COLUMBUS (H.WAY) 7-23-87 0.1056 Ac.
- (50) 4354 KATHY L. ROUSH, Tr 3-1-88 0.689 Ac.

0
17
A

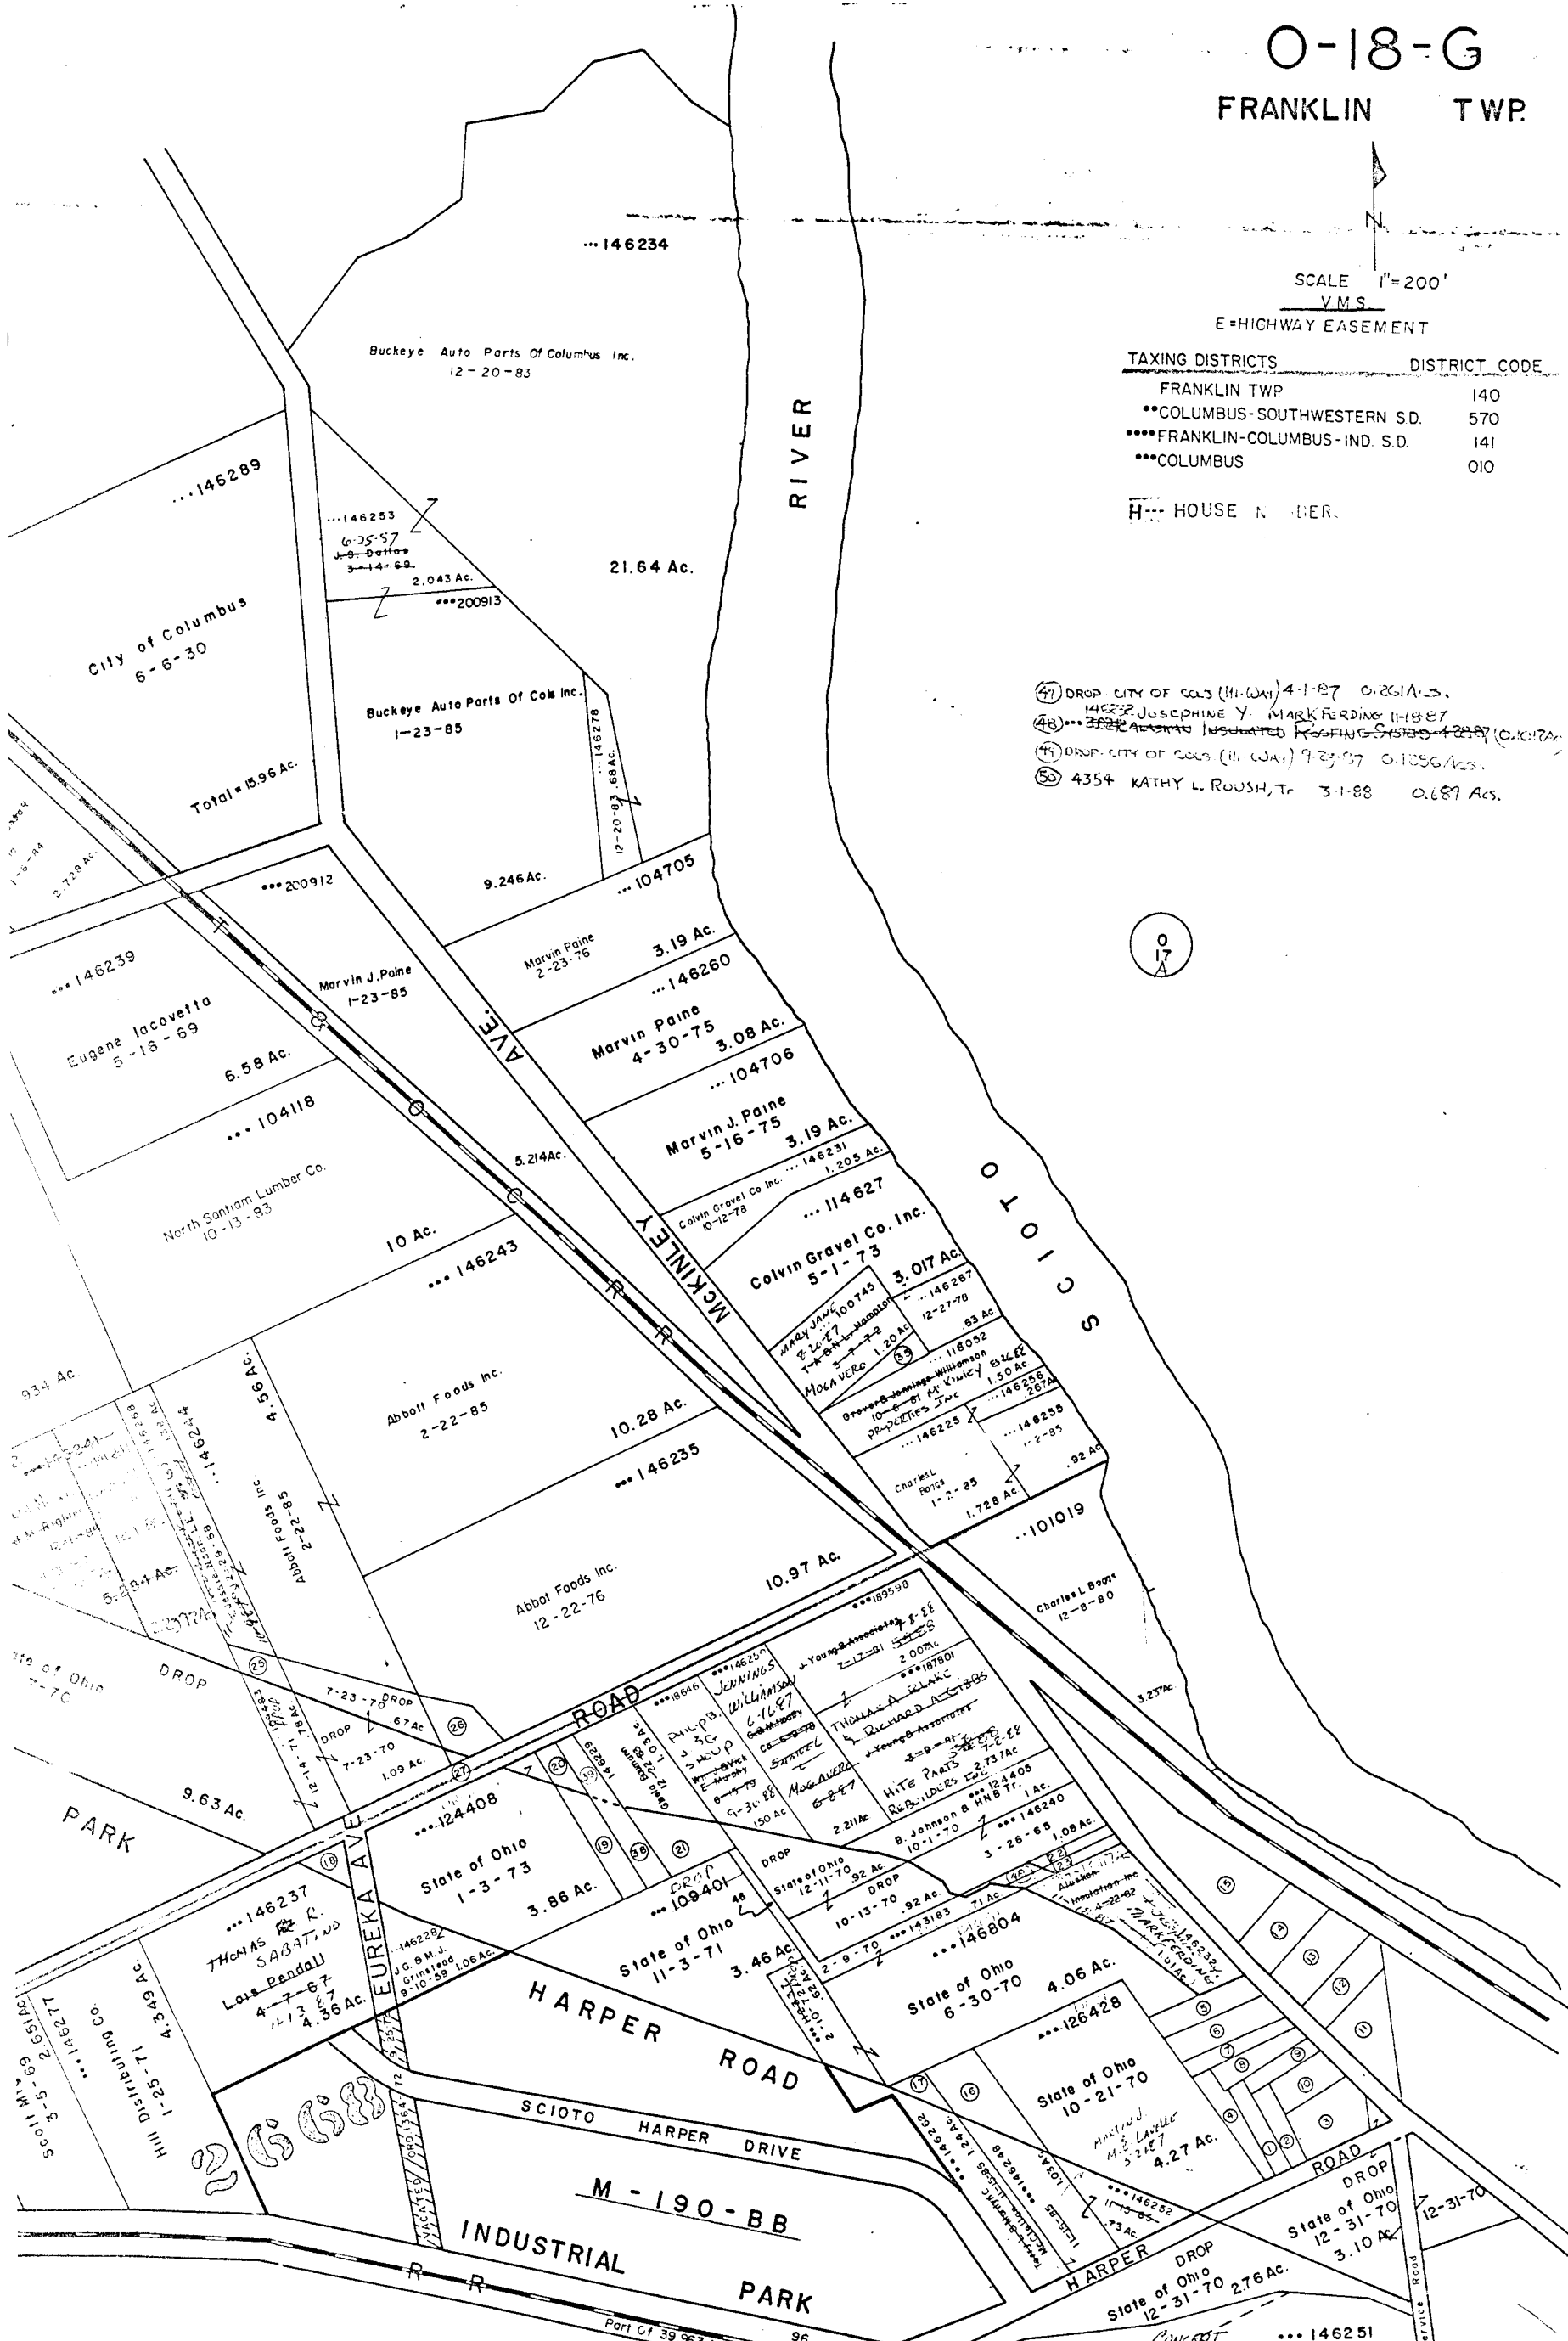

6-5-69	0.61 Ac.	38	146238	State of Ohio	12-18-70	0.27 Ac
11-19-70	0.83 Ac.	39	1861	Joseph DeMatto	2-10-77	0.23 Ac
11-19-70	0.13 Ac.	40	323	Robert F Farley Jr	11-13-75	0.023 Ac
11-4-69	2.485 Ac.	41	4353	Kenneth D B E X Phillips	12-13-79	0.778 Ac
AVERO 7-1-87	1.86 Ac.	42	Drop	City of Columbus	4-28-80	0.692 Ac
1-8-20-77	0.461 Ac.	43	Drop			0.235 Ac
2-26-87	0.489 Ac.	44	124659	Jack C Biddle	6-21-77	0.020 Ac
		45	4352	Randall D B C L Daxiel	5-2-83	0.770 Ac.
		46	4224	Benjamin Jones	5-28-48	0.28 Ac.

(SEE UPPER RIGHT FOR INDEX CONTINUATION)

10
S. B. H. Topolosky
7-7-66
Total: 5.286 Ac.
(3.012 Ac.)

146251
CONCEPT
CONSTRUCTION
Company Inc. Radtchro Inc.
4-12-88 7-1-82
2-6-87
Total = 7.042 Ac.

O-18-G