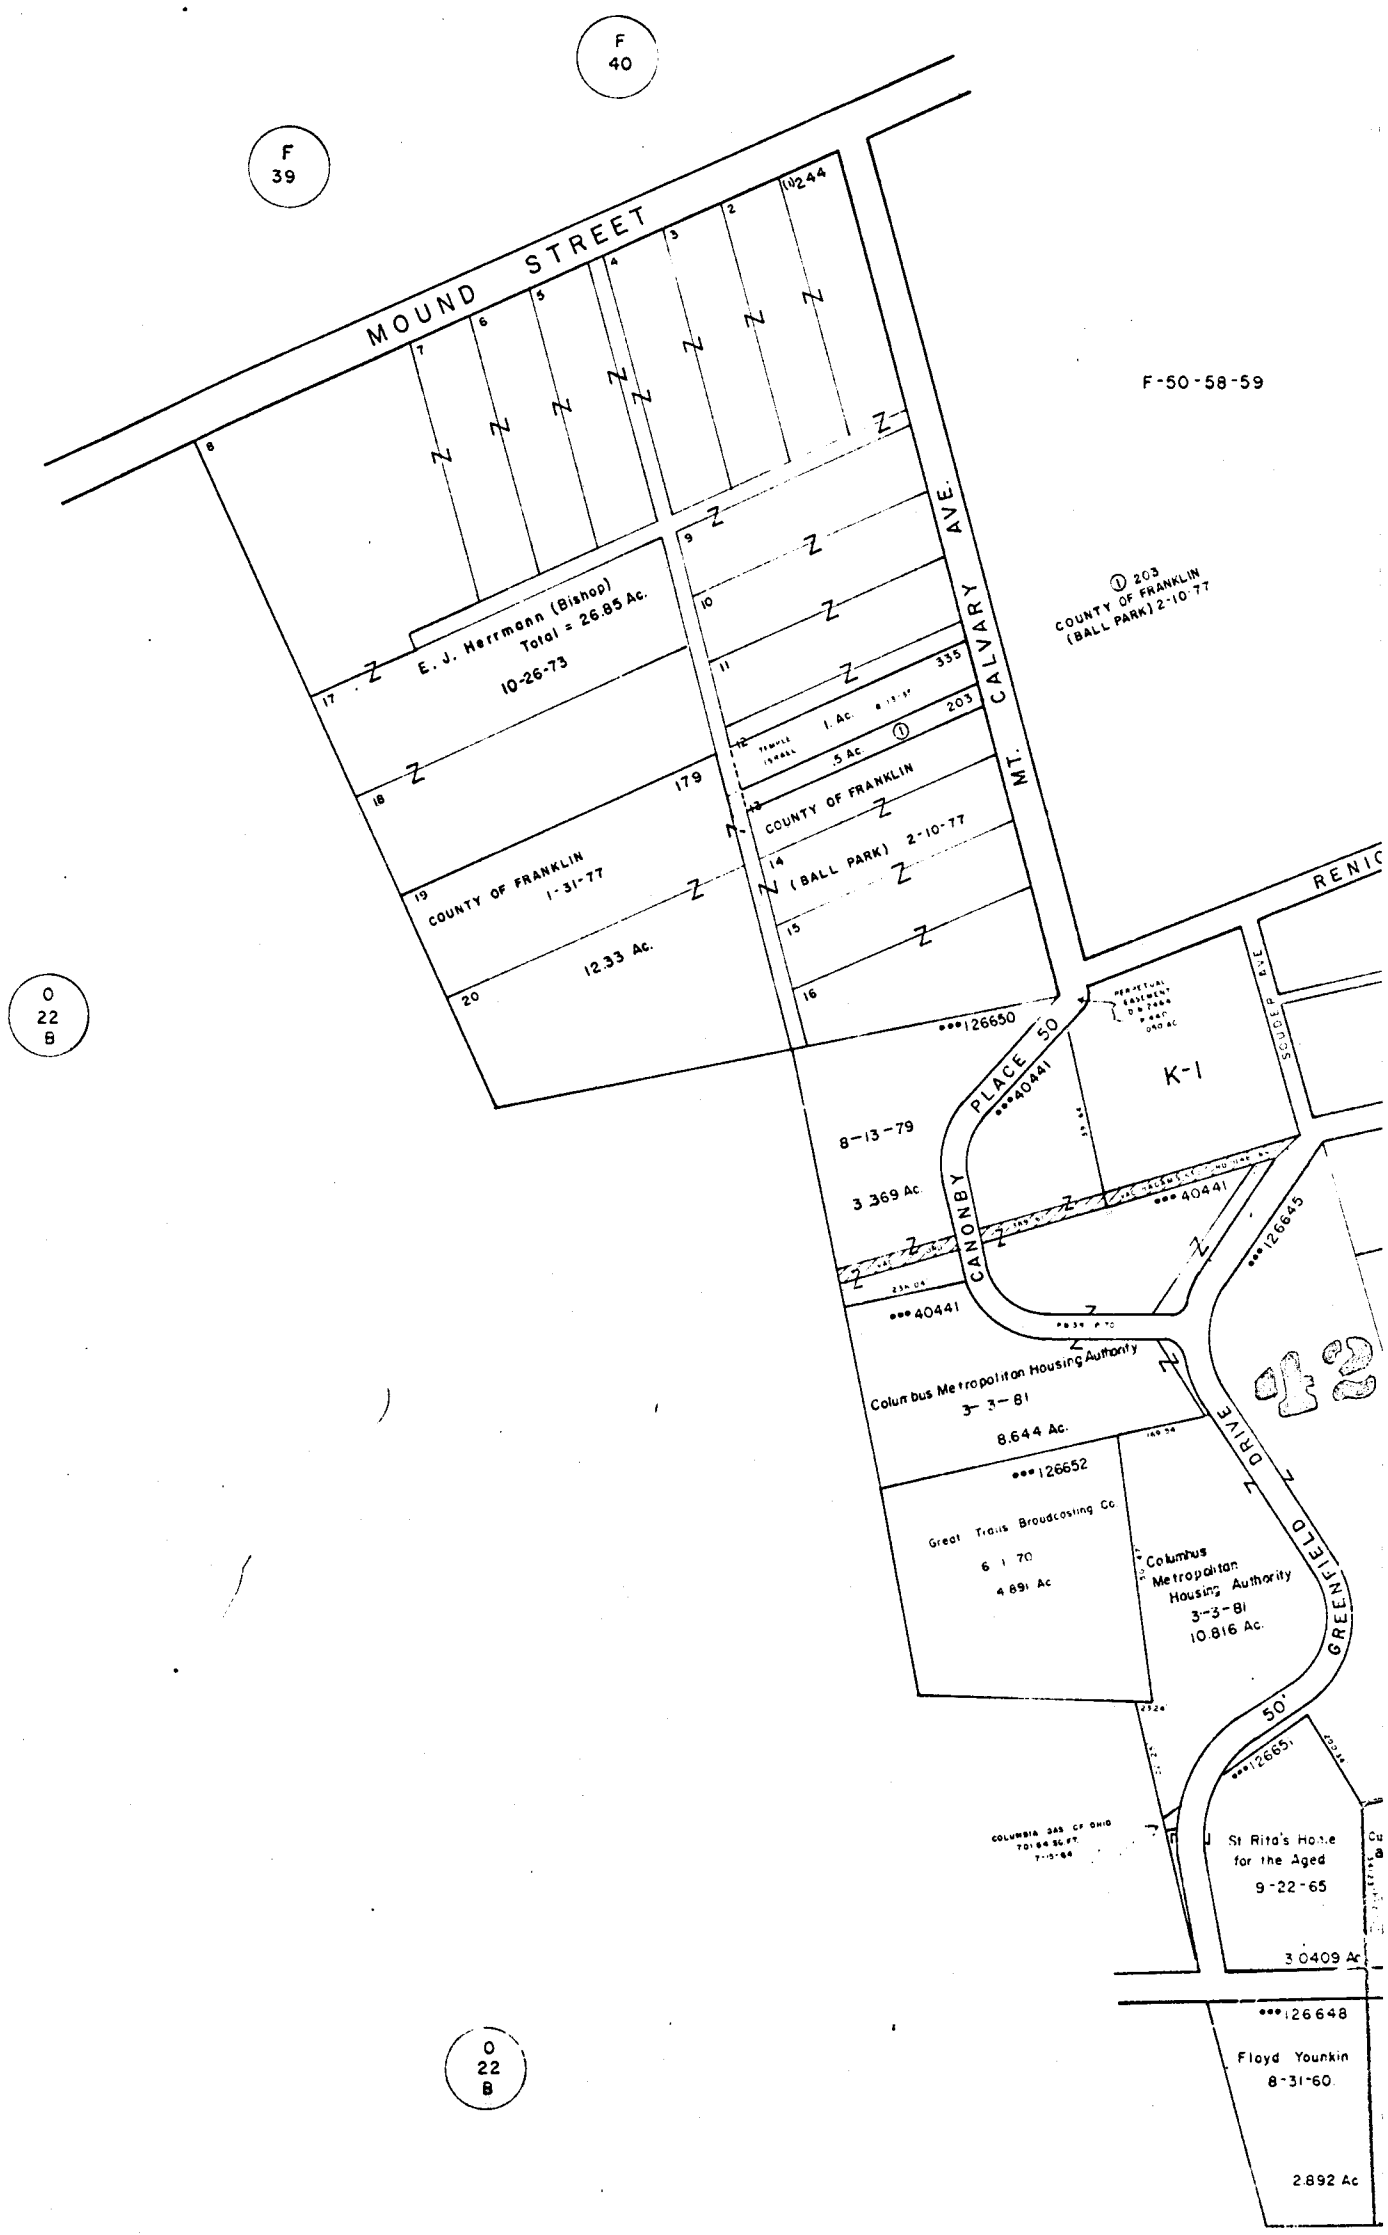
F 40
F 39
MOUND STREET
CALVARY AVE.
MT.
F-50-58-59
(1)244
E. J. Herrmann (Bishop)
Total = 26.85 Ac.
10-26-73
179
COUNTY OF FRANKLIN
1-31-77
12.33 Ac.
COUNTY OF FRANKLIN
(BALL PARK) 2-10-77
1 Ac.
.5 Ac.
335
203
(1) 203
COUNTY OF FRANKLIN
(BALL PARK) 2-10-77
RENICK
O 22 B
126650
K-1
CANONBY PLACE
40441
8-13-79
3.369 Ac.
SCUDDER AVE
126645
Columbus Metropolitan Housing Authority
3-3-81
8.644 Ac.
126652
Great Trails Broadcasting Co
6-1-70
4.891 Ac
Columbus Metropolitan Housing Authority
3-3-81
10.816 Ac.
GREENFIELD DRIVE
50'
126651
St Rita's Home for the Aged
9-22-65
3.0409 Ac
126648
Floyd Younkin
8-31-60
2.892 Ac
O 22 B
O 22 G

O-22-C

FRANKLIN TWP.

SCALE 1"=200'
V M S
E=HIGHWAY EASEMENT

TAXING DISTRICTS	DISTRICTS CODE
FRANKLIN	140
**COLS-SOUTHWESTERN S.D.	570
*** CITY OF COLS	010

H--- HOUSE NUMBERS

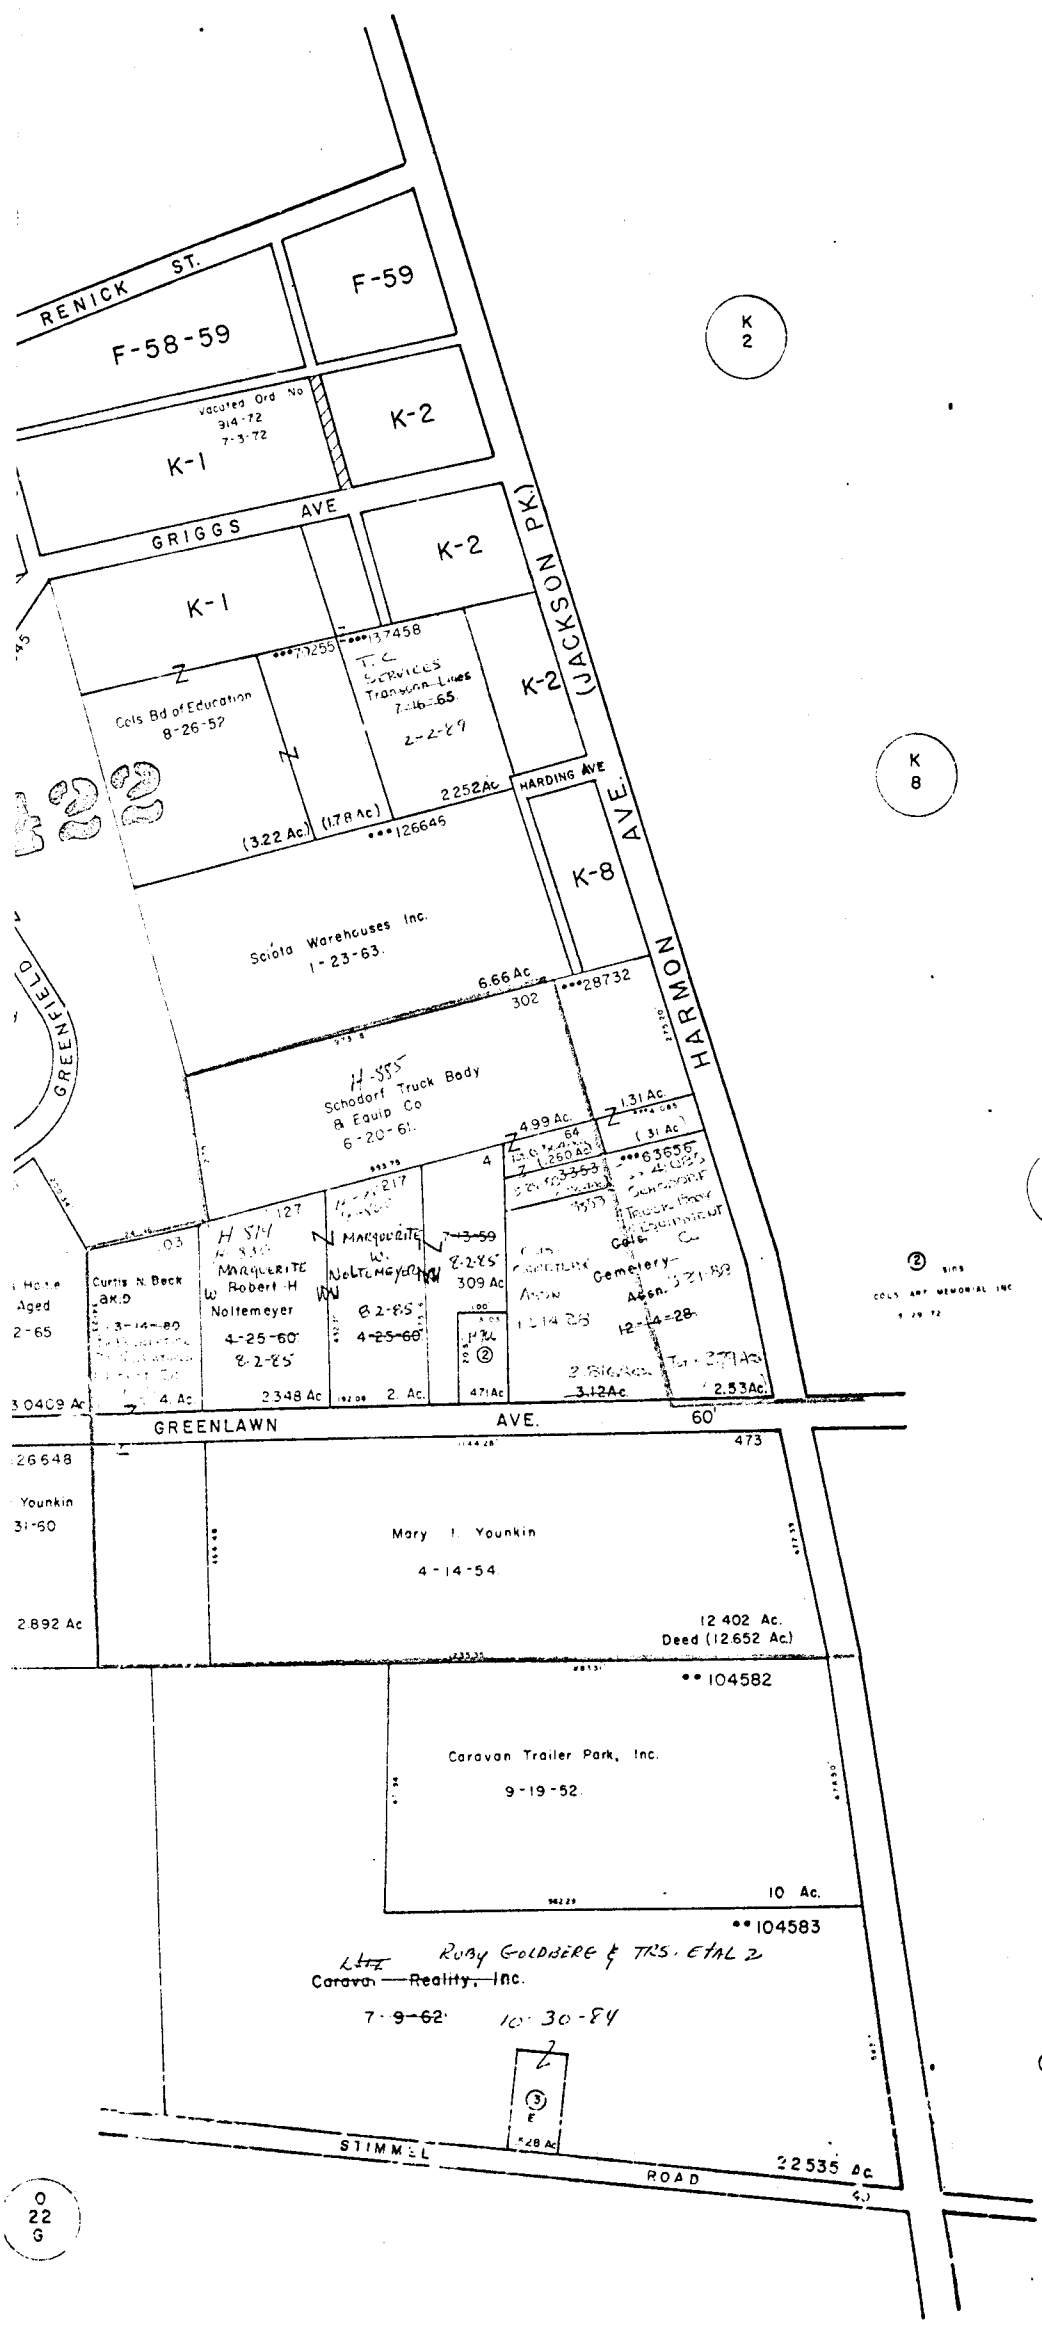

O-22-C