



O-26-B
 HAMILTON TWP
 R.22 TWP.4

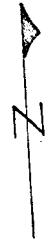

SCALE 1"=200'
 E=HIGHWAY EASEMENT
 TAX INCLOSURE EXTRACT FILE
 HAMILTON 150
 HAMILTON DIST. COR. 183

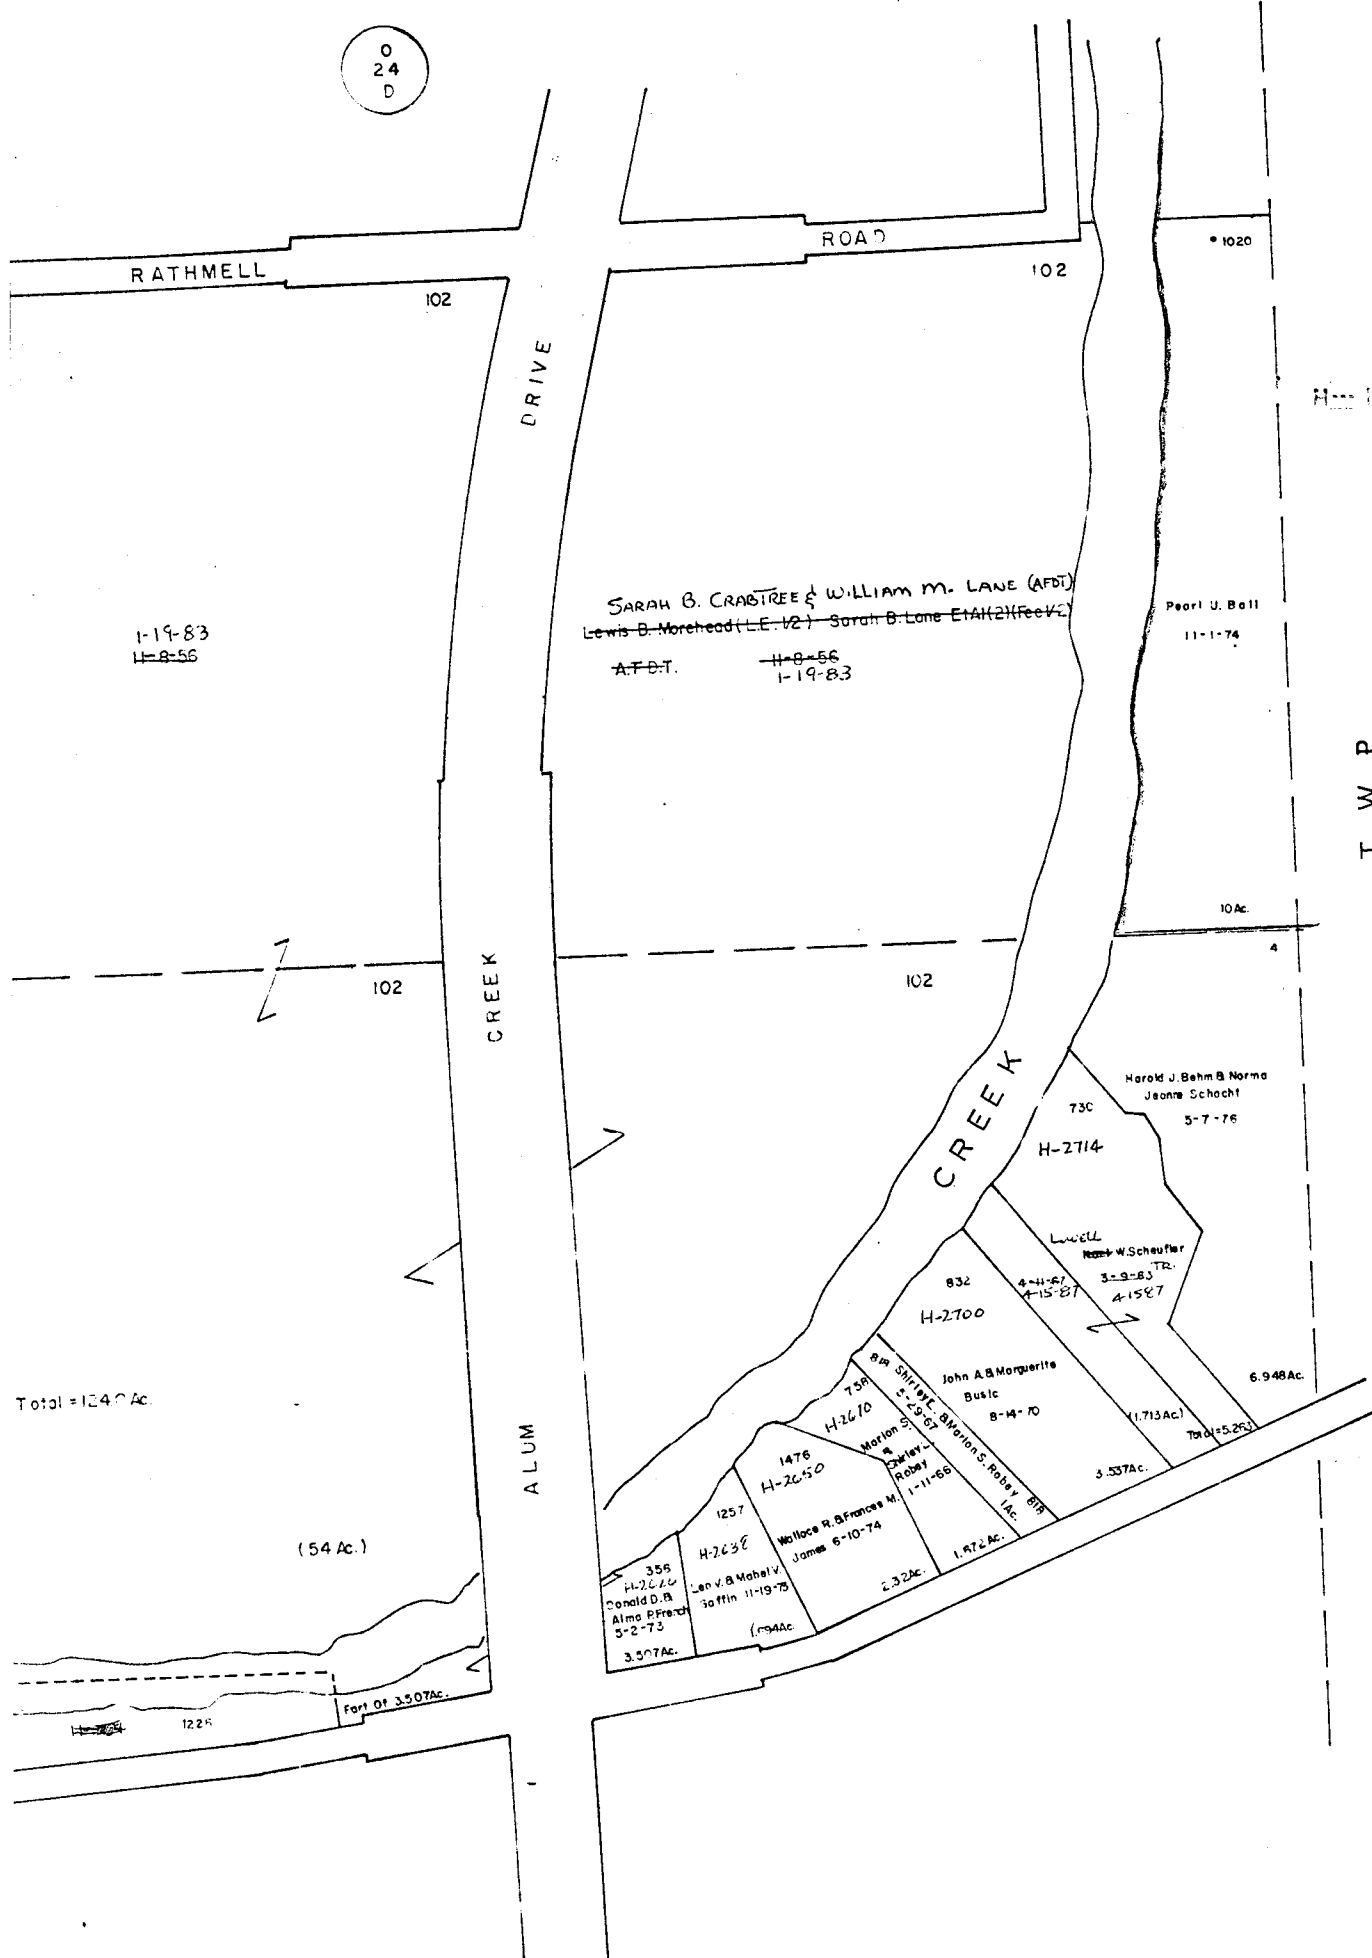

T W P

MADISON

0
24
D

0
44
E

0
2
C