

M-86-E

ORDERS

Z

Carl & Geneva Fryer
H/221
H/3399

O
33
D

6-24-52

123

10-18-61

10.2 Ac

1371

Z

Betty J. Priwer

10-18-61

0-33-E

JACKSON TWP



SCALE 1" = 200'

V.M.S.


E=HIGHWAY EASEMENT

TAXING DISTRICT. DISTRICT CODE

JACKSON TWP 160

H... HOUSE NUMBERS

0
33
B

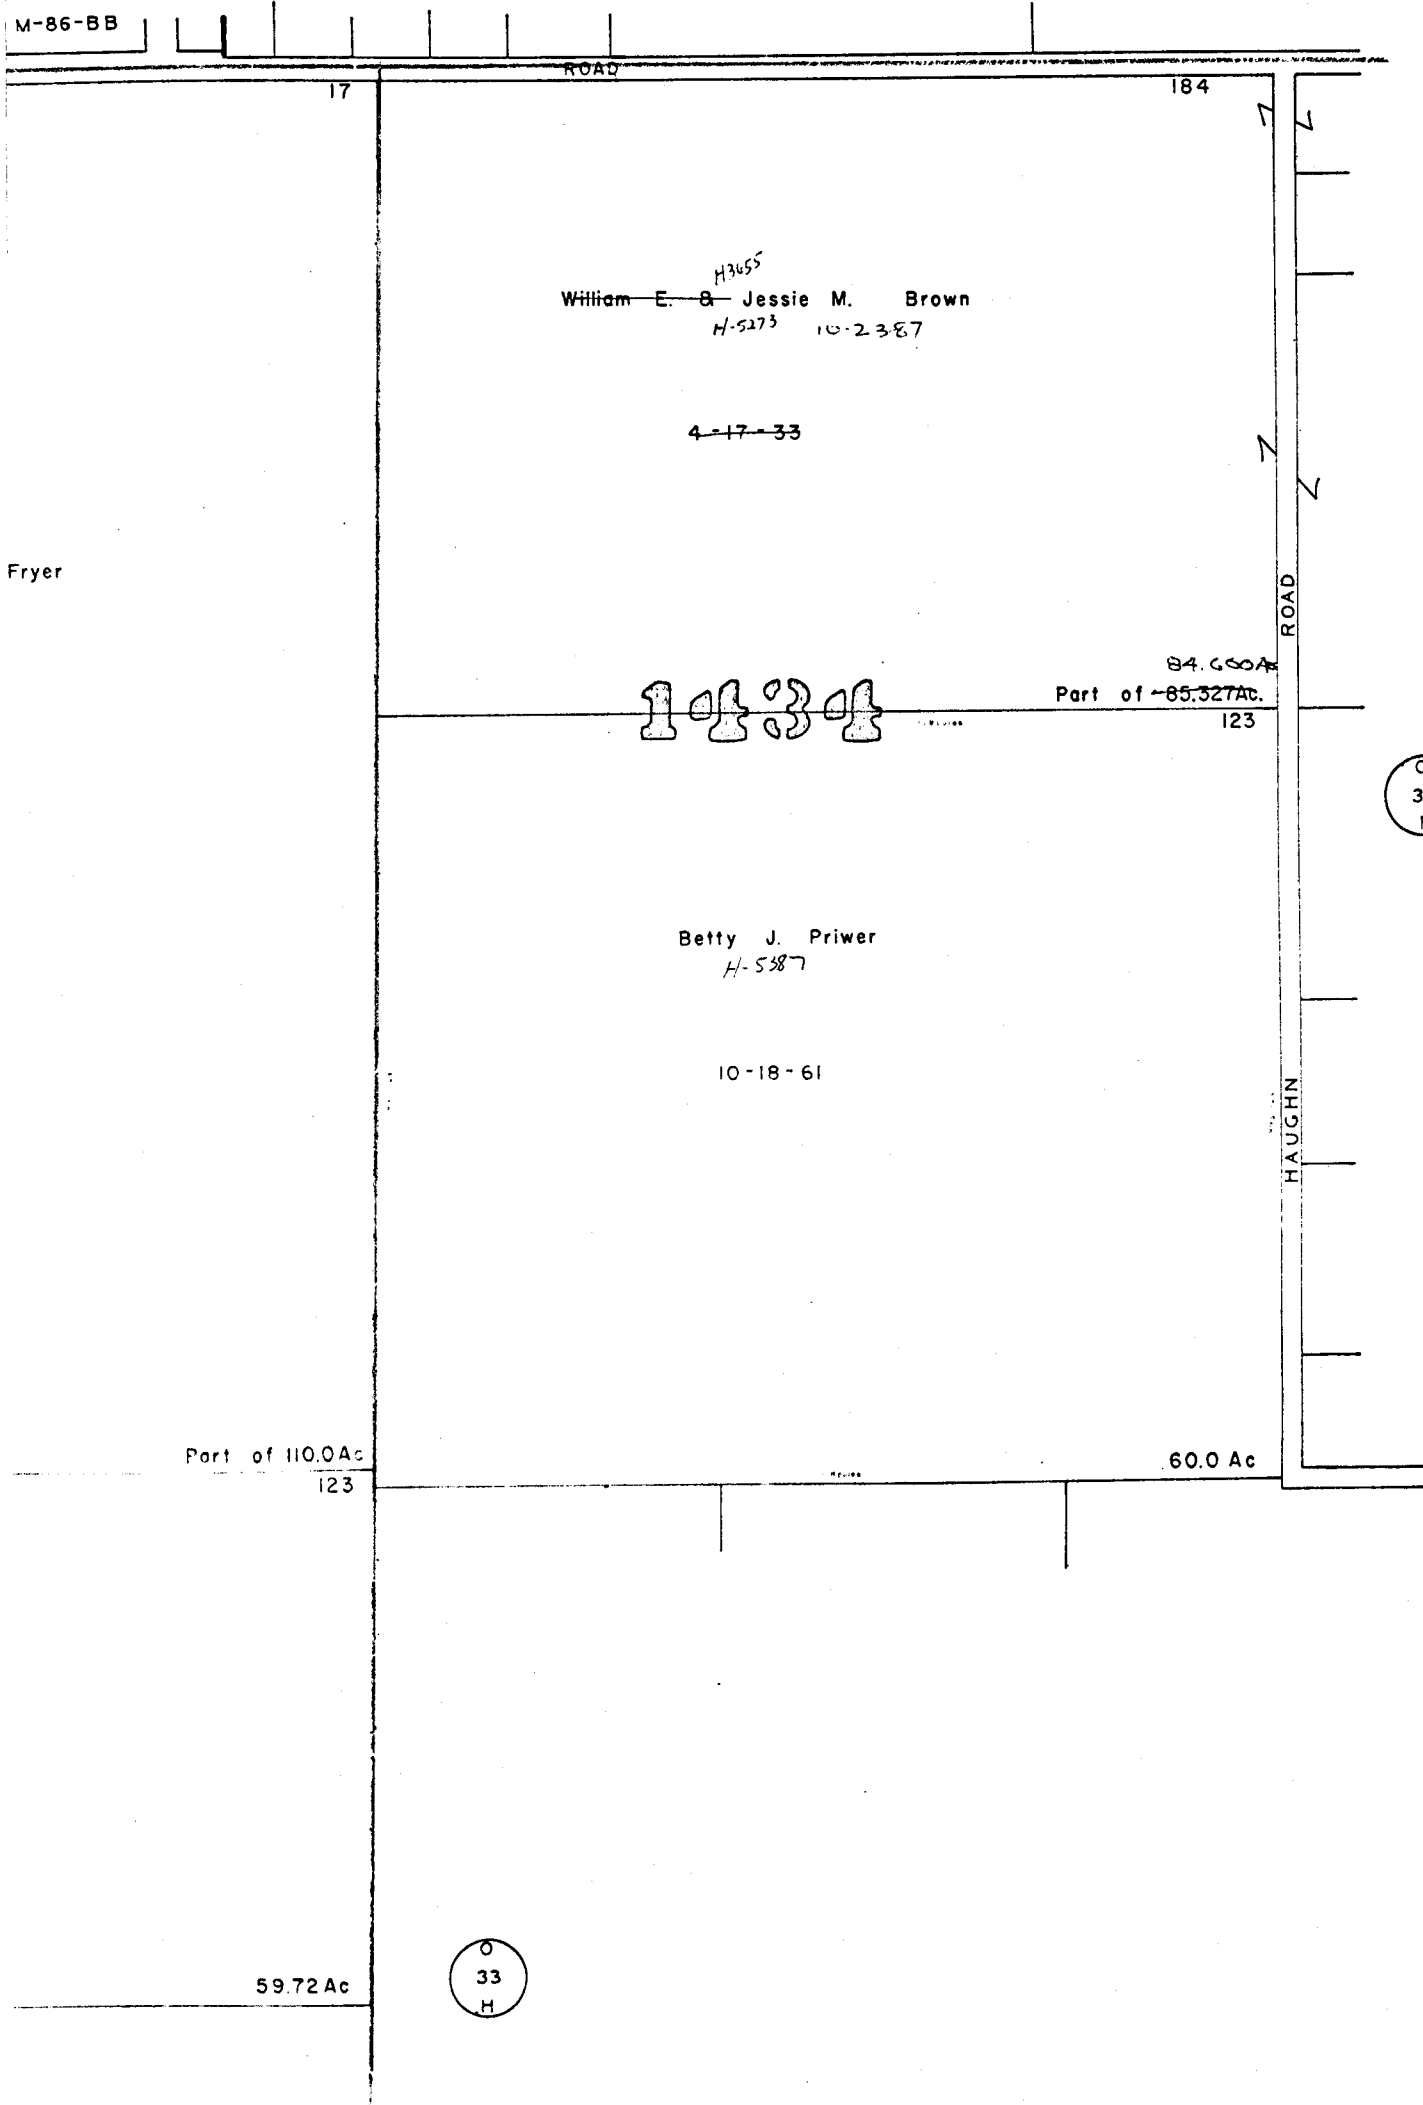

0
33
F

0
33
H

0-33-E

454