

O
33
E

18

37









O
35
A

0-33-H

JACKSON TWP




SCALE 1" = 200'

E=HIGHWAY EASEMENT
TAXING DISTRICT JACKSON TWP. DISTRICT CODE 160



HOUSE NUMBER

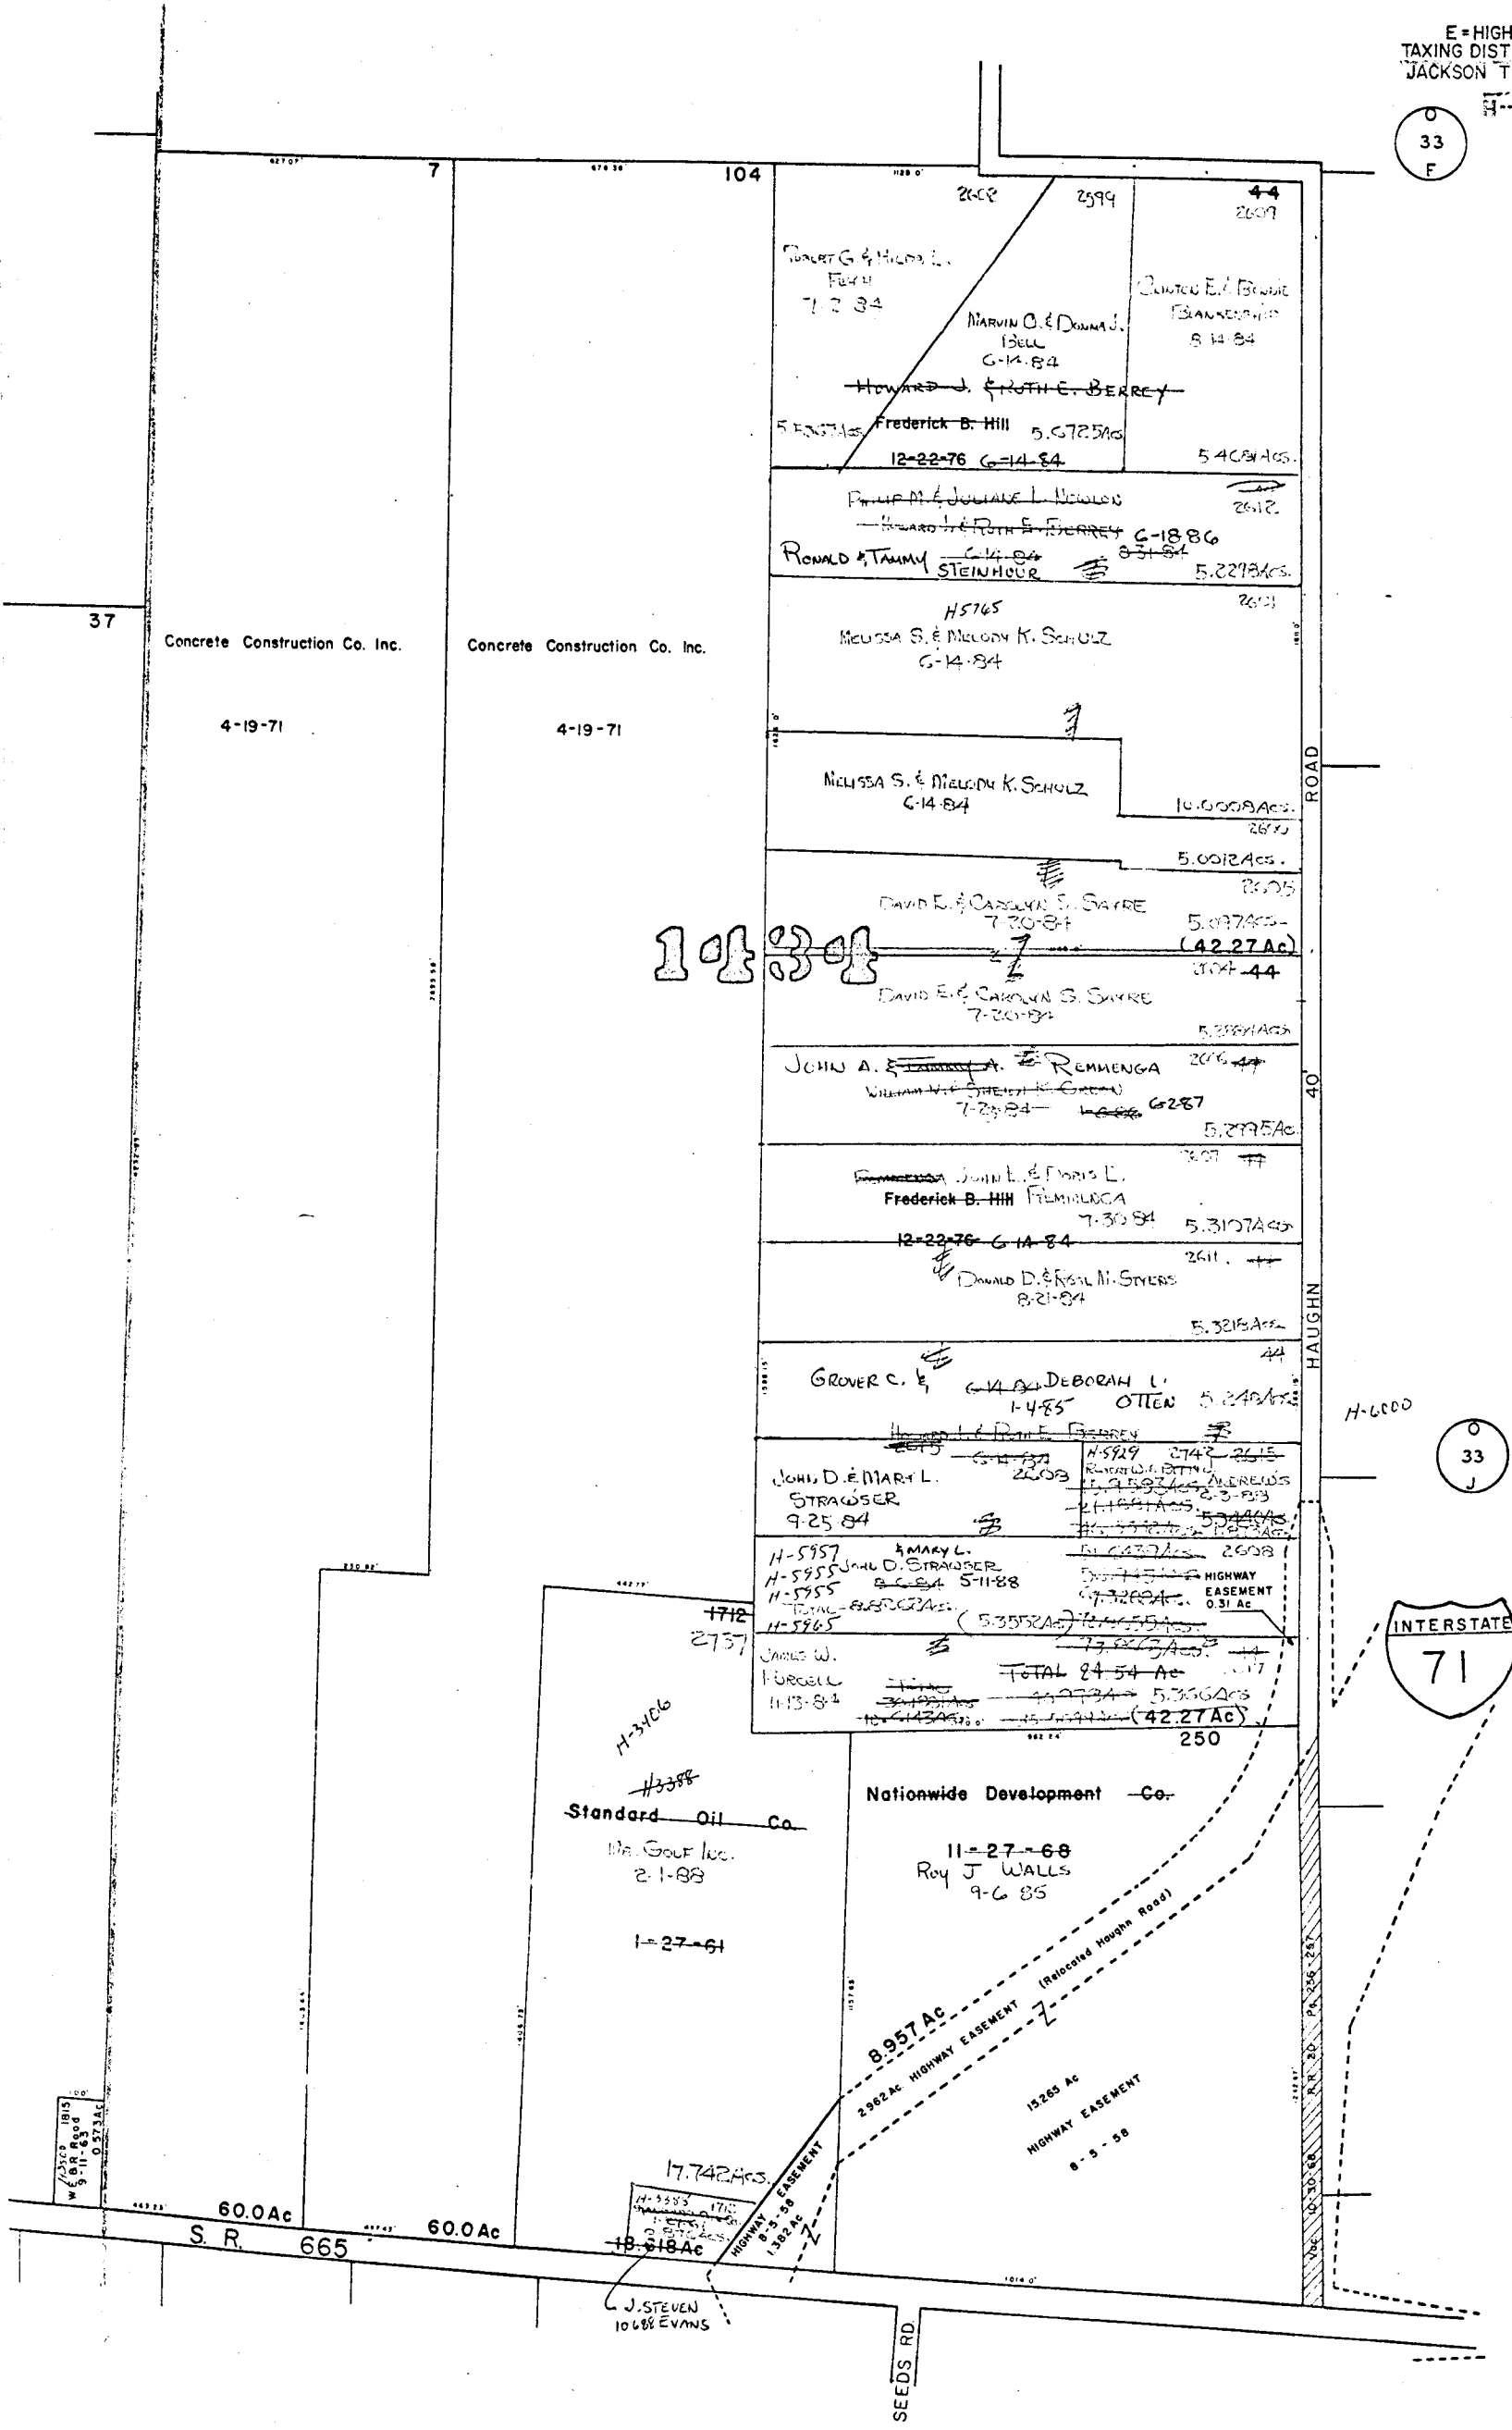

1434

ROAD
40
HAUGHN

H-6000



0-33-H

460