



① 401 MARK W. & DEBORAH A. McCLONE 8-27-84 0.81Ac.  
 ② 5671 NEAL M. GRIESEMAUER 9-19-84 0.124Ac.

**O-35-B**  
**JACKSON TWP**

SCALE N 1" = 200'


E=HIGHWAY EASEMENT

TAXING DISTRICT JACKSON TWP. DISTRICT CODE 160  
 V.M.S. GROVE CITY 040

H--- HOUSE NUMBERS

1434

33  
J

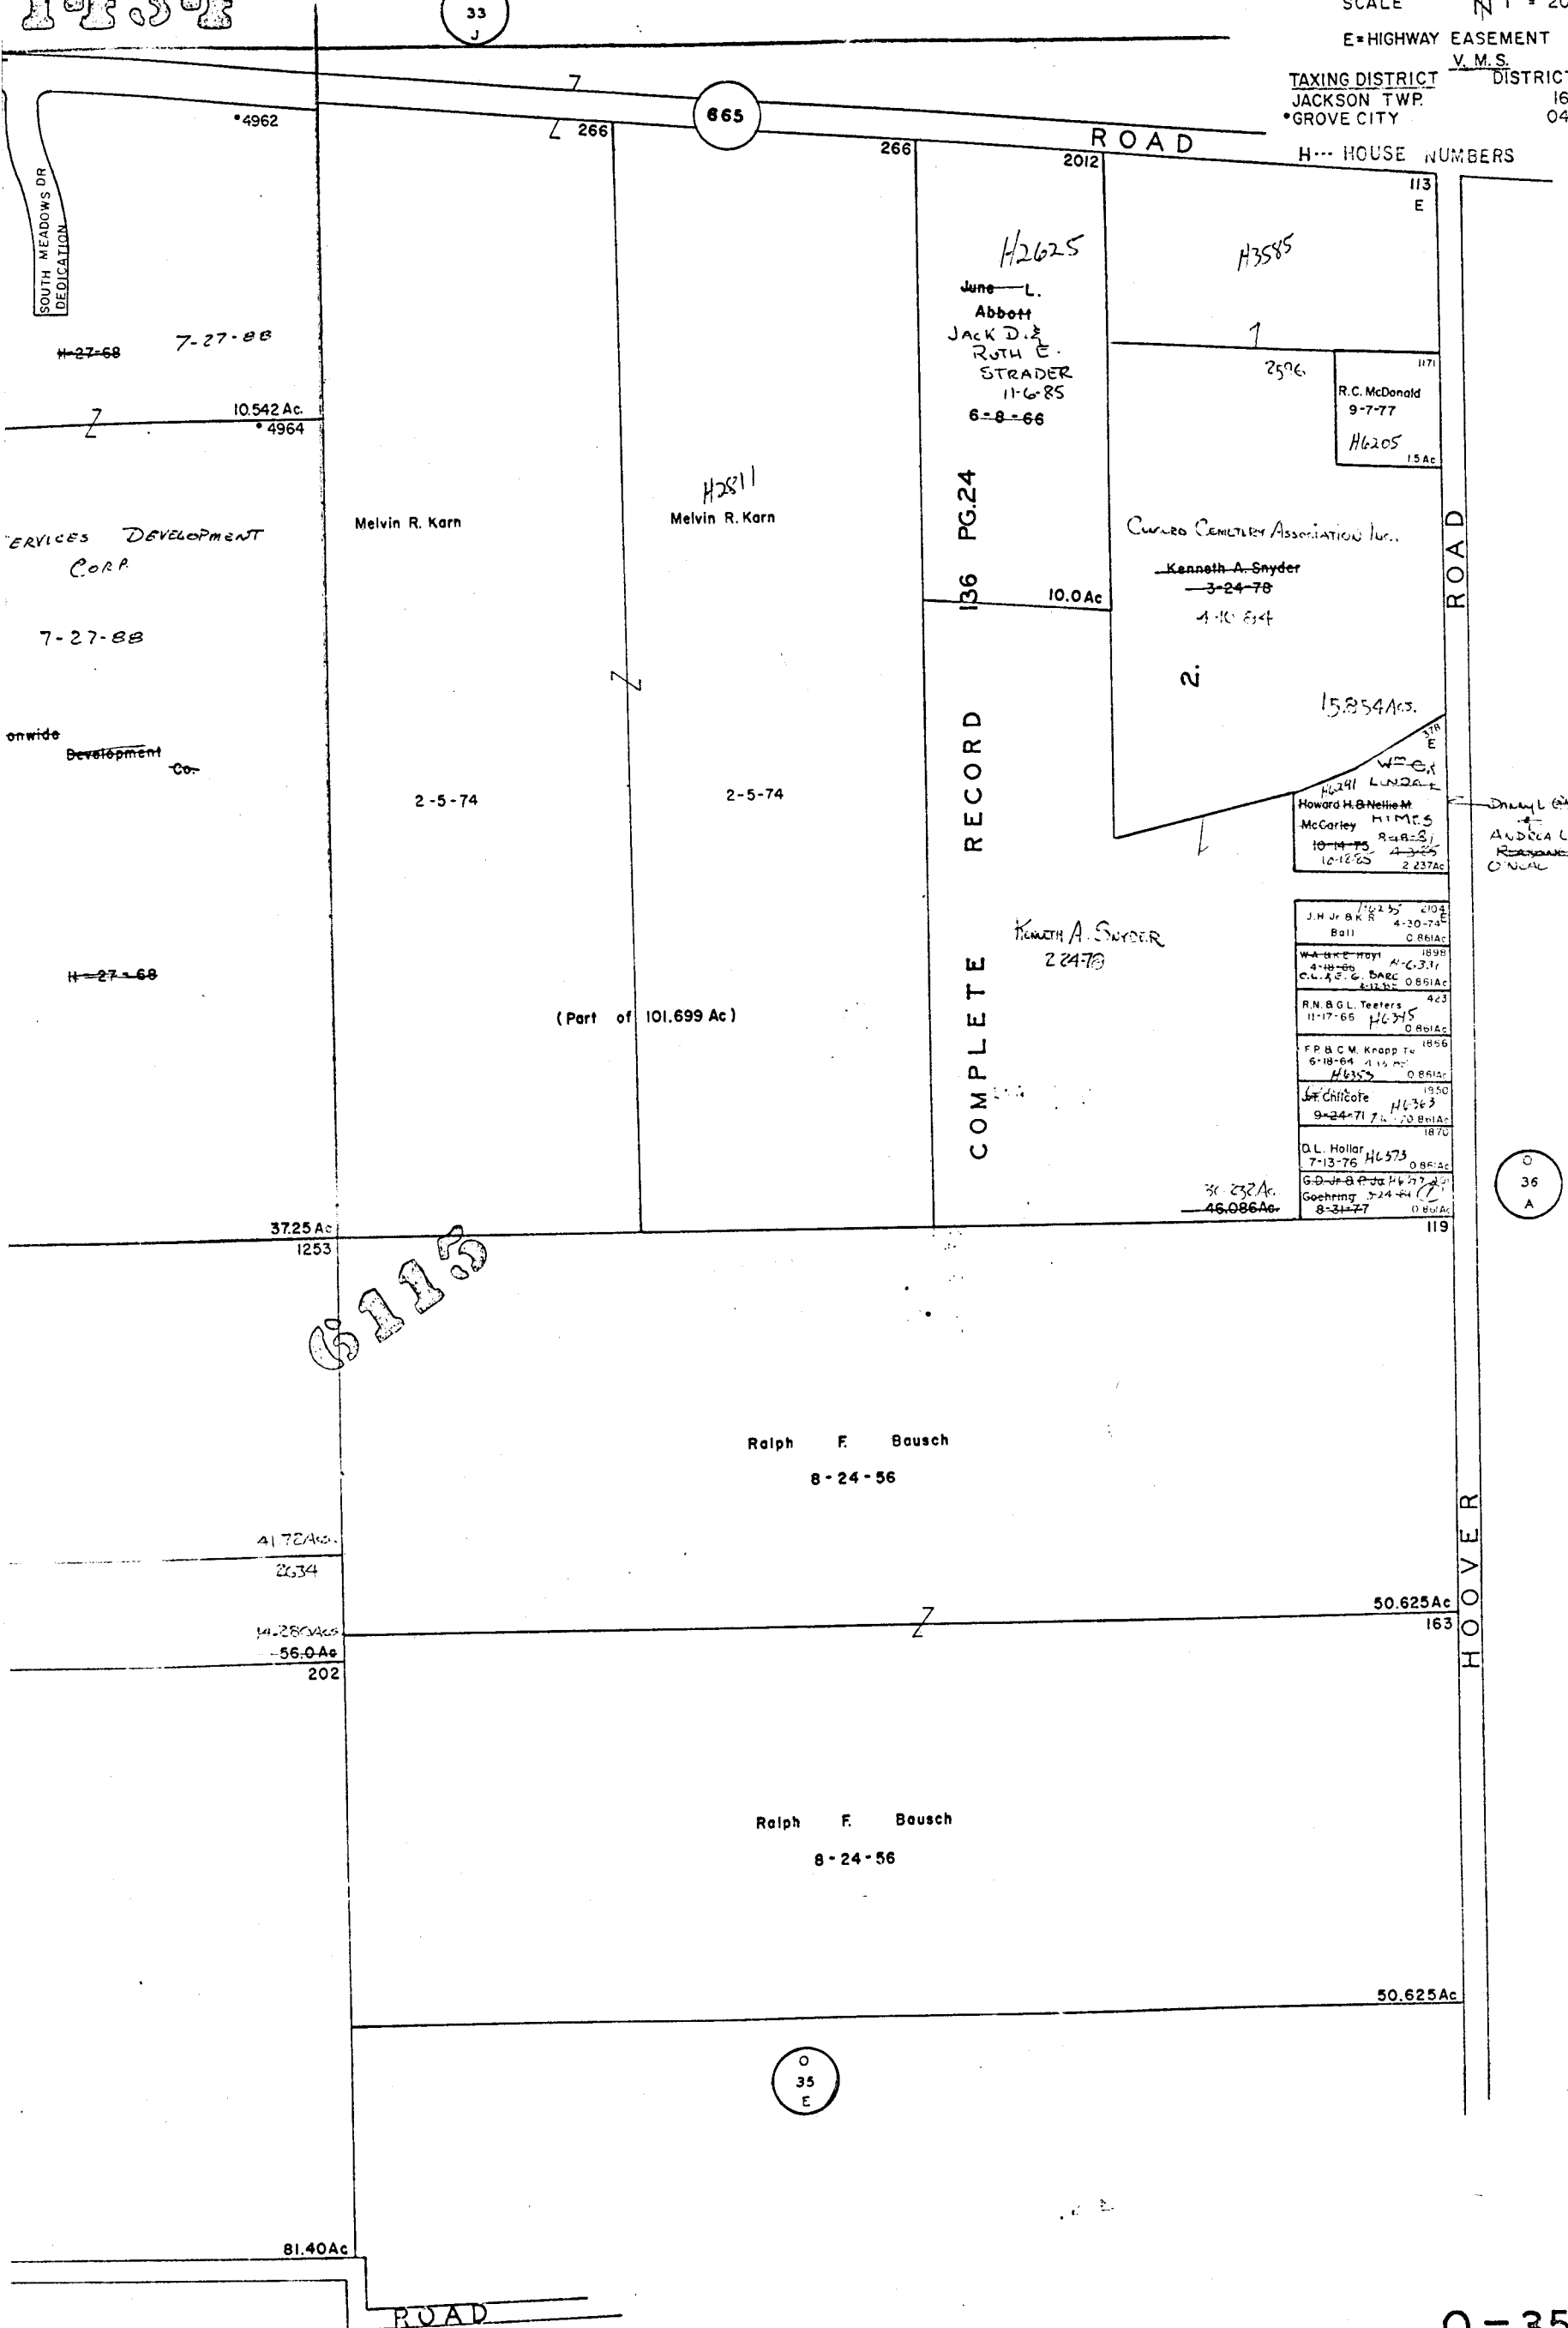

H225	210
J.N. & B.K. Ball	4-20-74
	0.861Ac
W.A. & E. May	1899
4-18-80	4-2-71
C.L. & E. G. BAC	0.861Ac
	4-2-71
R.N. & G.L. Teeters	4-23
11-17-66	H6315
	0.861Ac
F.P. & C.M. Knapp	1896
6-18-64	4-15-67
	H6355
	0.861Ac
J.W. Chitcote	1850
9-24-71	H6363
	0.861Ac
	1870
D.L. Hollar	1870
7-13-76	H6573
	0.861Ac
G.D. & B. P. & J. Goeching	7-24-74
8-21-77	0.861Ac

36  
A

O-35-B