


O-36-C

JACKSON TWP.

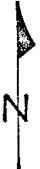


SCALE 1" = 200'

V. M. S.
 E=HIGHWAY EASEMENT
 TAXING DISTRICT DISTRICT CODE
 JACKSON TWP 160
 GROVE CITY 040
 H... HOUSE NUMBERS

0
34
F

0
30
D

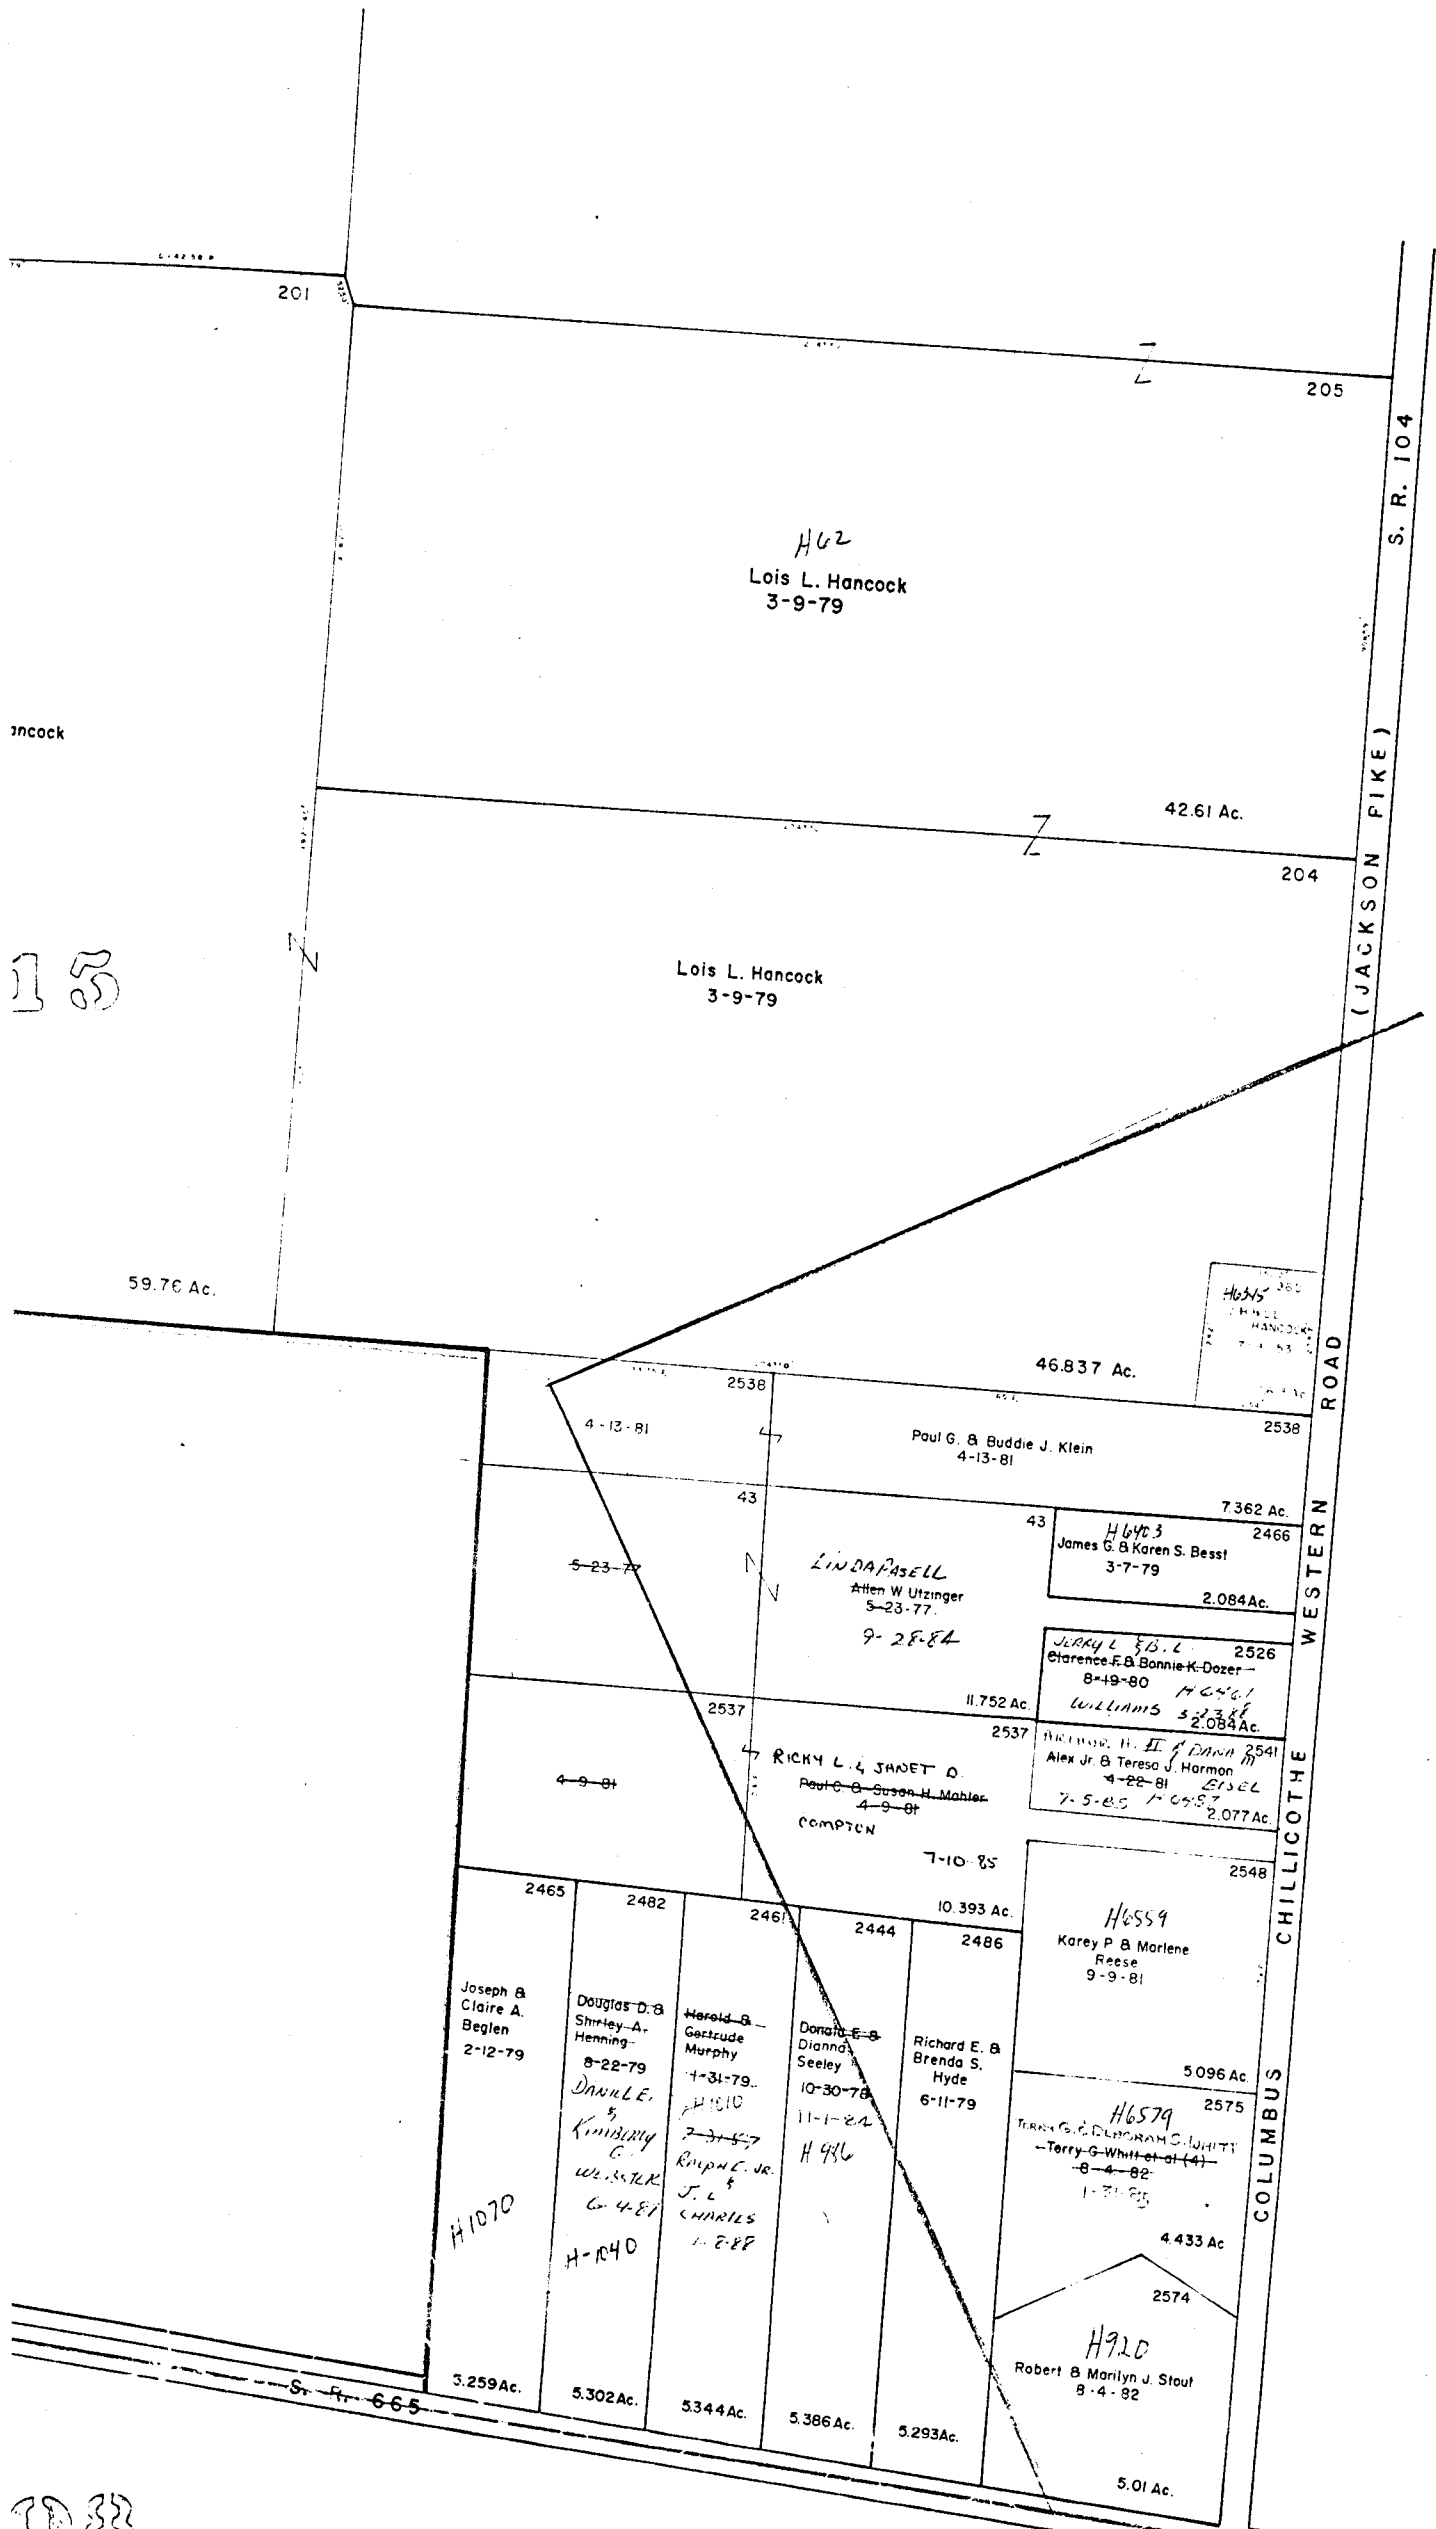

Hancock

15

1105

1133

O-36-C 502

104

9/2/82