


0 75

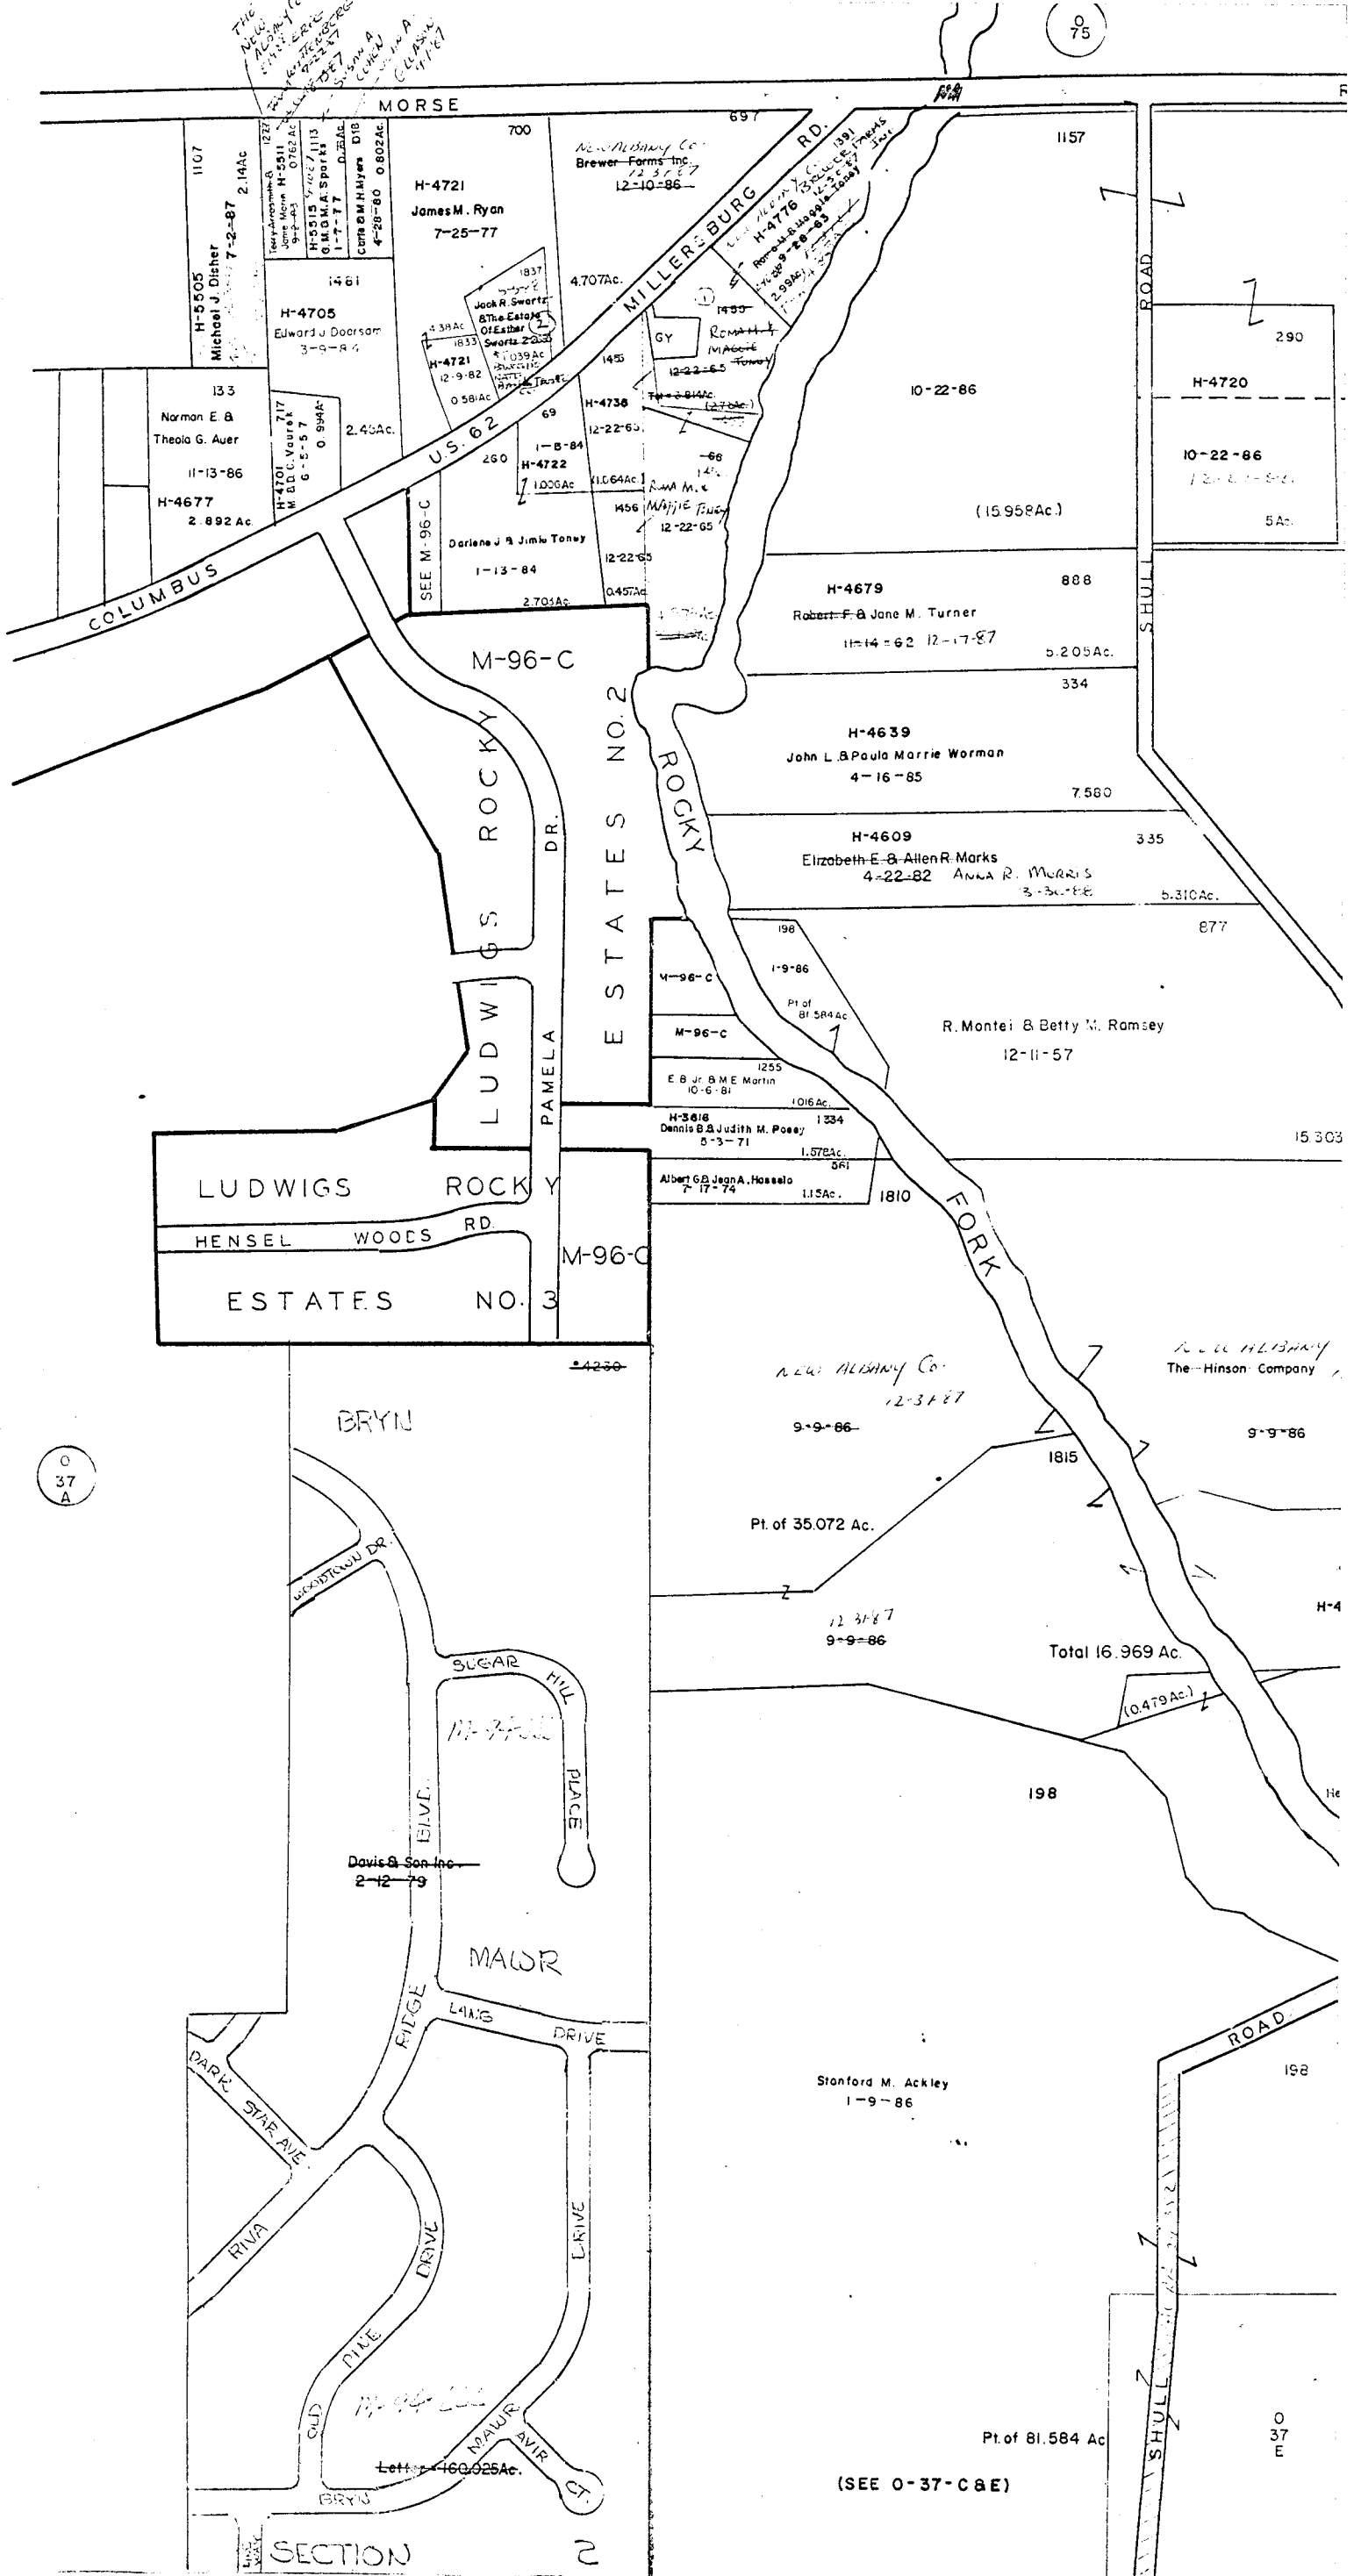


0-37-B


JEFFERSON TWP.
R.16 TWP.1

SCALE 1"=200'

E=HIGHWAY EASEMENT
TAXING DISTRICT DISTRICT CODE
JEFFERSON 170
CITY OF GAHANNA 025

H---HOUSE NUMBERS

FRANKLIN COUNTY SURVEY MONUMENT

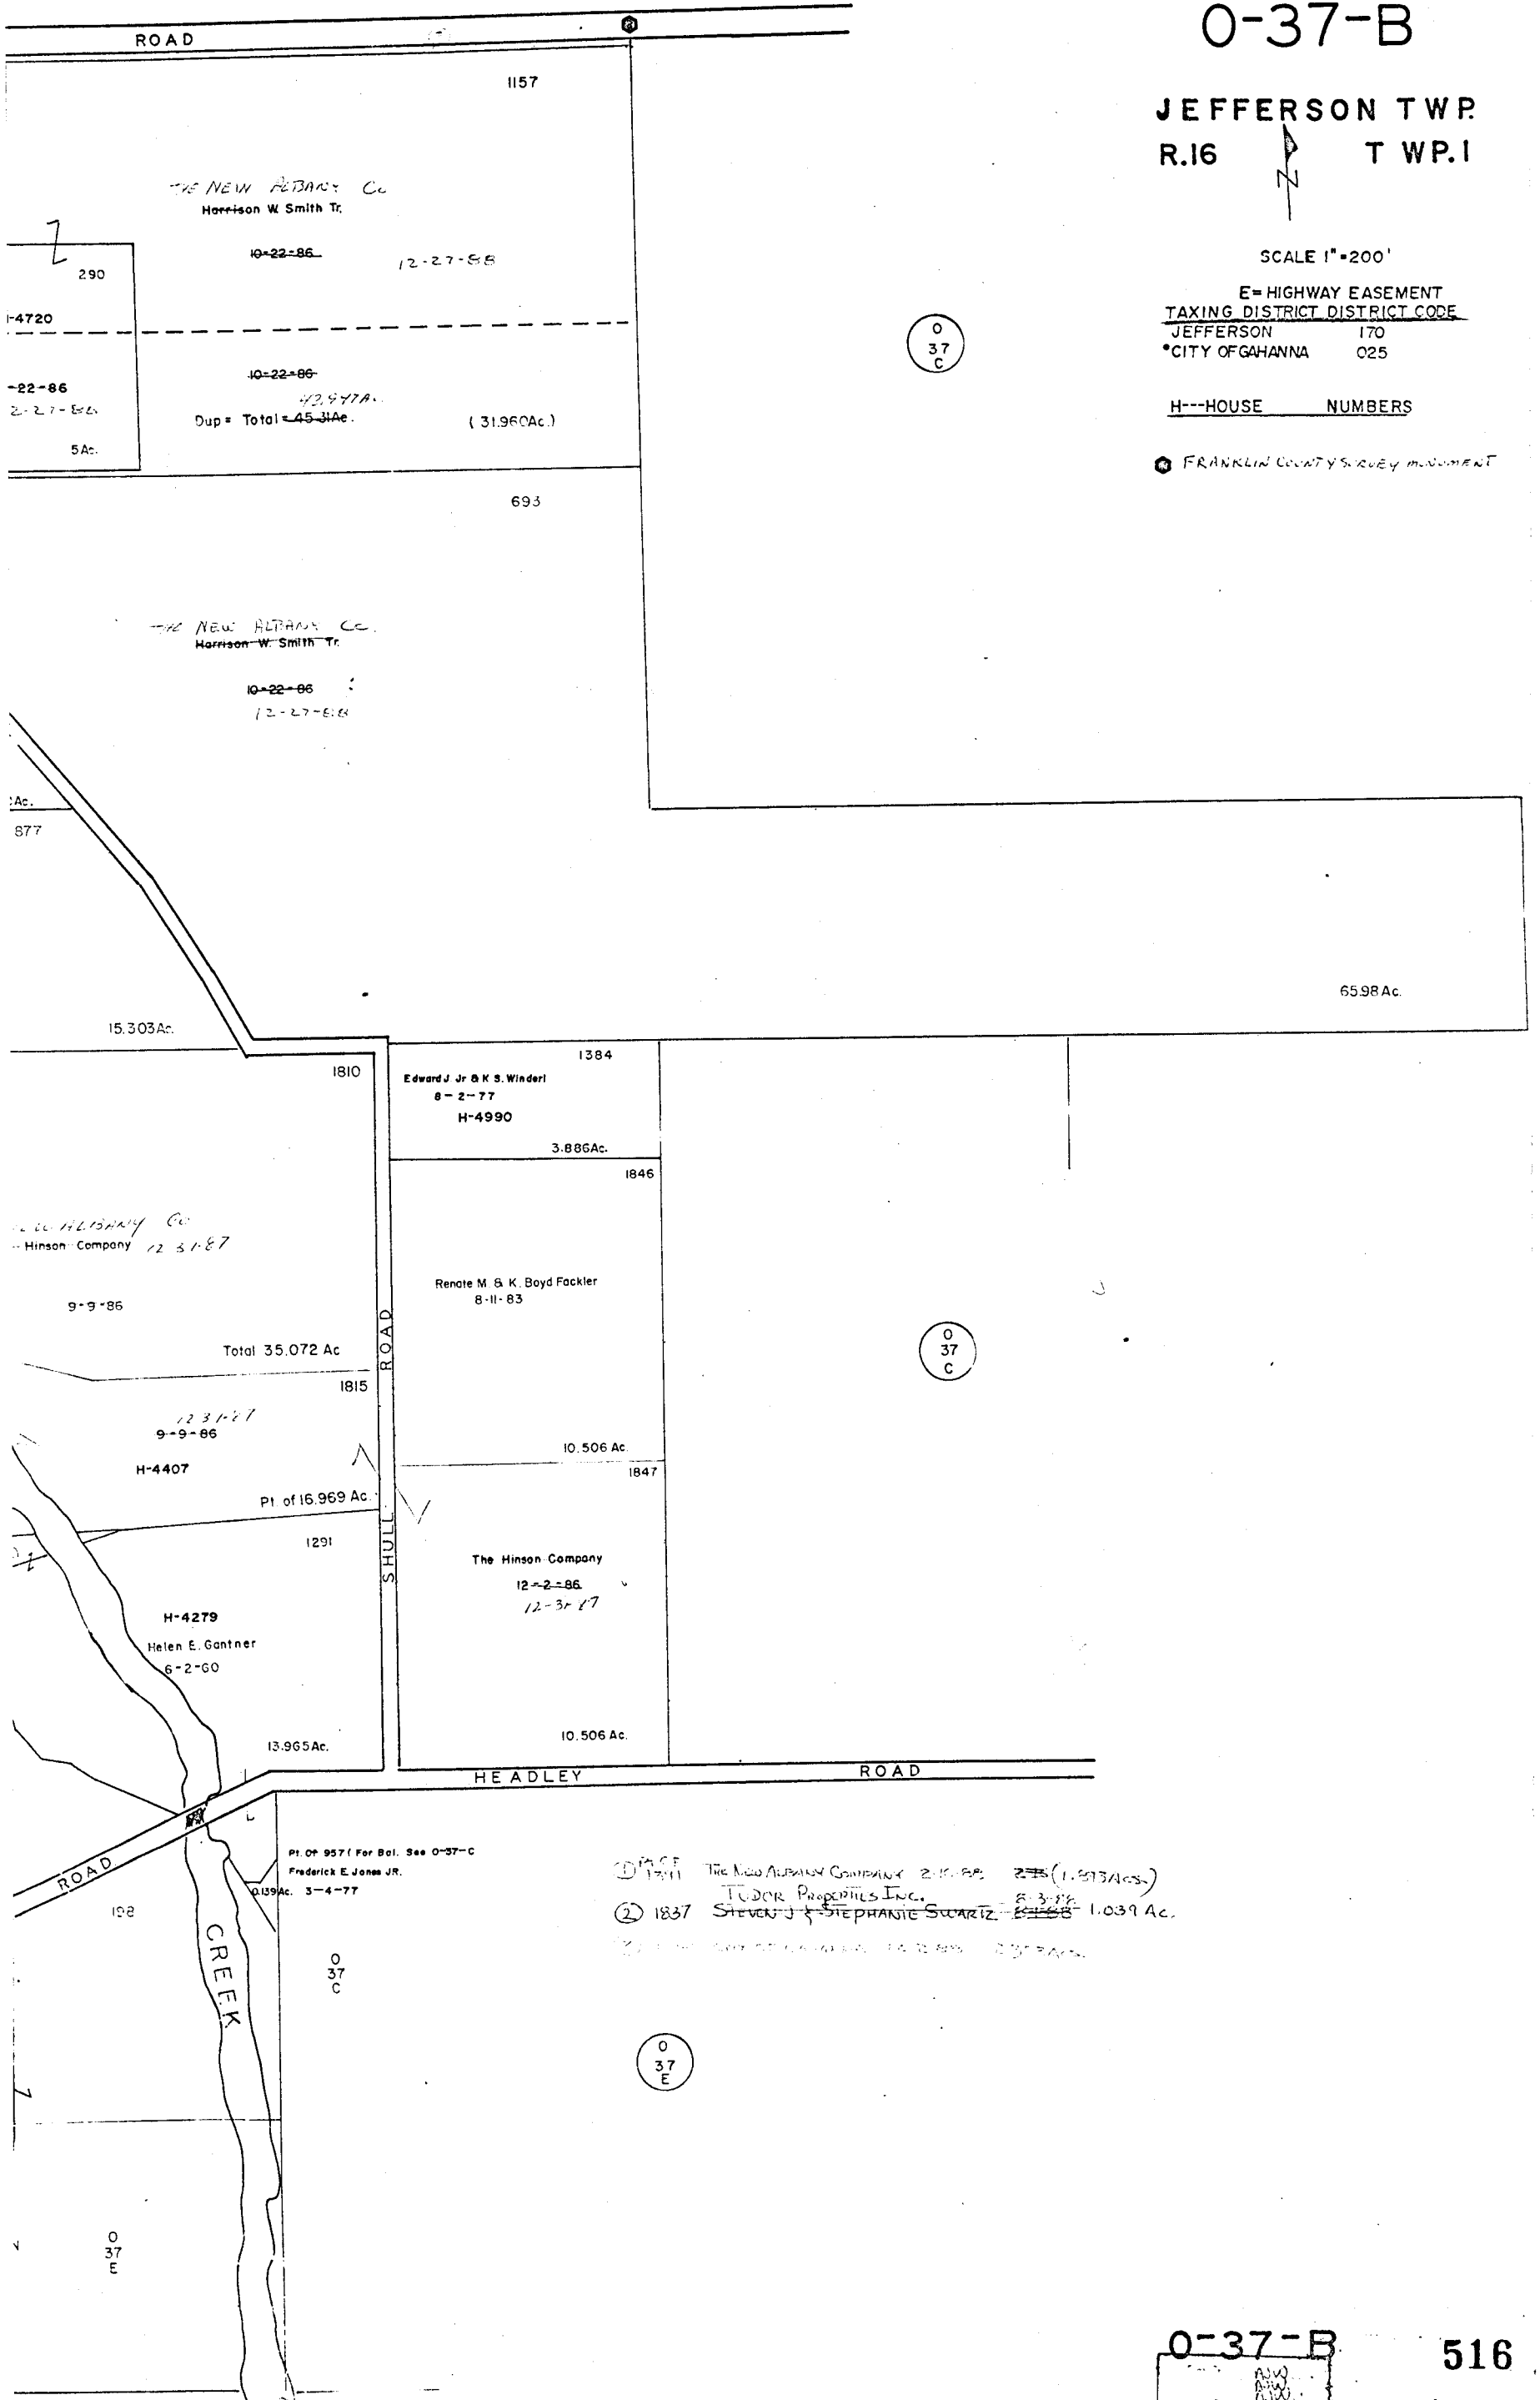

0-37-B