


0
75
H


PLAIN

MORSE

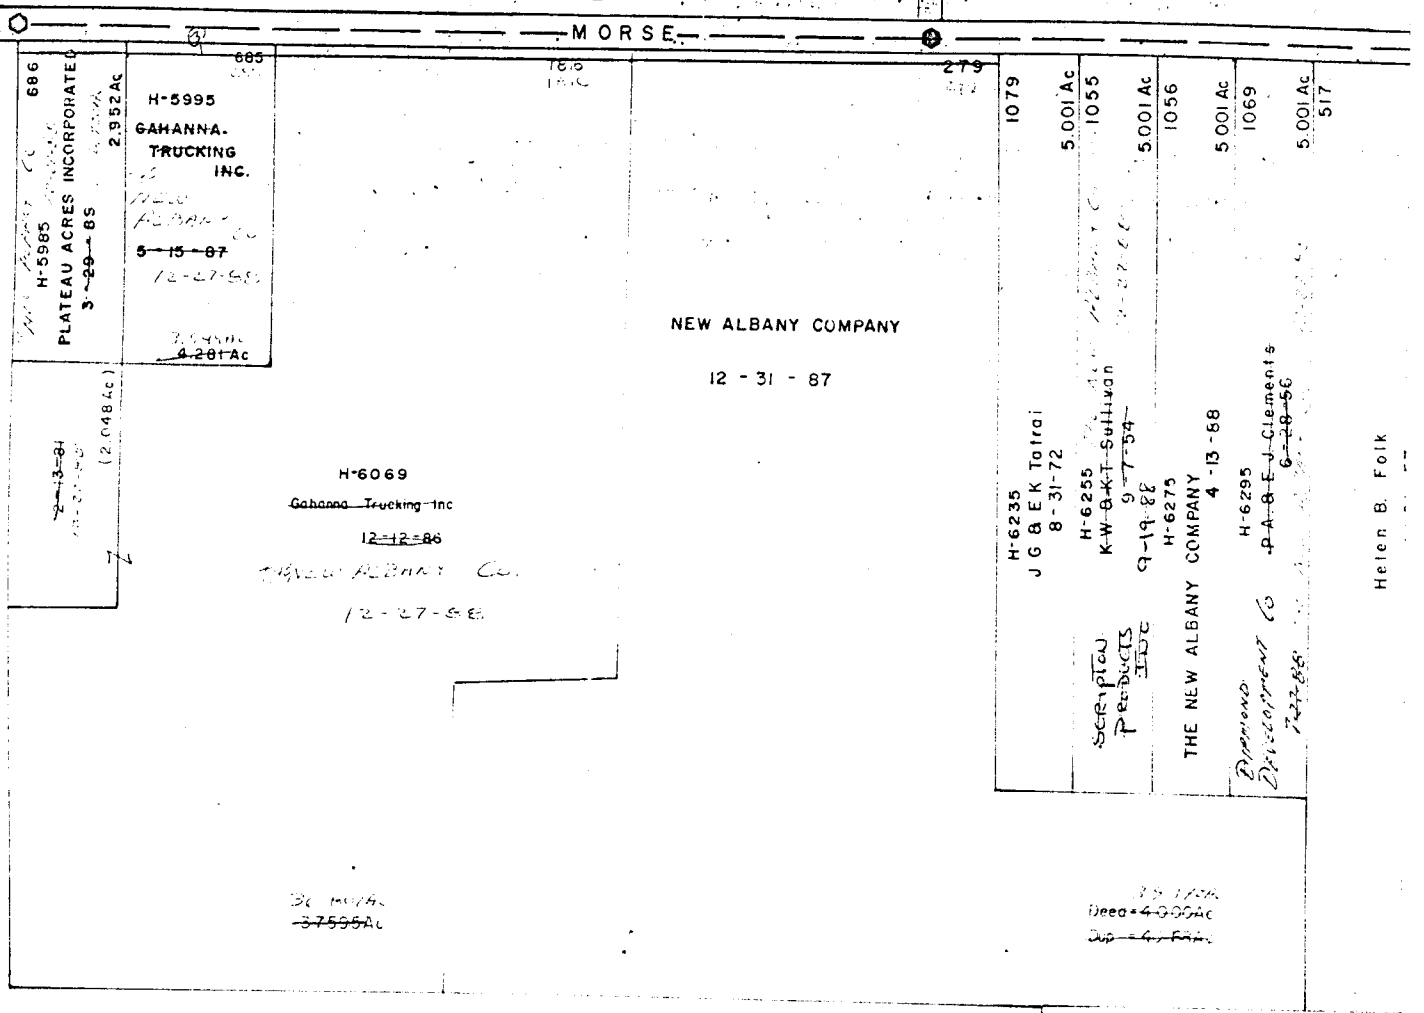

0
37
B


Helen B. Folk

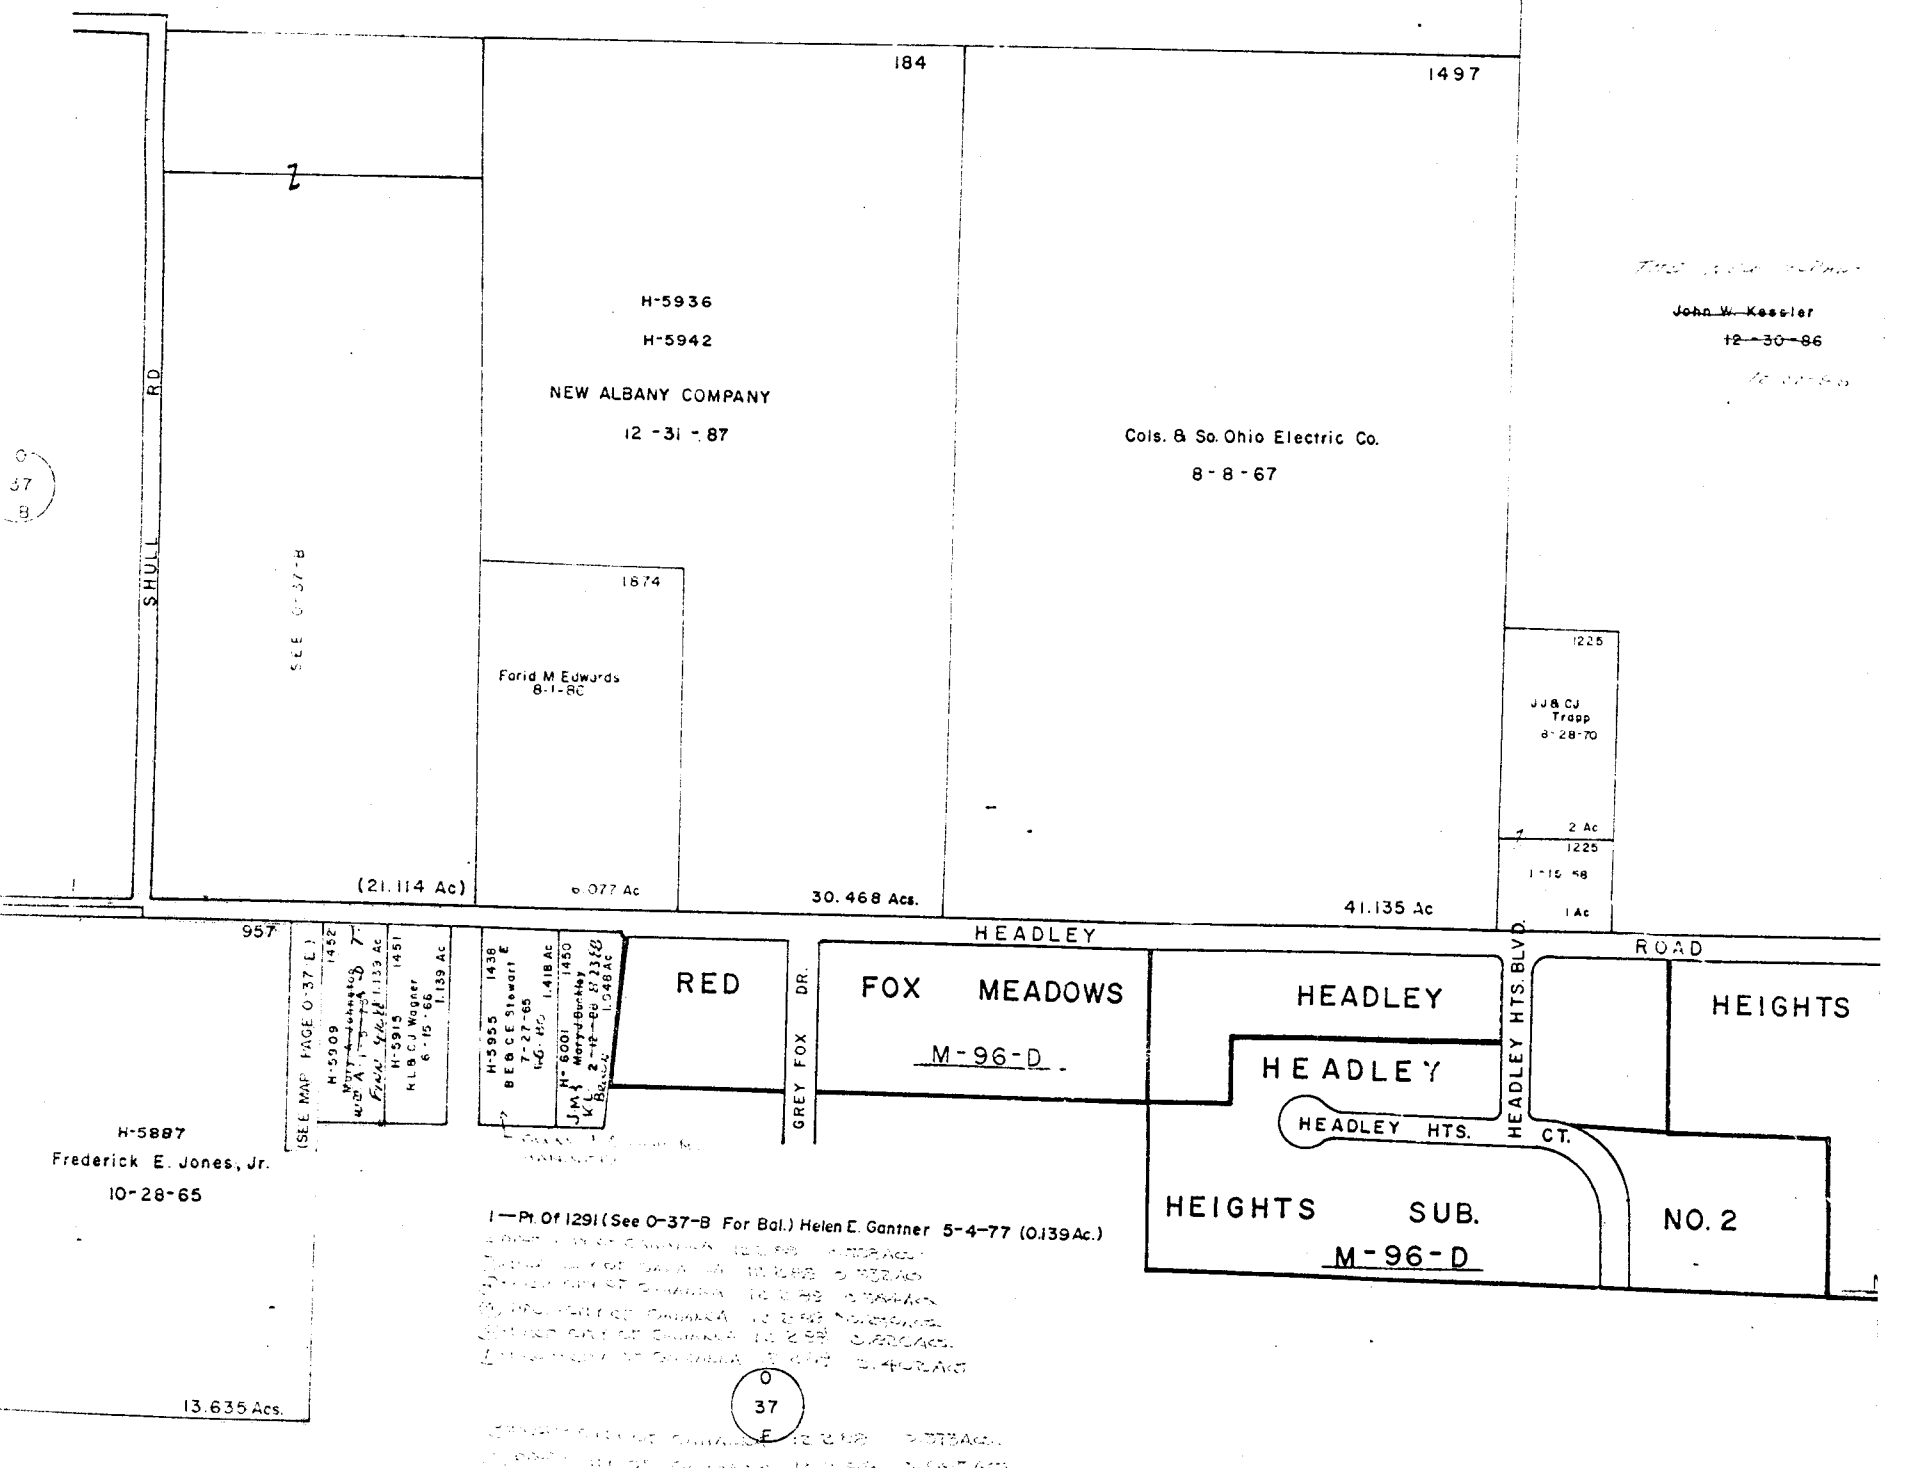

T W P

0
75
J

O-37-C

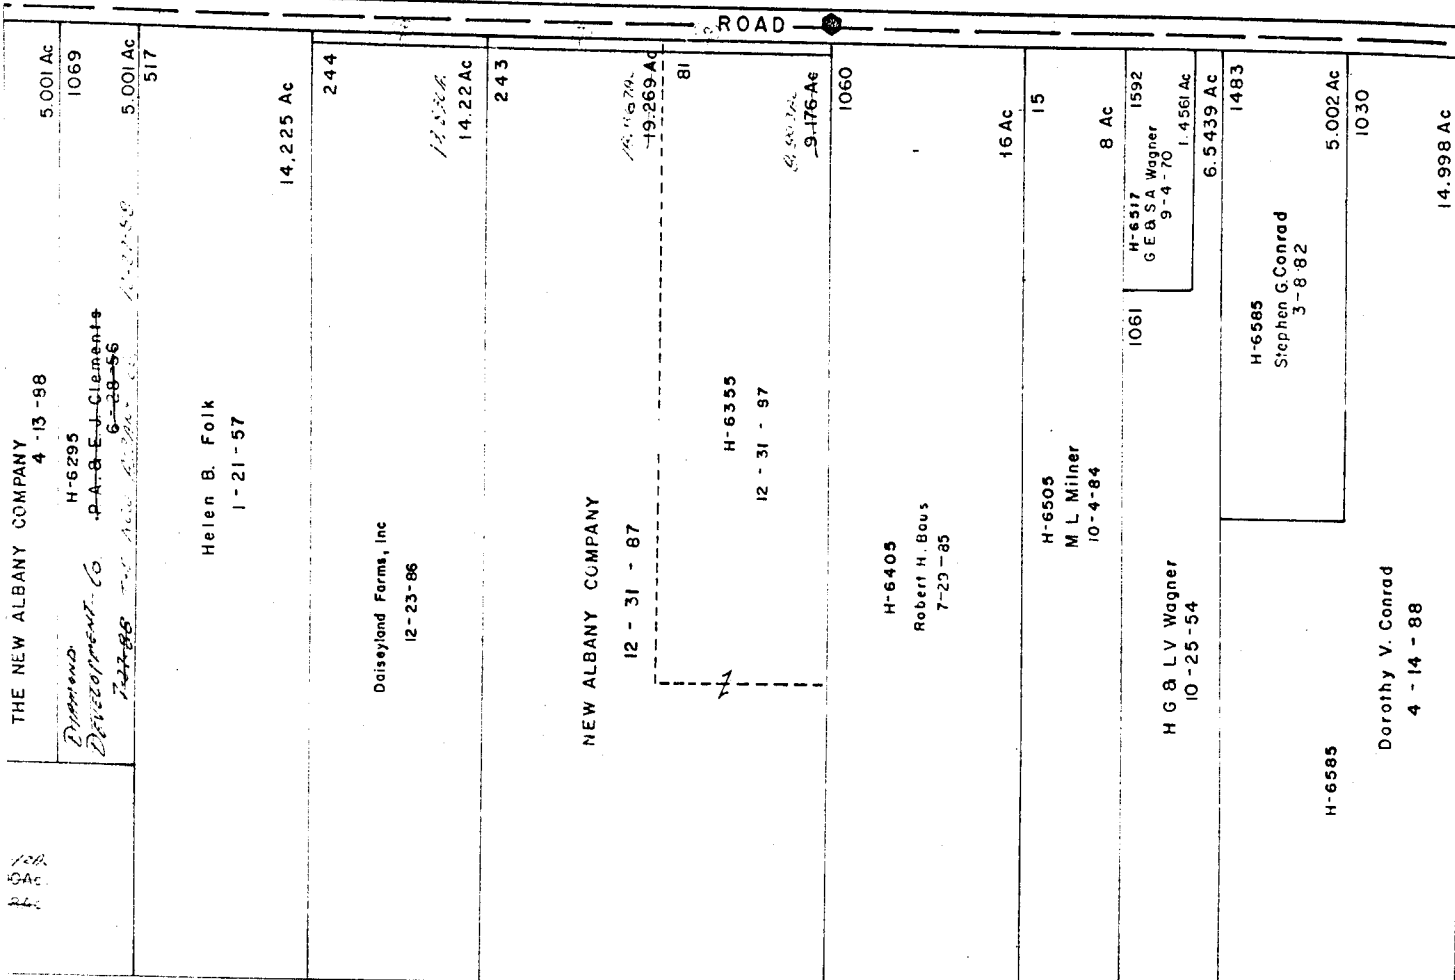

JEFFERSON TWP
R.16 TWP.1




SCALE 1"=200'
E = HIGHWAY EASEMENT
TAXING DISTRICT, DISTRICT CODE
JEFFERSON 170

H---HOUSE NUMBERS

FRANKLIN COUNTY SURVEY MONUMENT

0
38
A

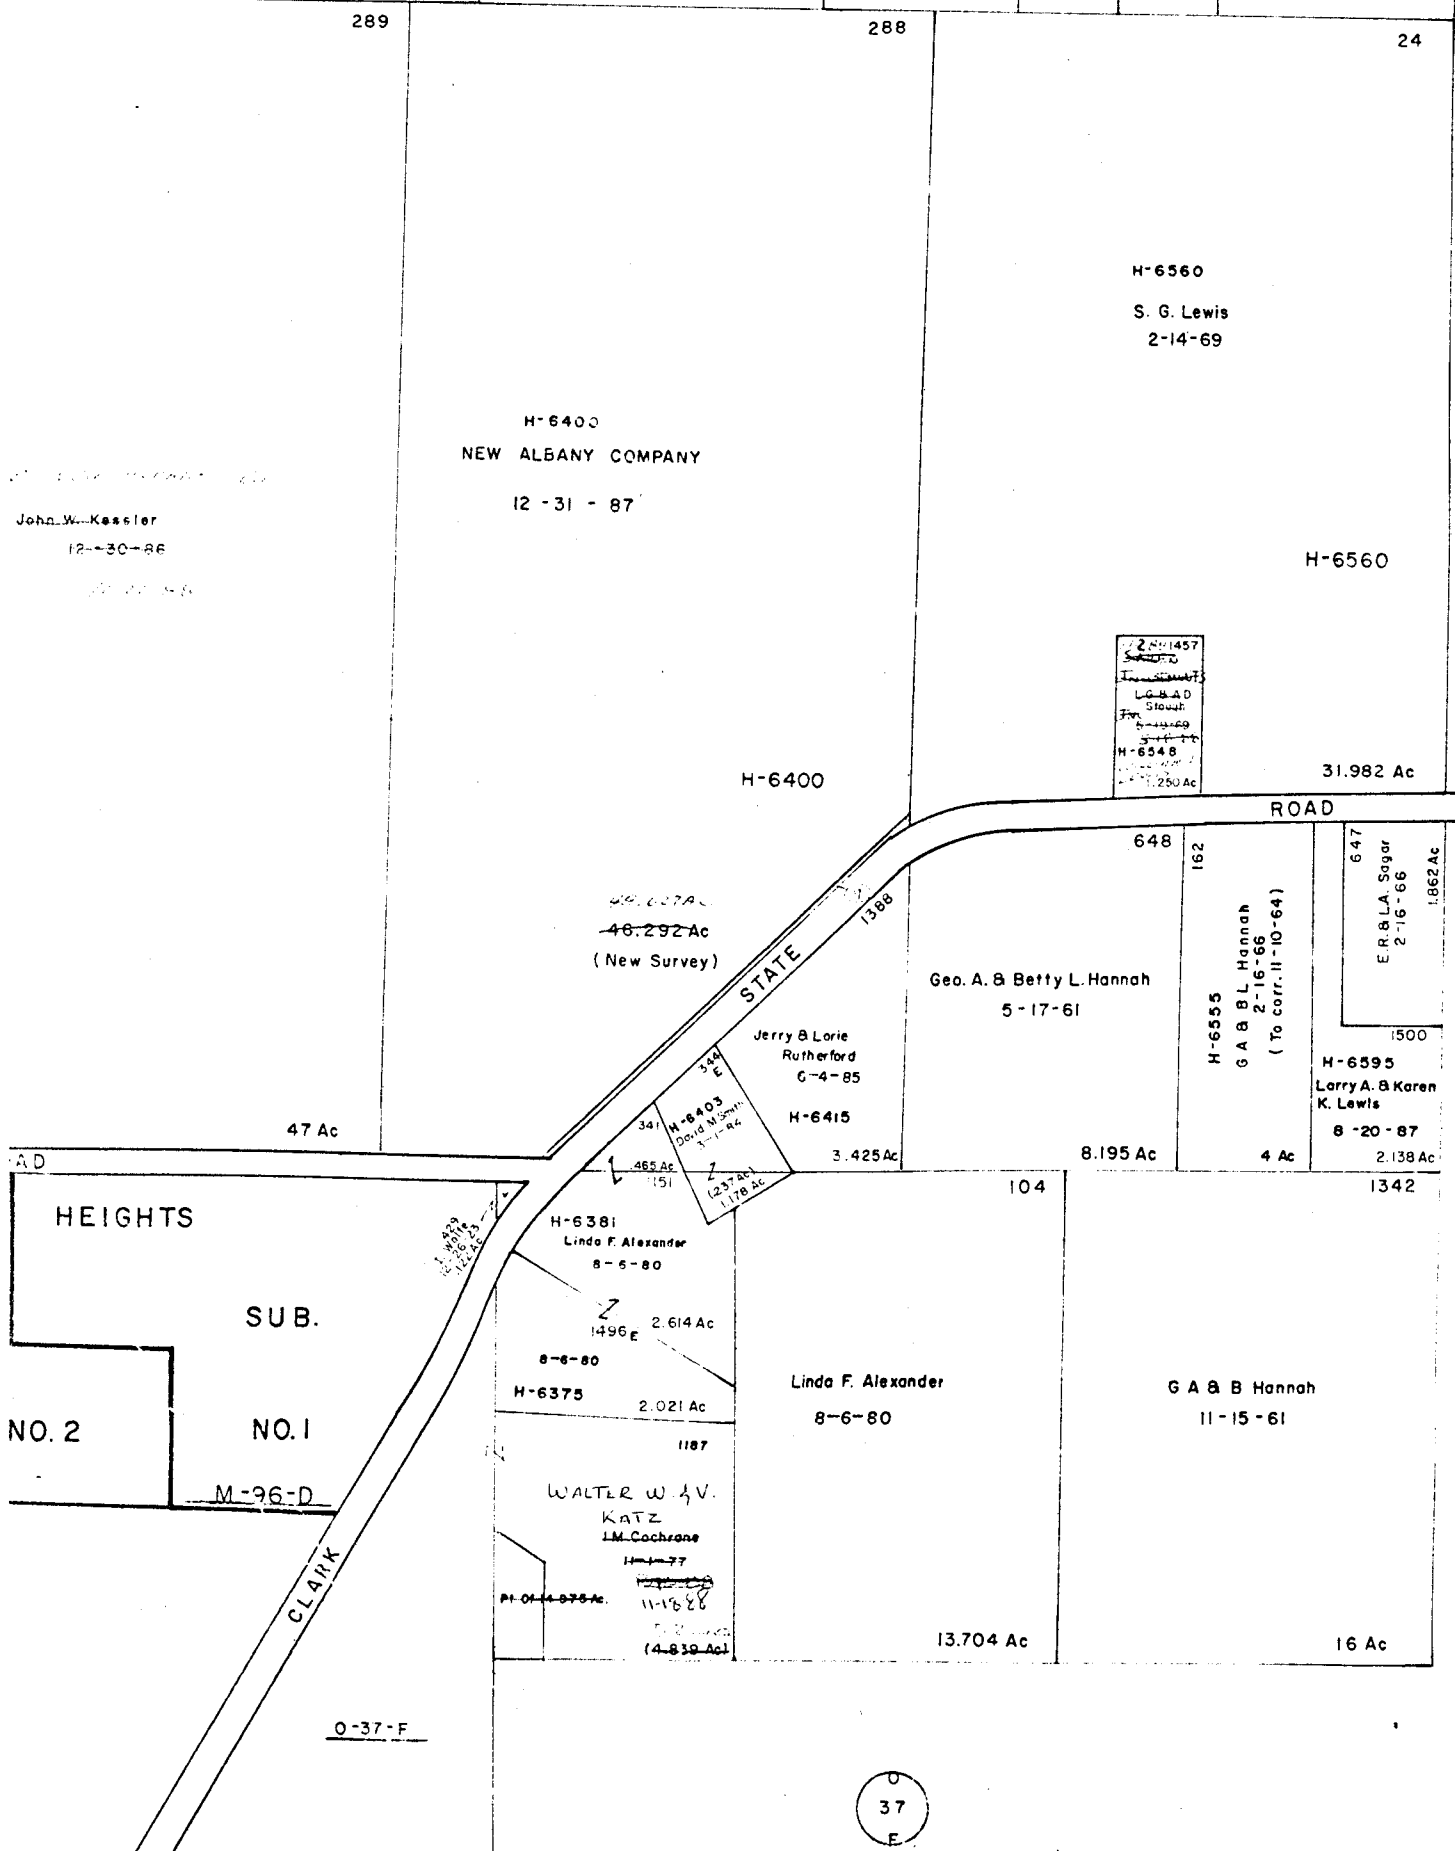

0
38
B

0
37
E

518

O-37-C