


O-38-F
JEFFERSON TWP.
R.16 TWP.1

SCALE 1"=200'
E=HIWAY EASEMENT
TAXING DISTRICT CODE
JEFFERSON 170

H--- HOUSE NUMBERS

LICKING COUNTY

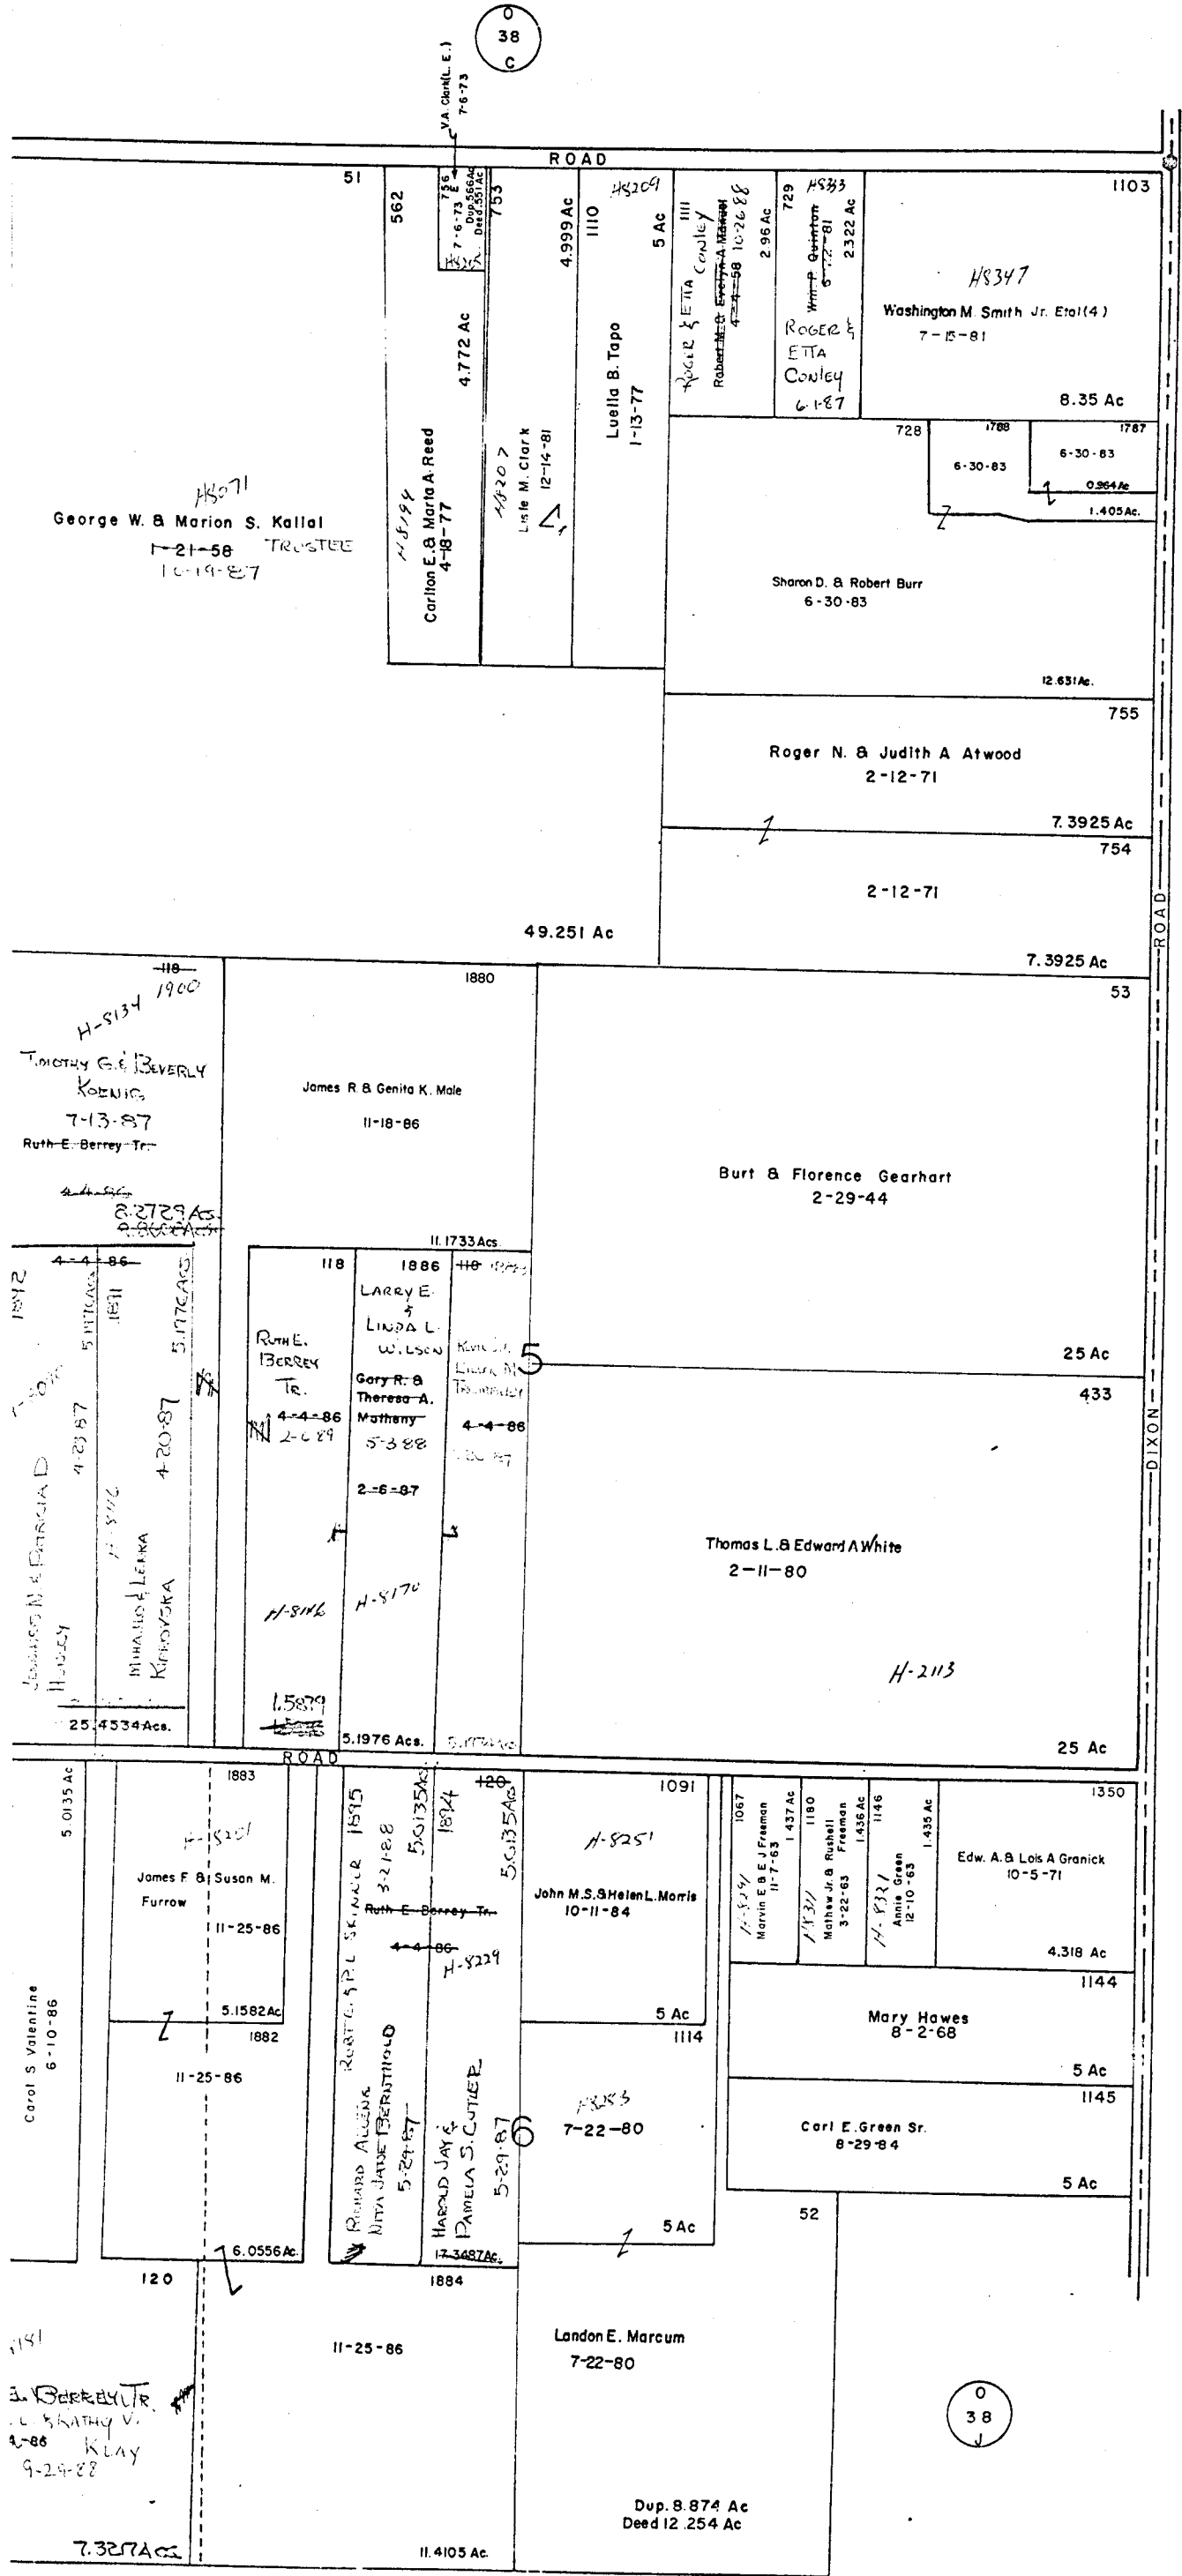

38

38