



0  
38  
E

0-38-H

JEFFERSON TWP

R.16


TWP 1



SCALE 1" = 200'  
E = HIWAY EASEMENT  
TAXING DISTRICT CODE  
JEFFERSON 170

H---HOUSE NUMBERS

② - FUTURE EASEMENT

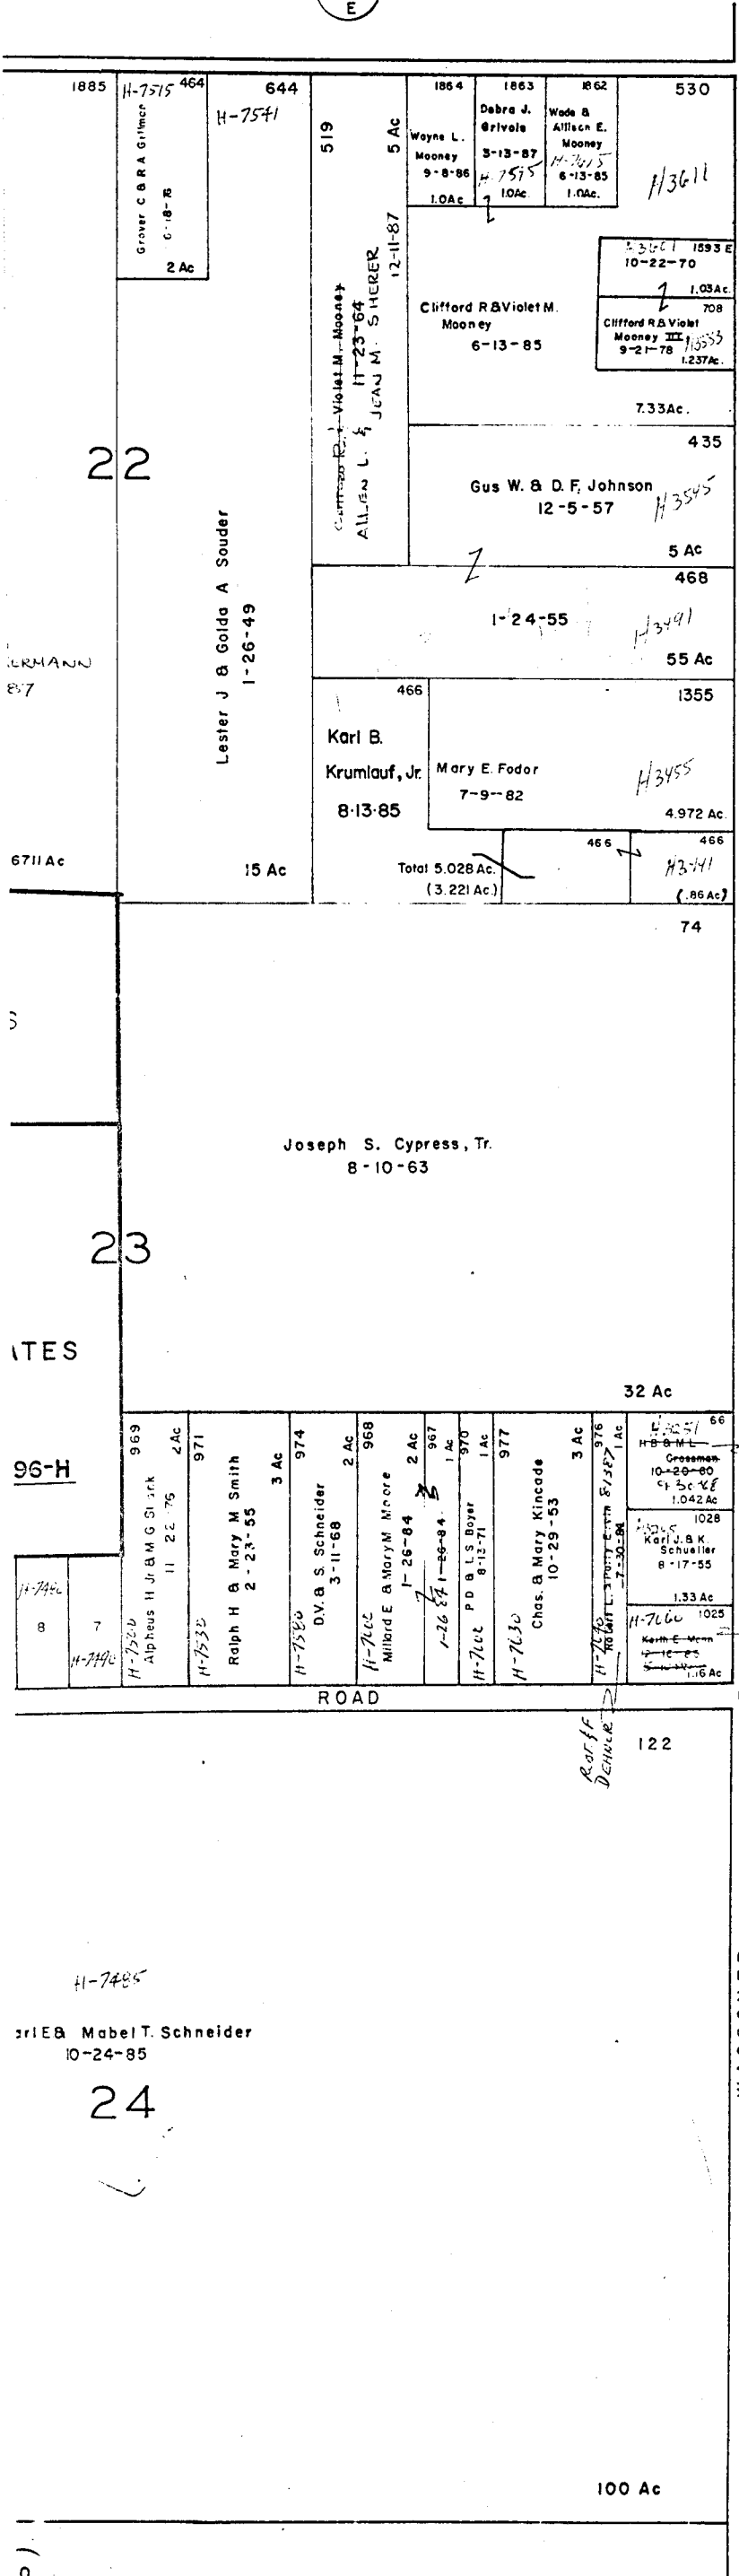

0  
38  
J

1	1477	Mary E W McDaniel	10-18-66	.742 Ac
2	1380	Nerol L & M Russell	12-27-67	.738 Ac
3	1488	Danny F & Anita Kay Byas	6-6-83	.739 Ac
4	1493	Henry F & Marsha D Wesemann	10-19-72	.739 Ac
5	1494	Jas. T & S L Kipmfoh	9-19-72	.749 Ac
6	1514	Stanley M. Jr & L. G. Ehrman	7-2-78	.821 Ac
7	1439	J A Watiker	2-2-66	.785 Ac
8	1459	Roger W B Mary Jo Freeman	5-3-67	.771 Ac
9	1490	Robt. P & Helen G Geizler	4-19-68	.757 Ac
10	1480	E J B M Fitzpatrick	8-30-66	.799 Ac
11	1490	Buddy & Pamela A. Churesh	12-13-84	0.799 Ac
12	1453	CT & P Horn	11-8-65	.799 Ac
13	1487	A O B E M J Smith	4-10-67	.771 Ac
14	1460	Alex L & Dyan L. Couden	11-7-86	.771 Ac
15	405	Robt P & S A Nobile	3-19-73	.879 Ac
16	115	Jas. H & R A Garvey	3-30-73	.879 Ac
17	1335	L. W. D. A. E M Nolze	4-13-61	.551 Ac
18	450	Thomas A & M J Trufant	11-1-77	.551 Ac
19	1454	Richard & Deborah McCluskey	1-26-84	.551 Ac
20	67	William P & Neva M P. eusants	8-6-58	0.763 Ac
21	1340	R. Jr. & N M Garner	9-14-61	.640 Ac
22	1389	Renold T & Pauline R Culler	1-16-87	.551 Ac
23	1475	D L & F C Clark	6-16-66	1.018 Ac

ROAD

WAGGONER

0  
38  
J

H-7485  
Mabel T. Schneider  
10-24-85

24

100 Ac

0-38-H

3/25/82

548