


C
39
E

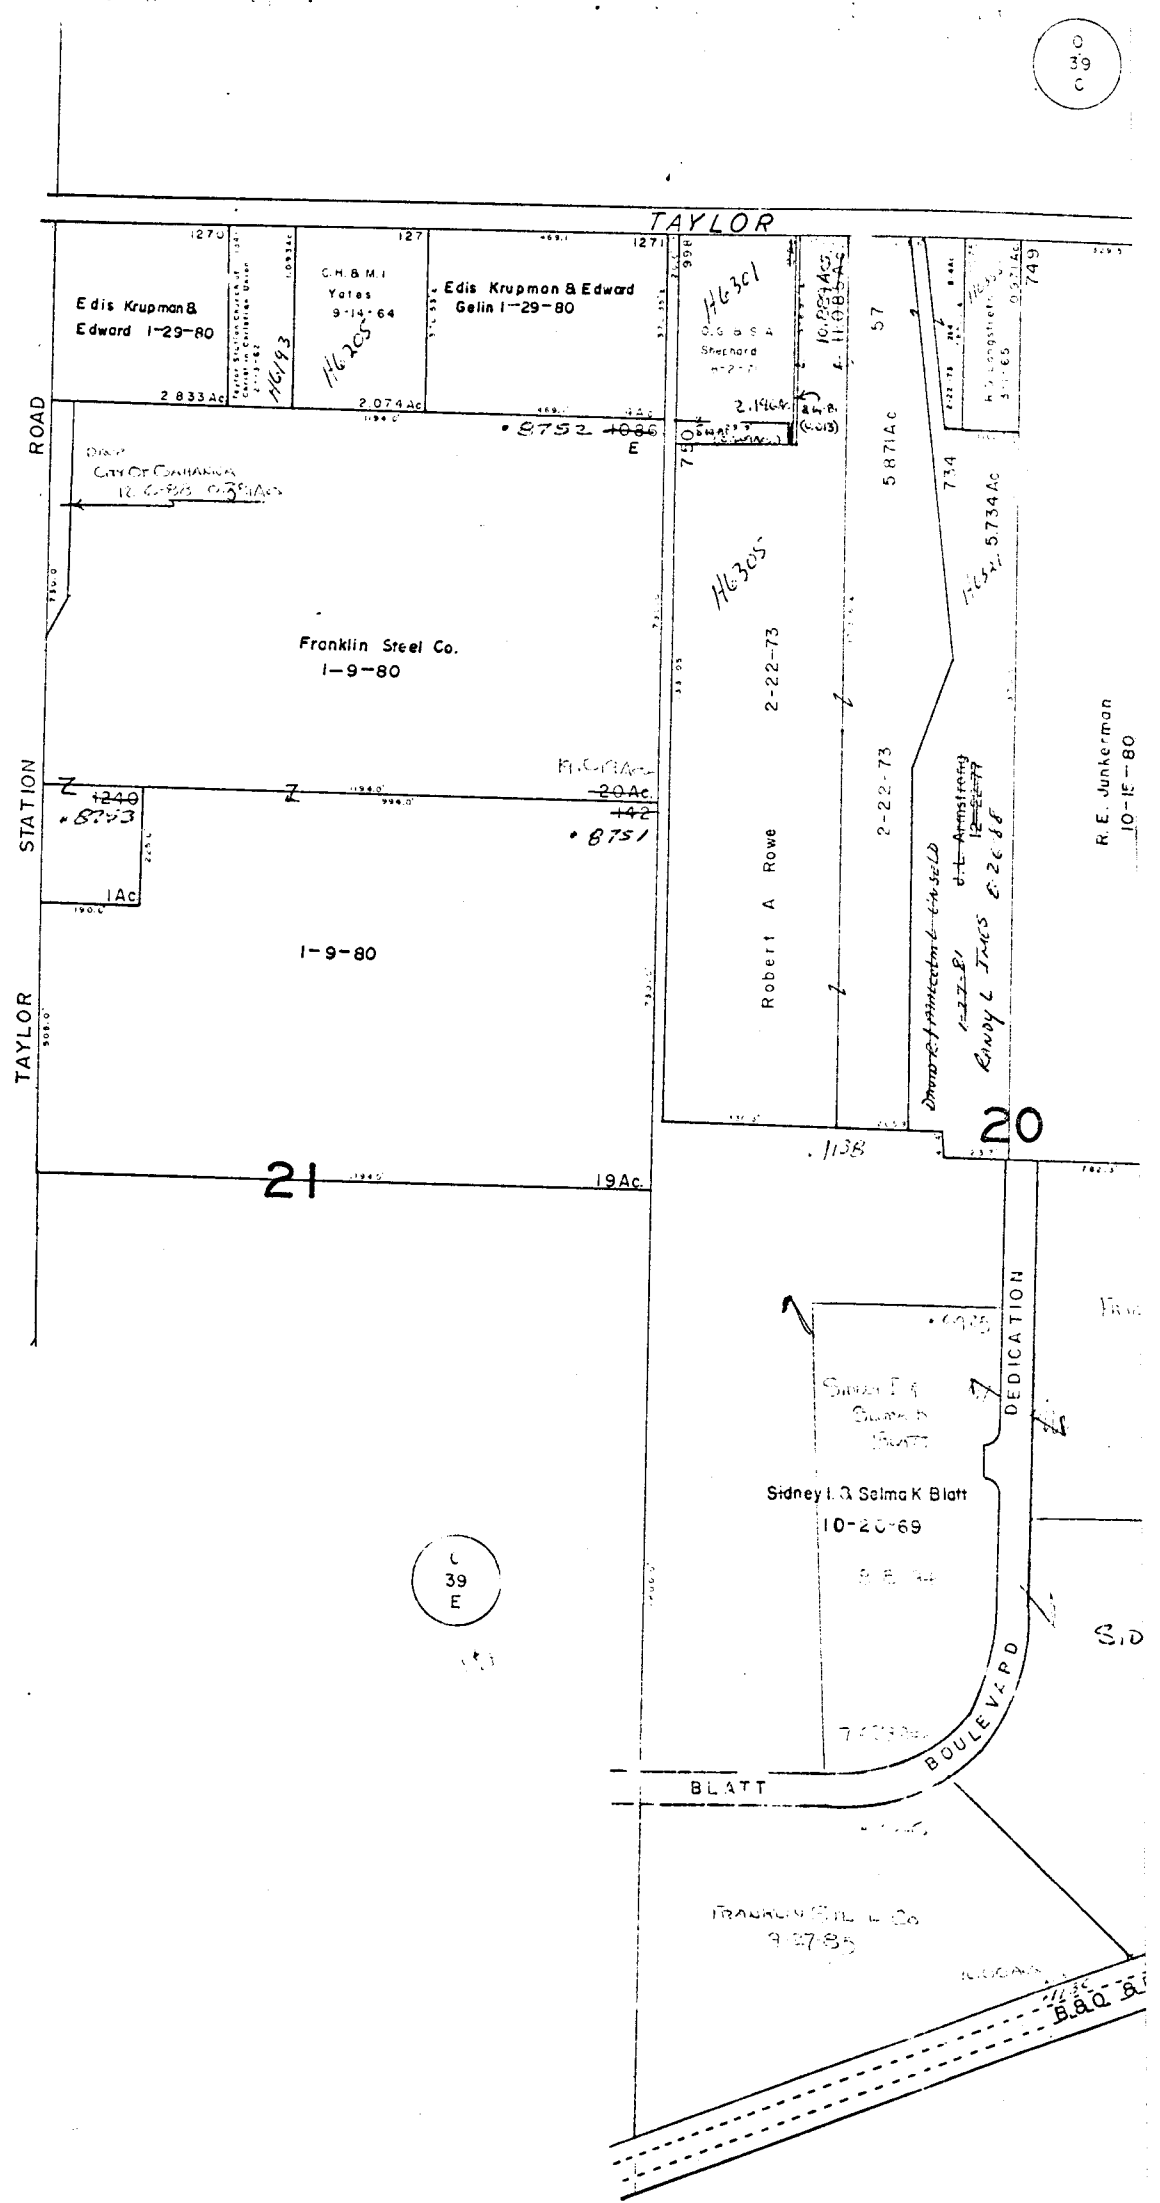

C
39
E

O-39-F


JEFFERSON TWP
R.16, TWP1



SCALE 1" = 200'
E=HIWAY EASEMENT
TAXING DISTRICT DISTRICT CODE
JEFFERSON 170
CITY OF GAHANNA 025

HOUSE NUMBERS

O
39
C

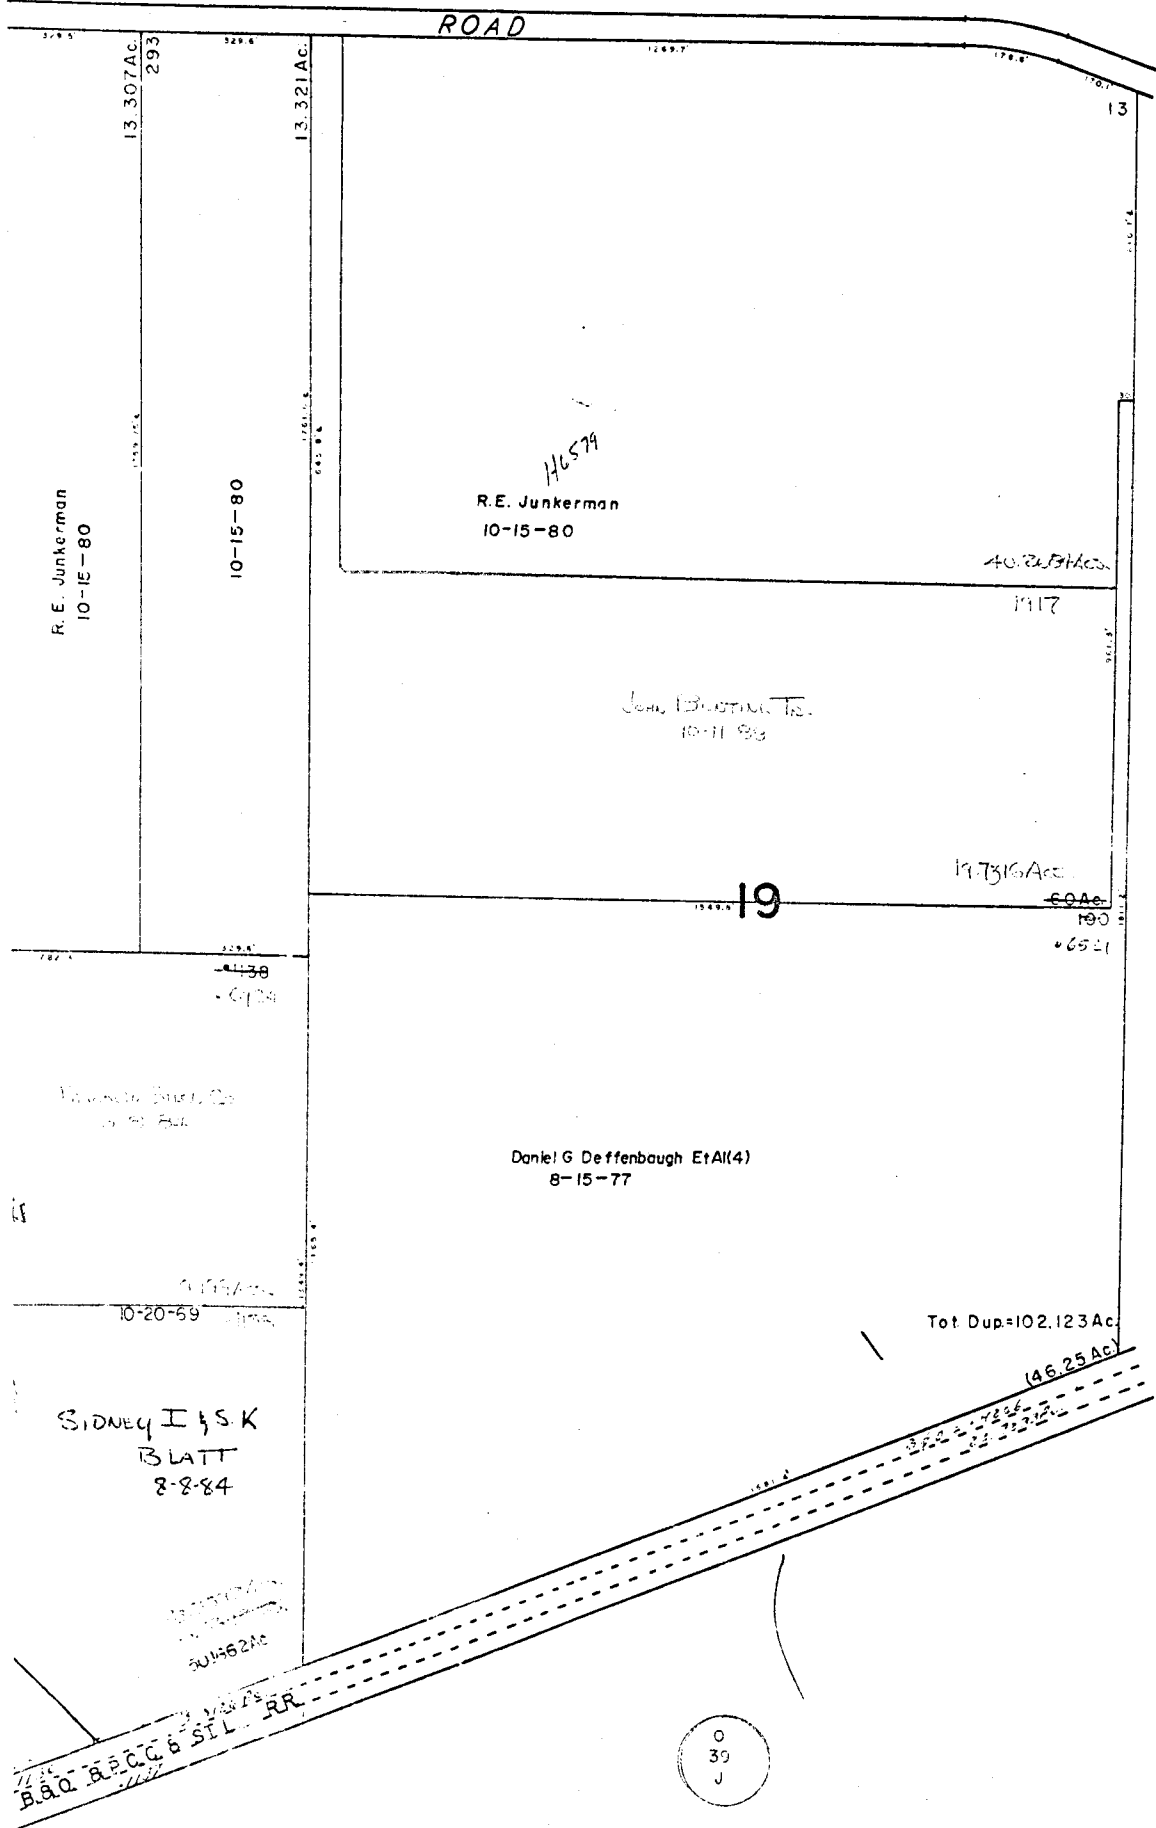

O
40
D

O
39
J

O-39-F

564

