


3

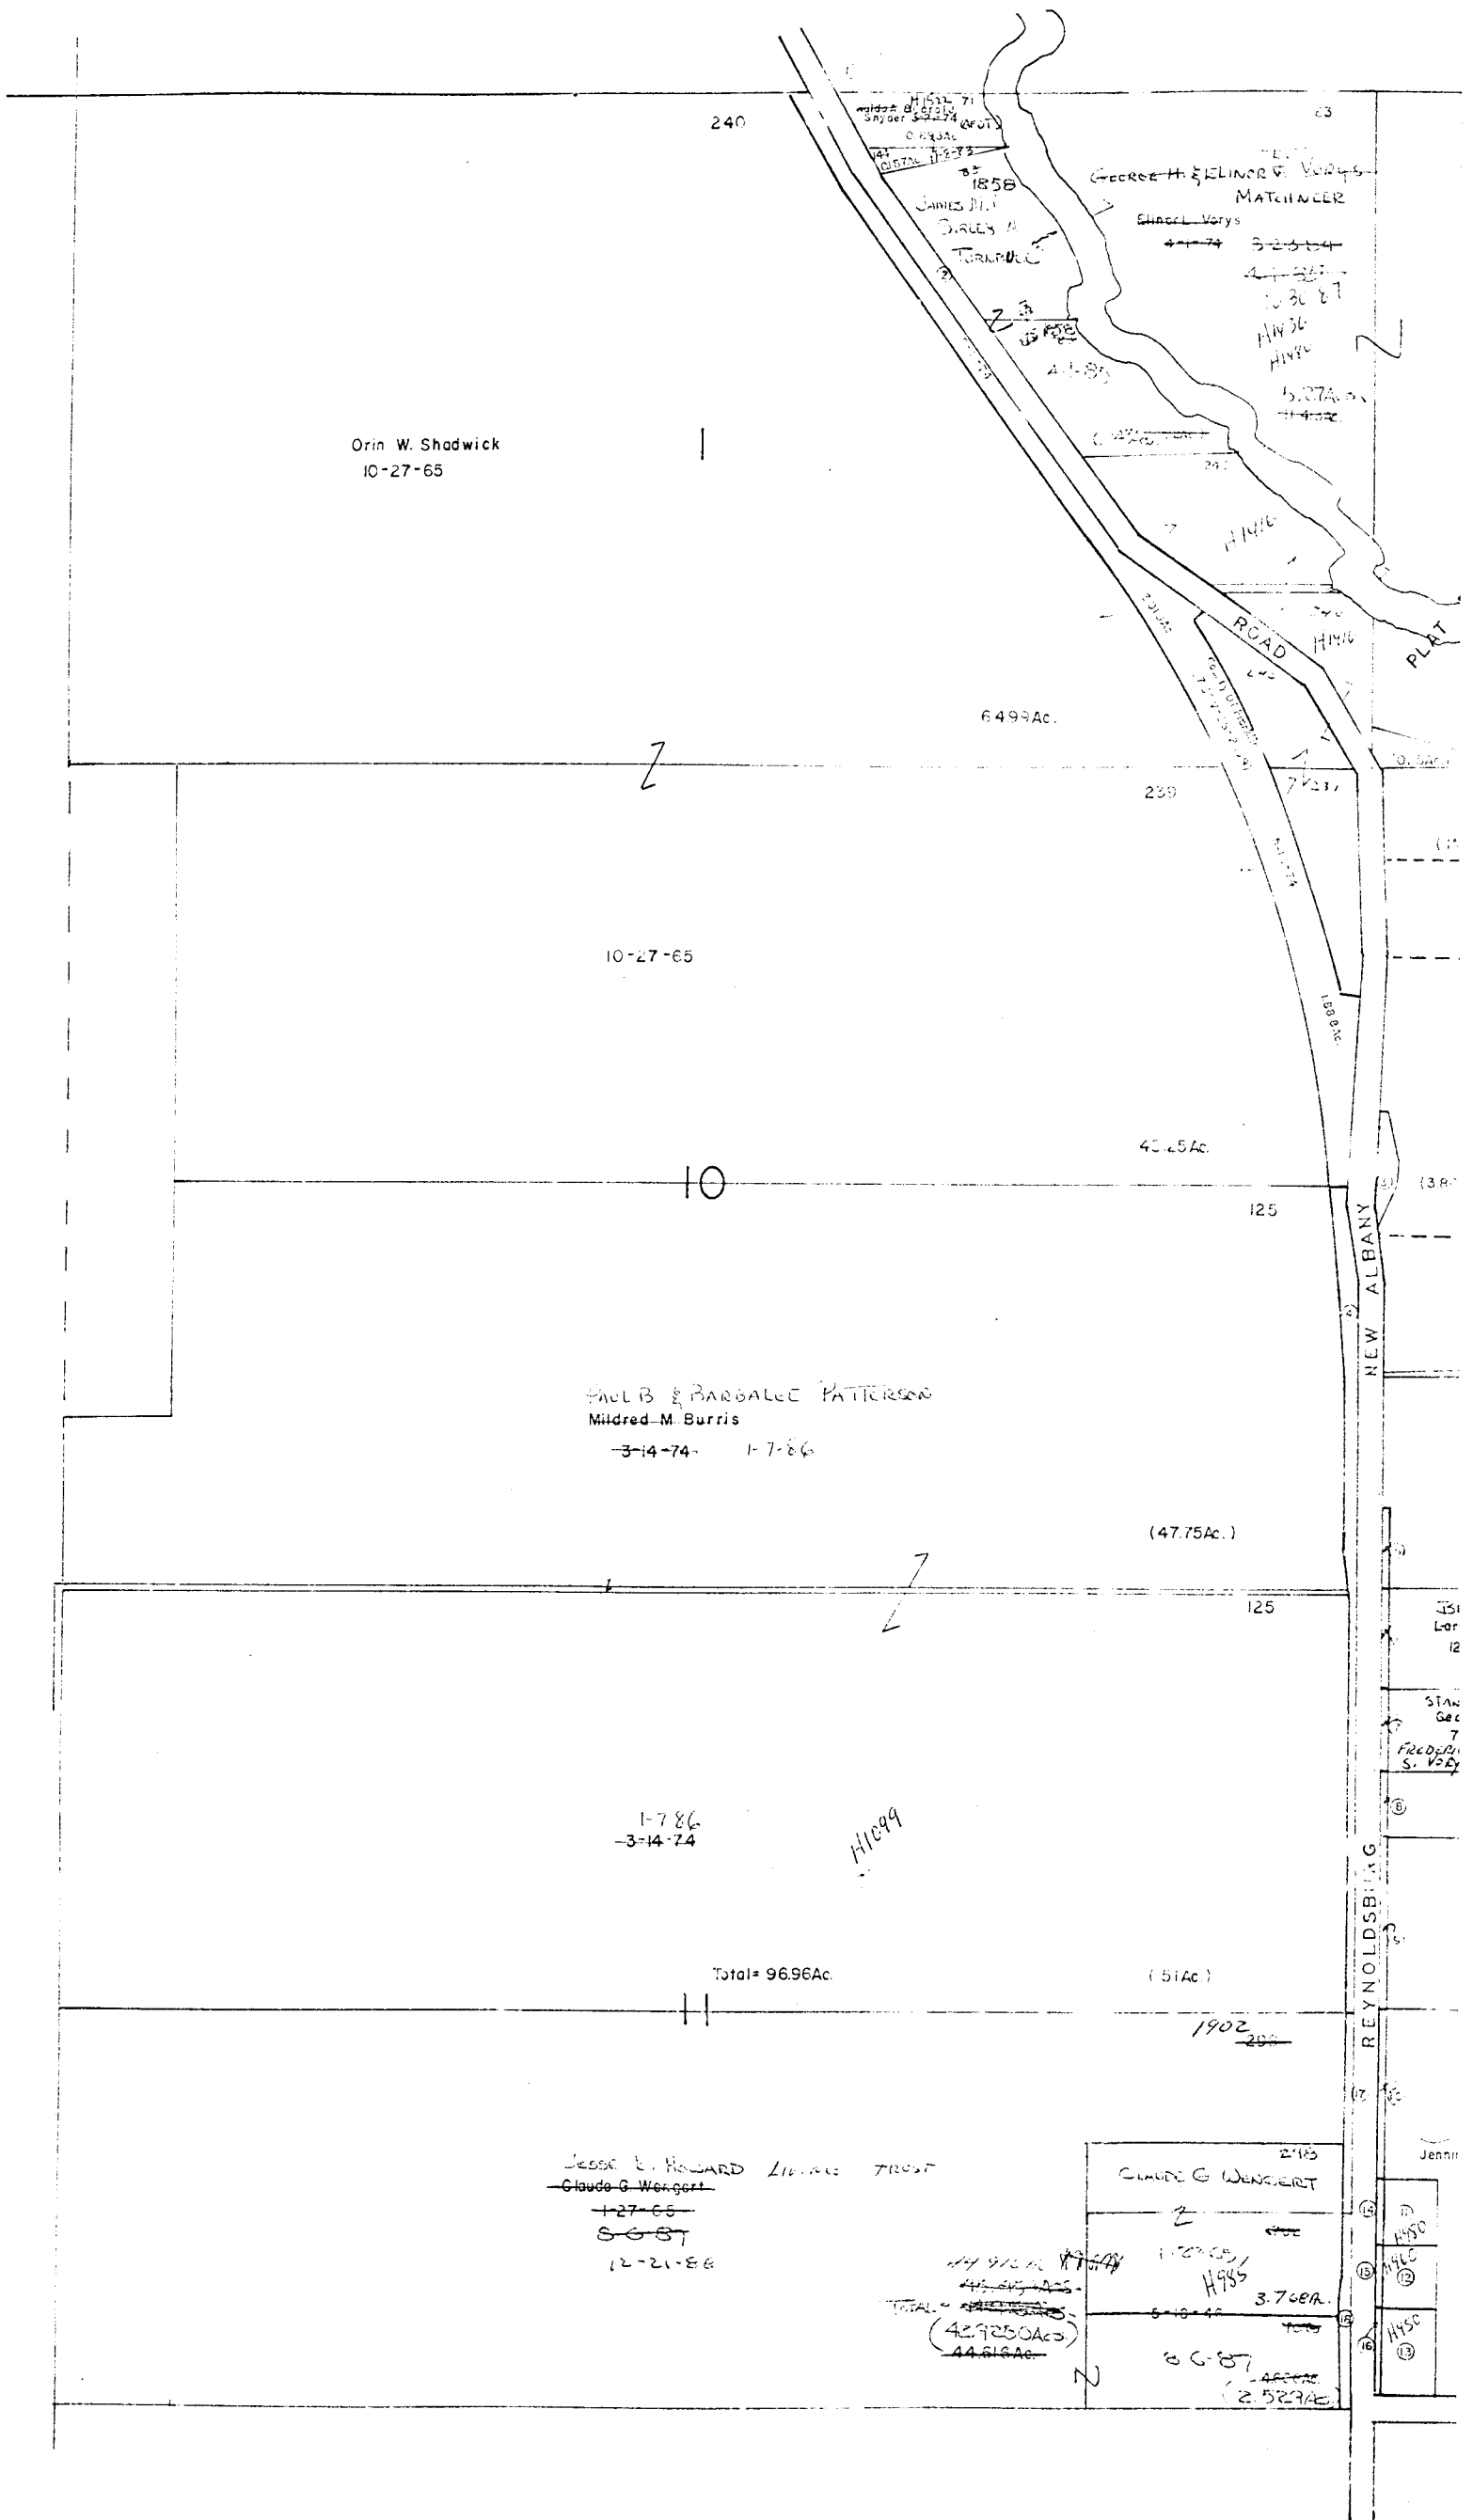

39

33

0
10
0


0-40-A

JEFFERSON TWP
R16. TWP 1



SCALE 1" = 200'
E = HIGHWAY EASEMENT
TAXING DISTRICT DISTRICT CODE
JEFFERSON 17C

HOUSE NUMBERS

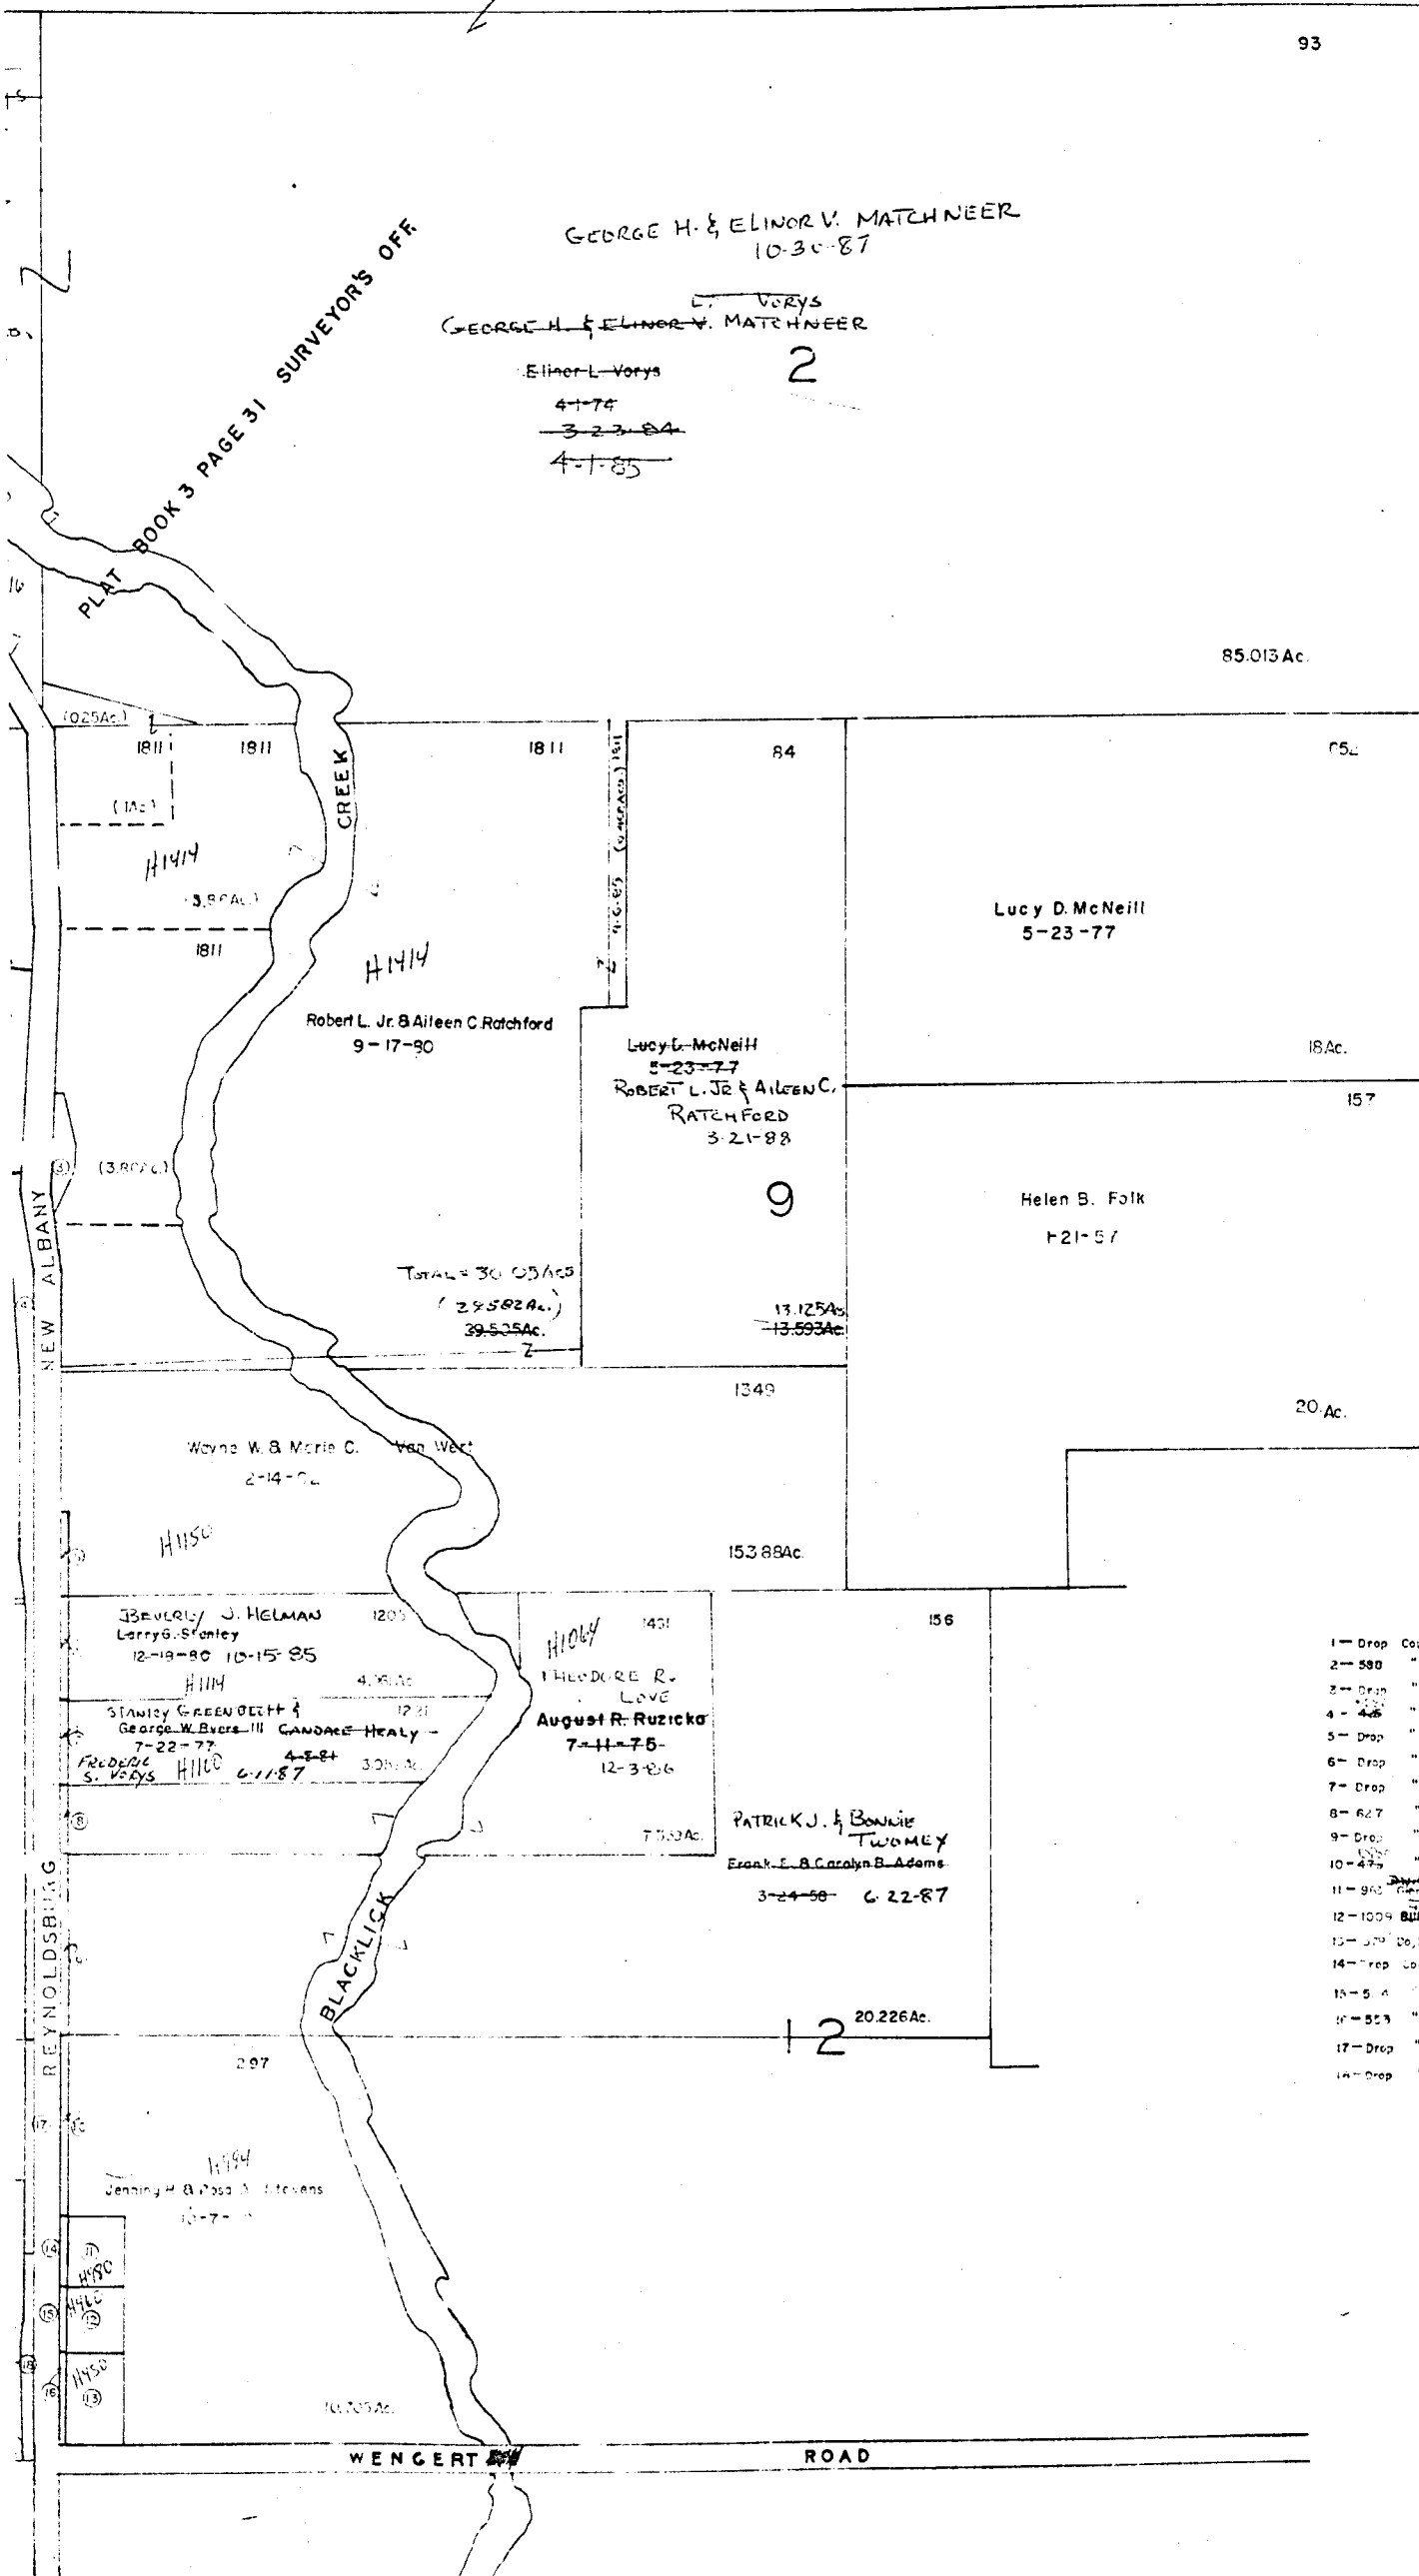

85.013 Ac.

Lucy D. McNeill
5-23-77

Robert L. Jr. & Aileen C. Ratchford
9-17-90

Lucy D. McNeill
5-23-77
ROBERT L. JR. & AILEEN C.
RATCHFORD
3-21-88

Helen B. Folk
1-21-57

TOTAL = 30.03 AC.
(29.582 AC.)
39.525 AC.

Wayne W. & Marie C. Van Wert
2-14-90

BEVERLY J. HELMAN
Larry G. Stanley
12-19-80 10-15-85

STANLEY GREEN DEETH &
George W. Byers III CANDACE HEALY
7-22-77 4-8-81 3-28-81

FREDERIC S. VORYS
6-11-87

THEODORE R.
LOVE
August R. Ruzicka
7-11-75
12-3-86

PATRICK J. & BONNIE
TWOMEY
Frank E. & Carolyn B. Adams
3-24-88 6-22-87

JENNIFER B. PESS & STEVENS
10-7-88

| Drop | County Of | Comm. | Ac. |
|------|-----------|-------------------------|-------------------|
| 1 | Drop | County Of Franklin | 5-14-74 0.107Ac |
| 2 | 580 | " | 4-25-73 0.40Ac. |
| 3 | Drop | " | 5-9-73 0.65Ac. |
| 4 | 46 | " | 5-14-73 1.79Ac. |
| 5 | Drop | " | 4-30-83 0.209Ac. |
| 6 | Drop | " | 5-13-74 0.154Ac. |
| 7 | Drop | " | " " 0.184Ac. |
| 8 | 627 | " | 4-25-73 0.10Ac. |
| 9 | Drop | " | 6-4-75 0.327Ac. |
| 10 | 479 | " | 4-21-73 0.327Ac. |
| 11 | 942 | DAVID P. & A. B. DAVIS | 10-12-88 |
| 12 | 1009 | BILL & D. MITRELLS | 4-29-77 0.173Ac. |
| 13 | 379 | Doyle & Ruth L. Wengert | 12-21-75 0.107Ac. |
| 14 | Drop | County Of Franklin | 7-24-73 0.107Ac. |
| 15 | 5 | " | 4-1-73 0.107Ac. |
| 16 | 523 | " | 4-9-73 0.184Ac. |
| 17 | Drop | " | 6-1-75 0.304Ac. |
| 18 | Drop | " | " " 0.394Ac. |

0-40-A